


NOV. 14, 1919=K.
MAY 11, 1920=L.

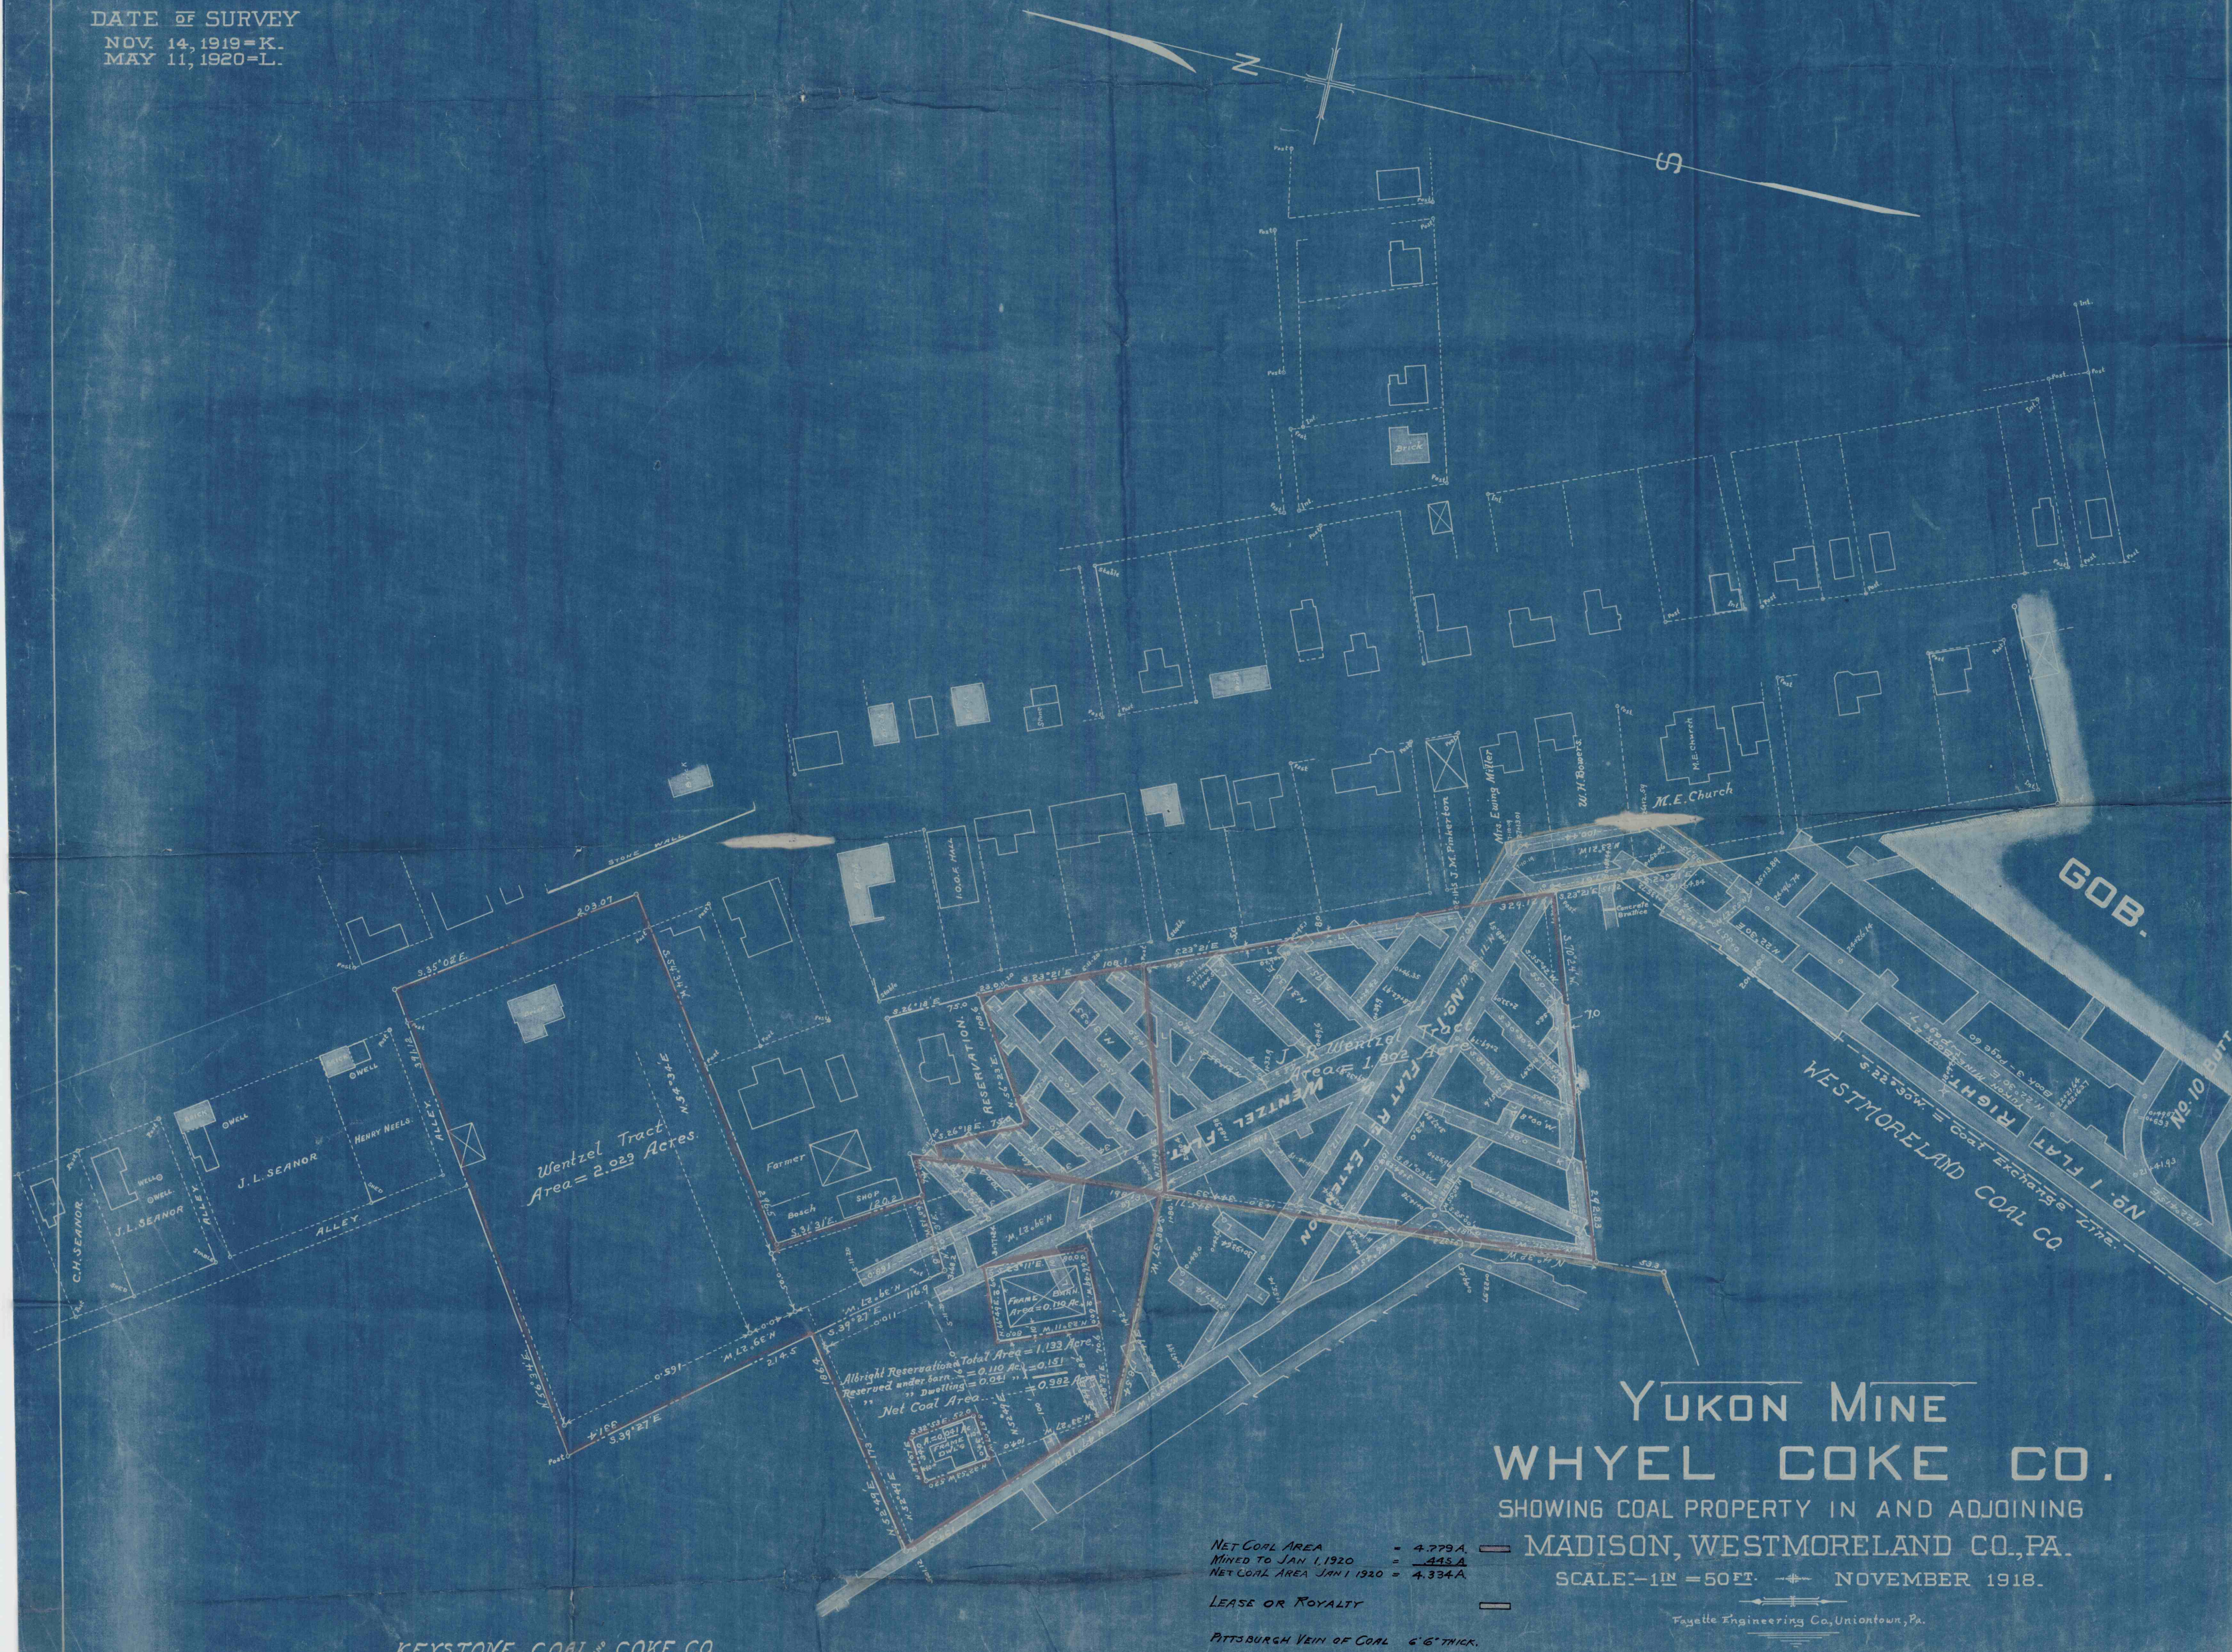

KEYSTONE COAL AND COKE CO.

NET COAL AREA = 4.779 A.
MINED TO JAN 1, 1920 = .445 A
NET COAL AREA JAN 1 1920 = 4.334 A.

LEASE OR ROYALTY

PITTSBURGH VEIN OF COAL 6'6" THICK.

YUKON MINE
WHYEL COKE CO.

SHOWING COAL PROPERTY IN AND ADJOINING
— MADISON, WESTMORELAND CO., PA.

SCALE:—1IN = 50 FT. NOVEMBER 1918.