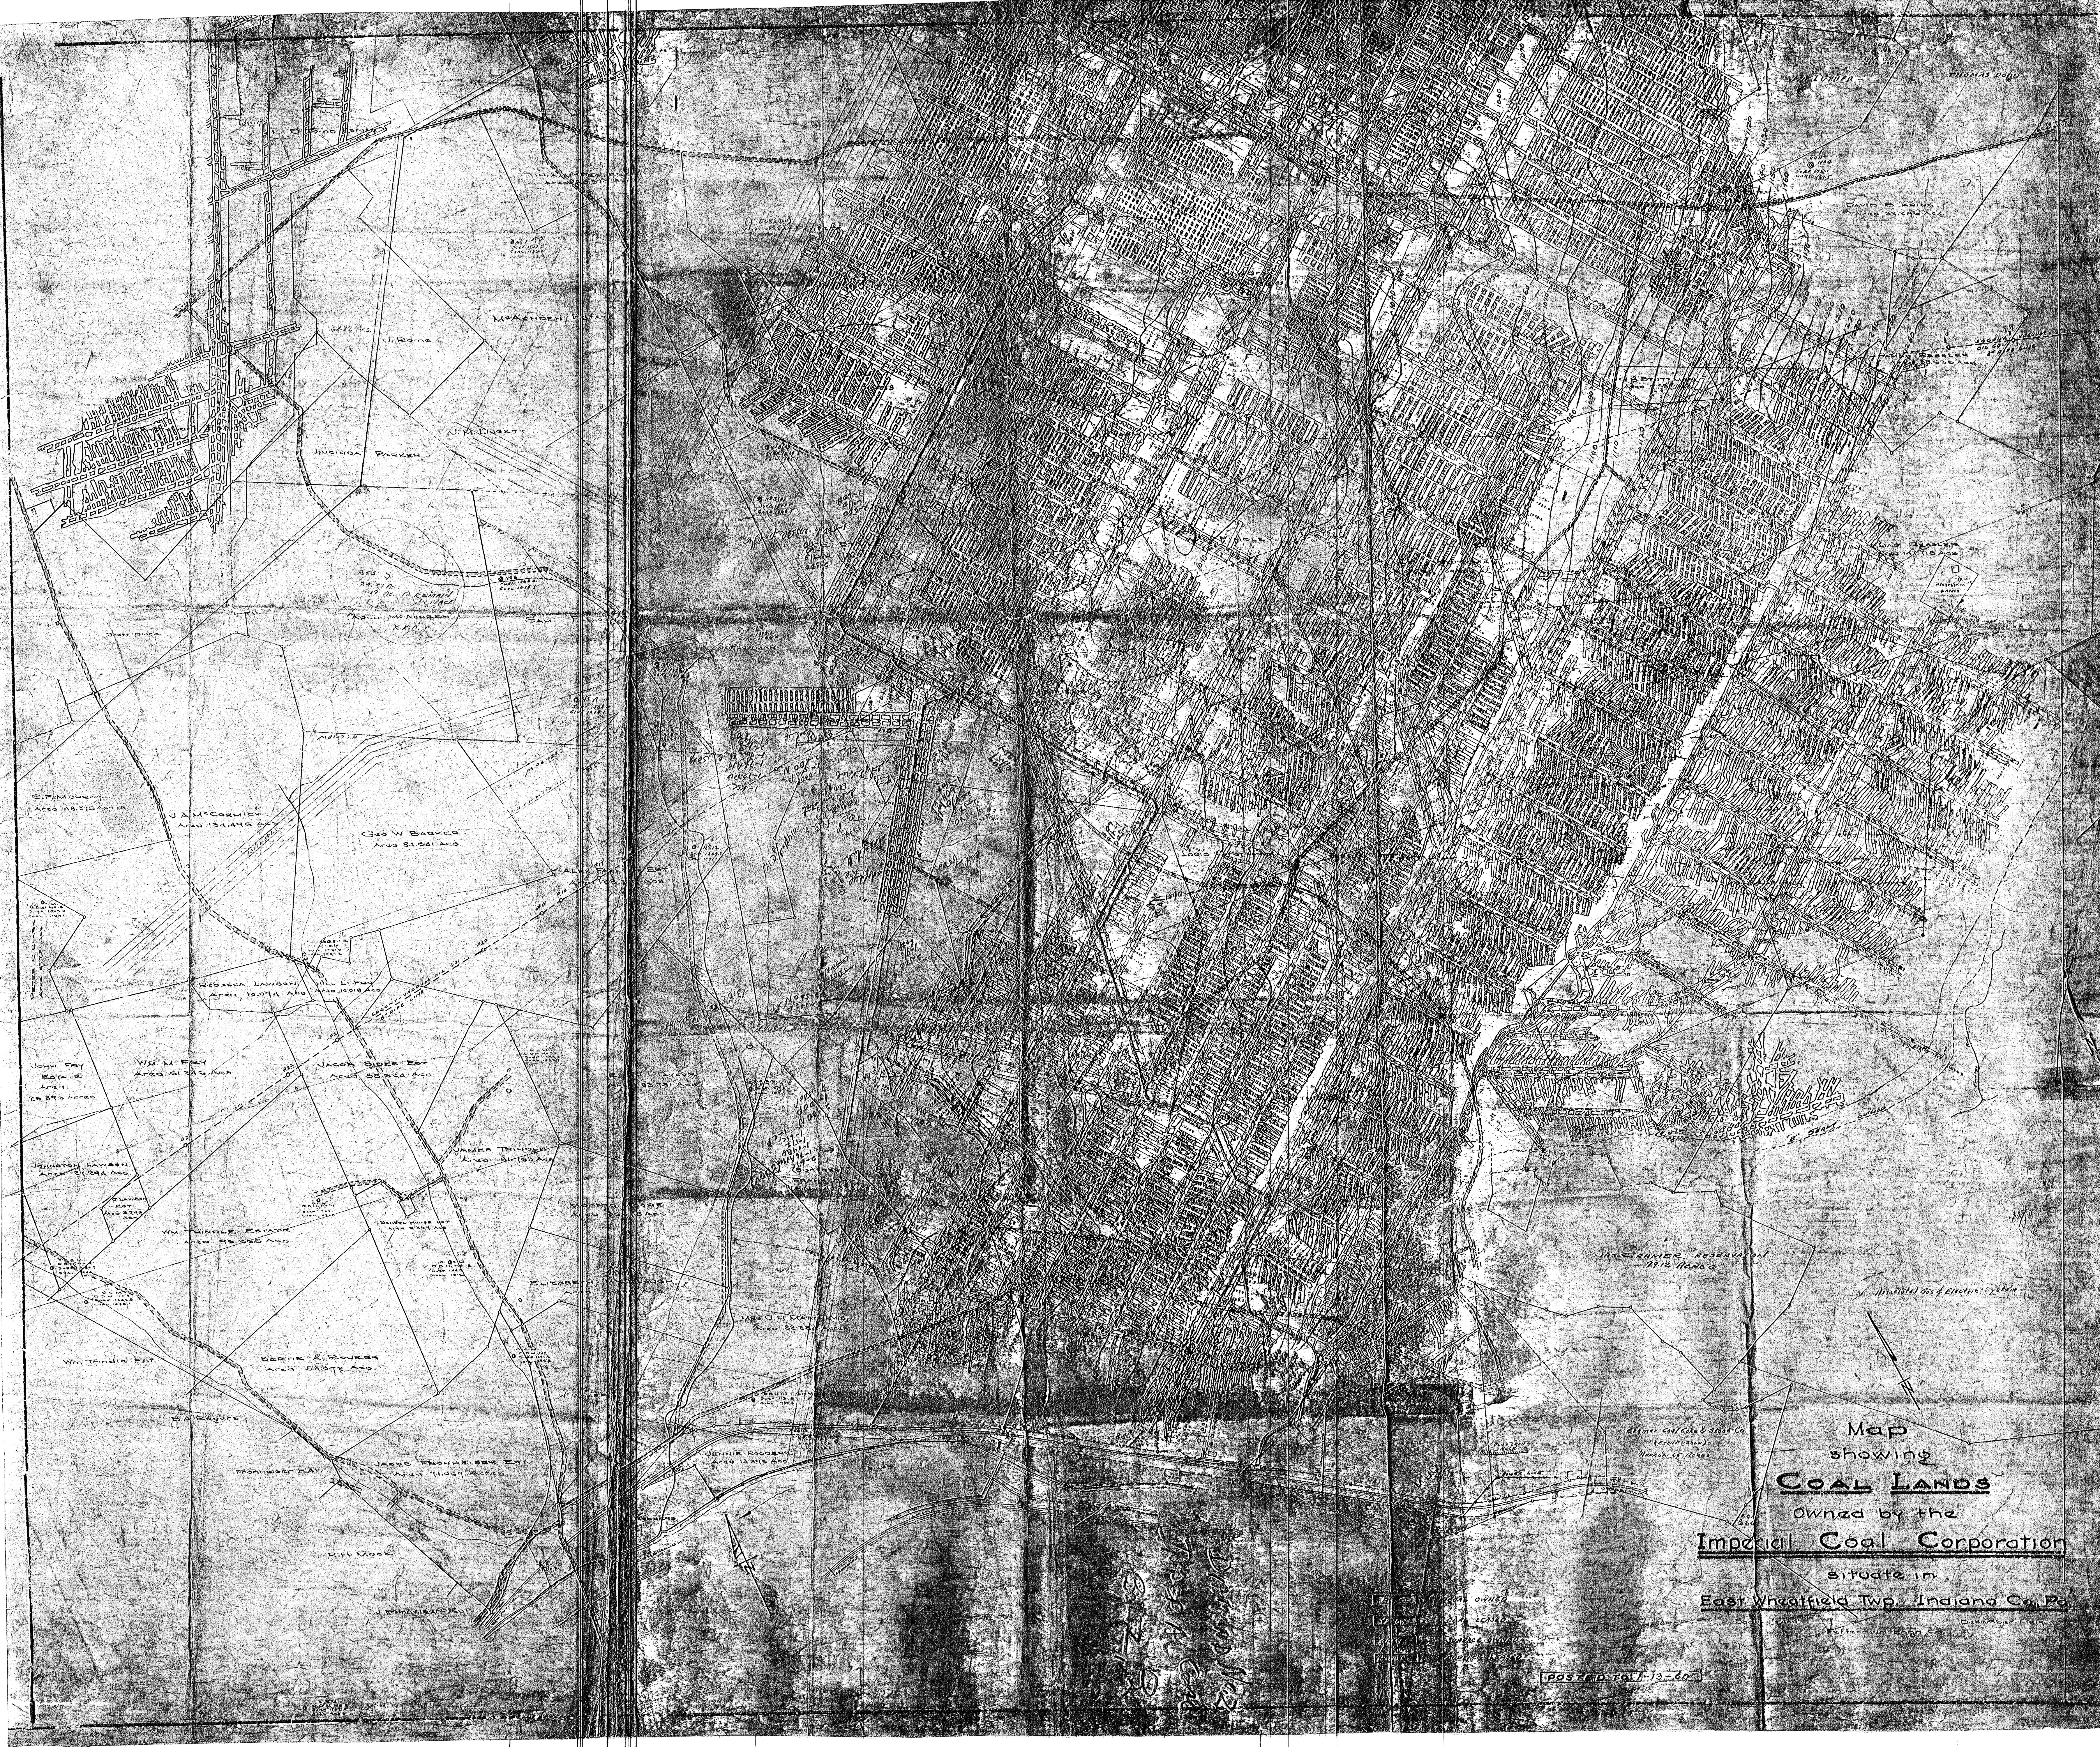

J. Rorne
68.32 Acs.
McAchren Estate
J. M. Liggett
Lucinda Parker
Arch McAchren
K.K.C.
Sam Fallock
Scott Black
C. F. Murray
Area 48.275 Acres
J. A. McCormick
Area 134.496 Acs
Geo W. Barker
Area 81.541 Acs
Rebecca Lawson
Area 10.094 Acs
Hill L. Fry
Area 10.018 Acs
Socony-Vacuum Oil Co.
8" Pipe Line
John Fry
Estate
Area
76.895 Acres
Wm. M. Fry
Area 61.246 Acs
Jacob Sides Est
Area 55.524 Acs
James Trindle
Johnston Lawson
Area 27.294 Acs
G. Lawson
Est
Area 3.292
Acs
Wm. Trindle Estate
Area 96.368 Acs
School House Lot
Wm Trindle Est
Bertie A. Rodgers
Area 50.072 Acs.
B. A. Rogers
Jacob Fronheiser Est
Area 71.059 Acres
Fronheiser Est.
J. Fronheiser Est.
R. H. Mock
Mrs. G. H. Matthews
Jennie Rodgers
Area 13.396 Acs
Cremer Coal/Coke & Stone Co.
(Stone Sold)
Approx 65 Acres
Power Line
Flat Iron Rock
Coal Owned
Coal Leased
Surface Owned
Surface Leased

Map
showing
COAL LANDS
Owned by the
Imperial Coal Corporation
situate in
East Wheatfield Twp. Indiana Co. Pa.

Scale 1"=400'
December 1919
Fetterman Engr. Co.

POSTED TO: 1-13-60