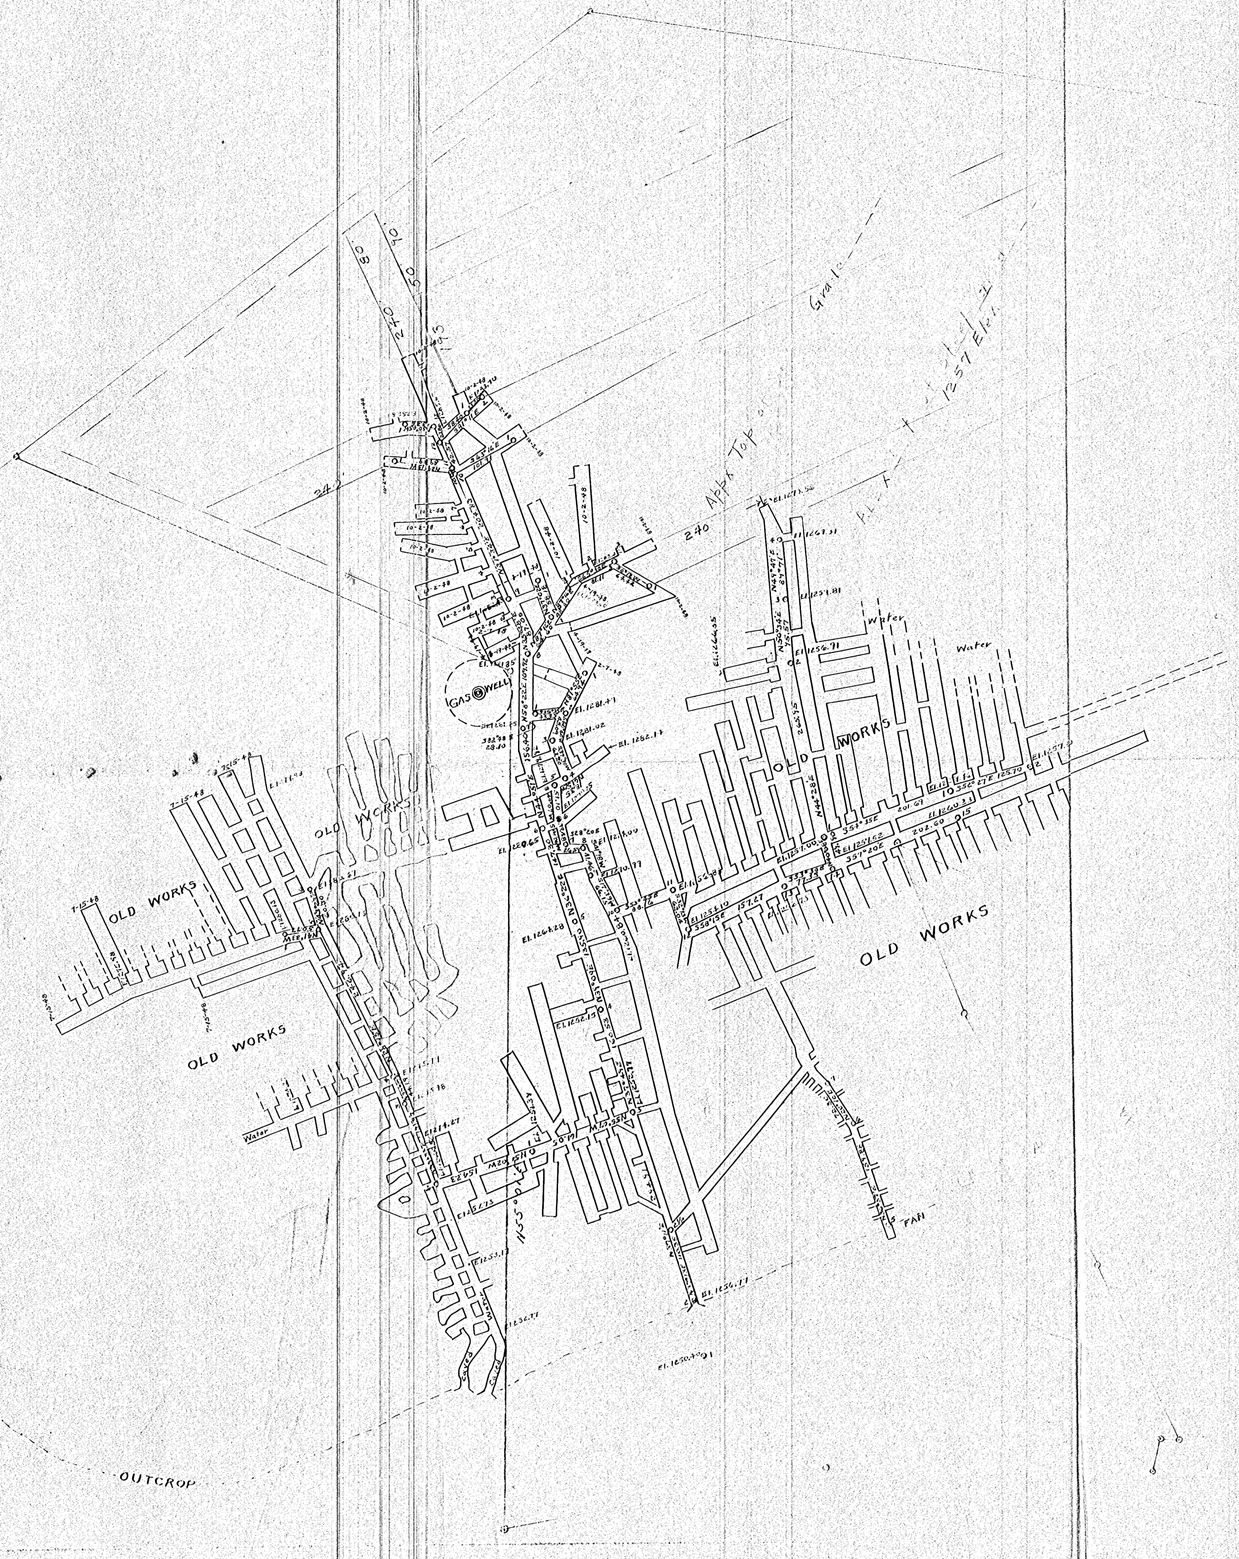


SLOAN MINE NO. 2

SITUATED IN

KISKIMINETAS TWP. ARMSTRONG CO. PA.

SCALE 1 IN = 100 FT. MAY 17, 1948

ROBERT G. GOSSER REGISTERED PA. No. 9789

LEECHBURG, PA.