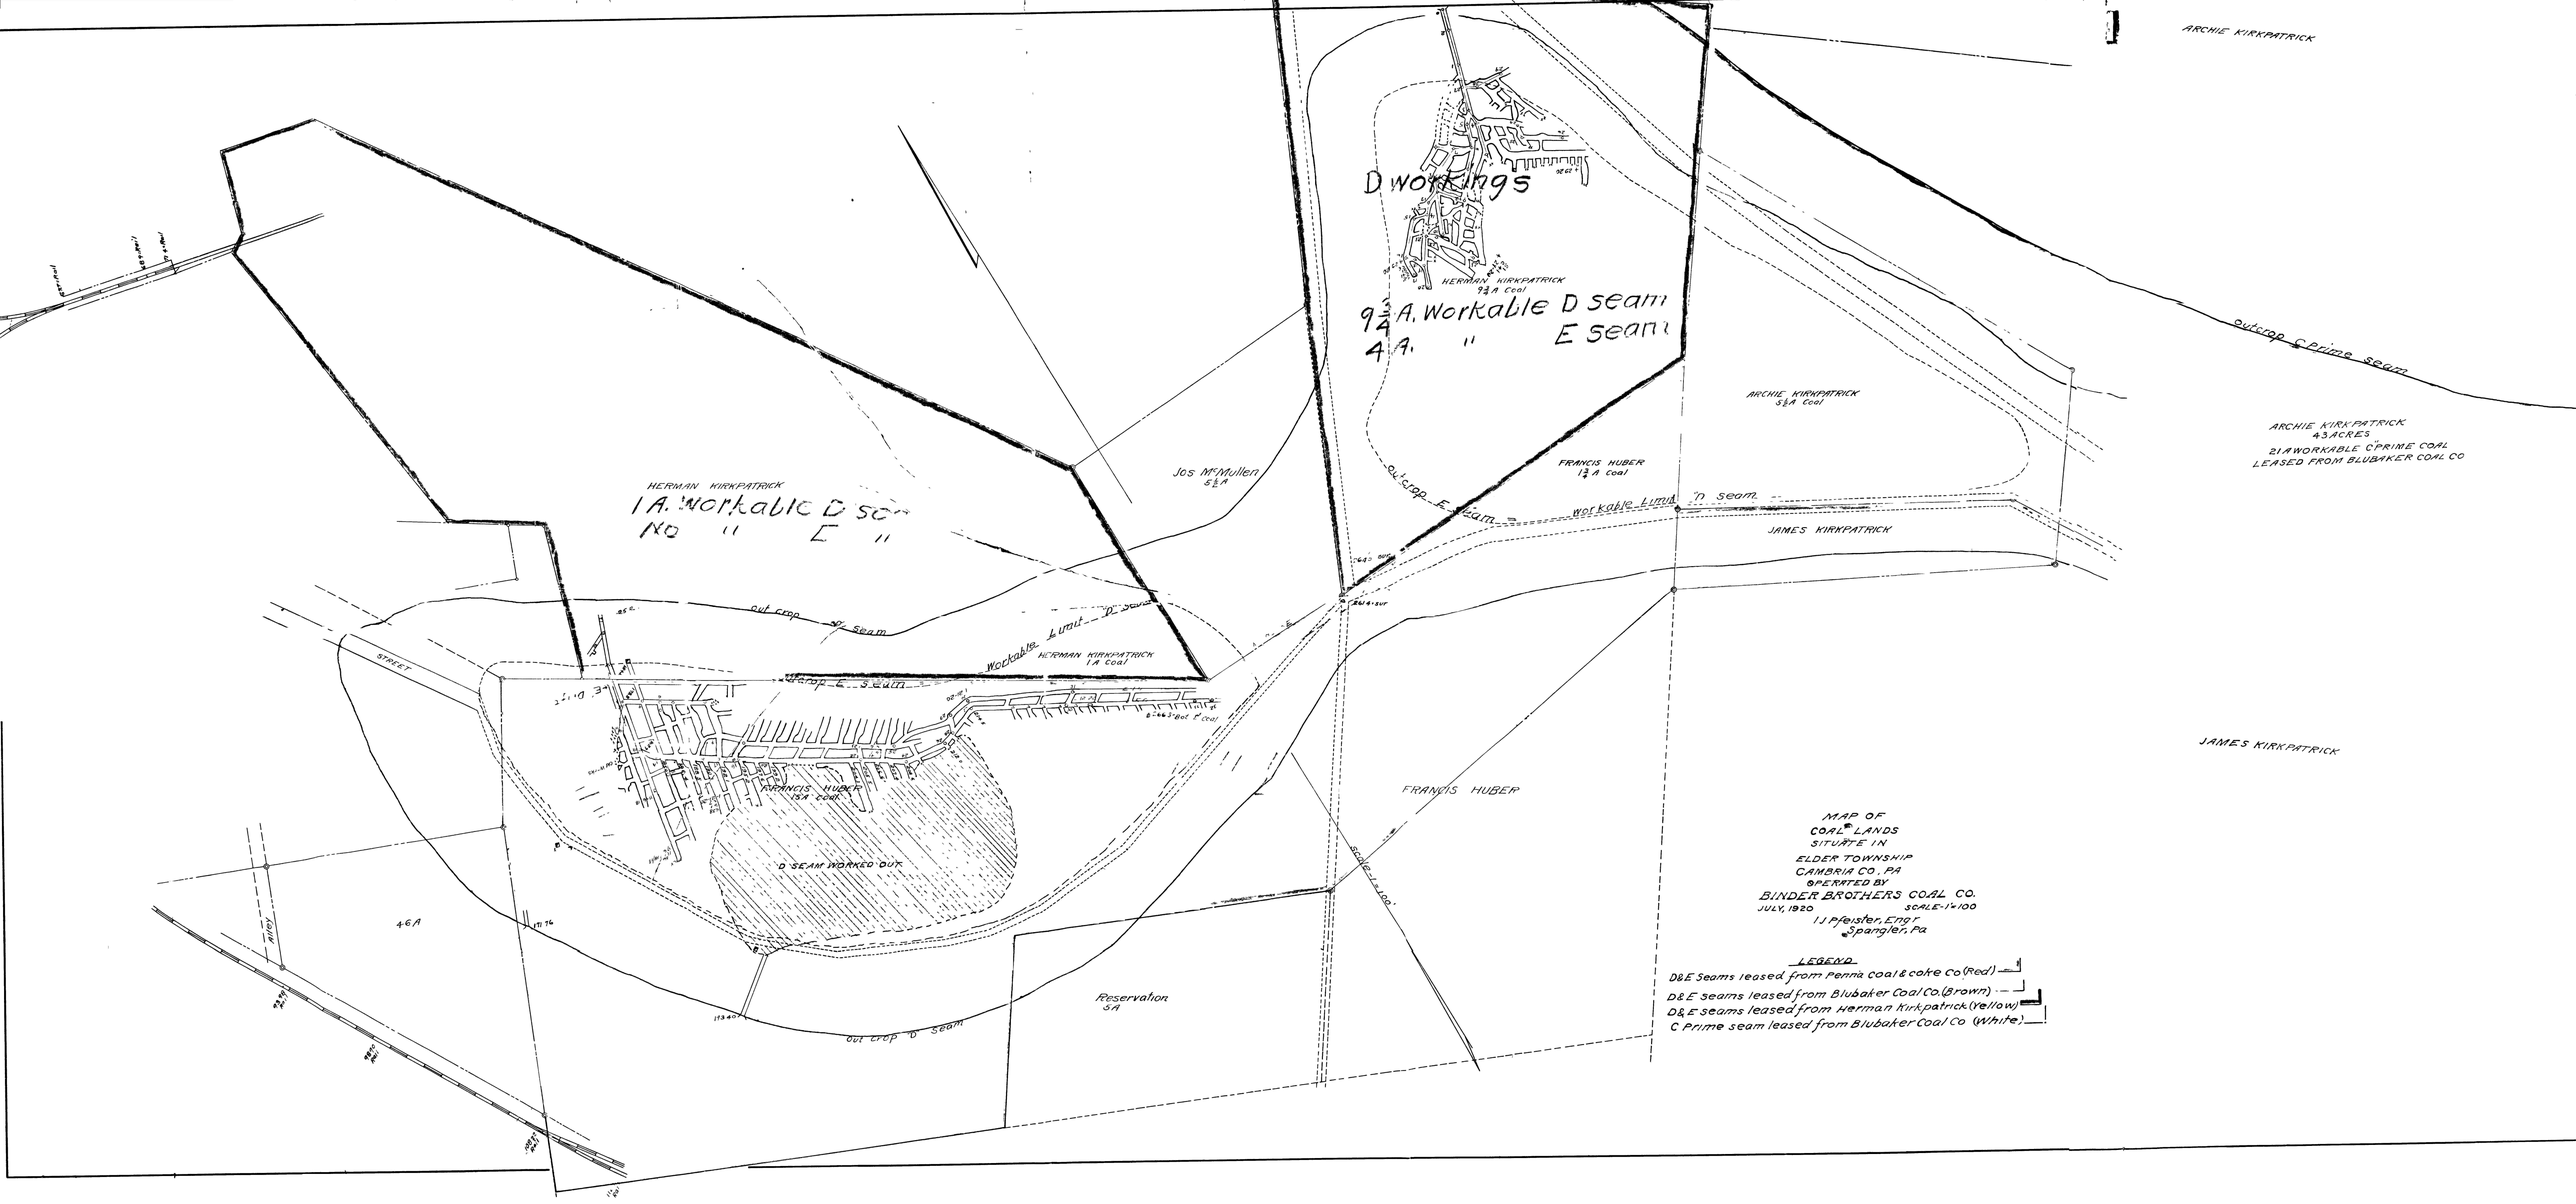
ARCHIE KIRKPATRICK
D workings
HERMAN KIRKPATRICK
9¾ A Coal
9¾ A. Workable D seam
4 A. " E seam
outcrop C Prime seam
ARCHIE KIRKPATRICK
5¾ A Coal
ARCHIE KIRKPATRICK
43 ACRES
21 A WORKABLE C PRIME COAL
LEASED FROM BLUBAKER COAL CO
FRANCIS HUBER
13¾ A Coal
outcrop E seam
workable Limit D seam
JAMES KIRKPATRICK
Jos McMullen
5¼ A
HERMAN KIRKPATRICK
1 A. Workable D seam
NO " E "
out crop D Seam
Workable Limit D seam
HERMAN KIRKPATRICK
1 A Coal
outcrop E seam
STREET
FRANCIS HUBER
13¾ A Coal
D SEAM WORKED OUT
FRANCIS HUBER
JAMES KIRKPATRICK
4.6 A
ALLEY
Reservation
5 A
out crop D Seam
MAP OF
COAL LANDS
SITUATE IN
ELDER TOWNSHIP
CAMBRIA CO. PA
OPERATED BY
BINDER BROTHERS COAL CO.
JULY, 1920
SCALE-1"=100
I.J. Pfeister, Engr.
Spangler, Pa
LEGEND
D&E Seams leased from Penna Coal & coke Co (Red)
D&E seams leased from Blubaker Coal Co. (Brown)
D&E seams leased from Herman Kirkpatrick (Yellow)
C Prime seam leased from Blubaker Coal Co (White)