


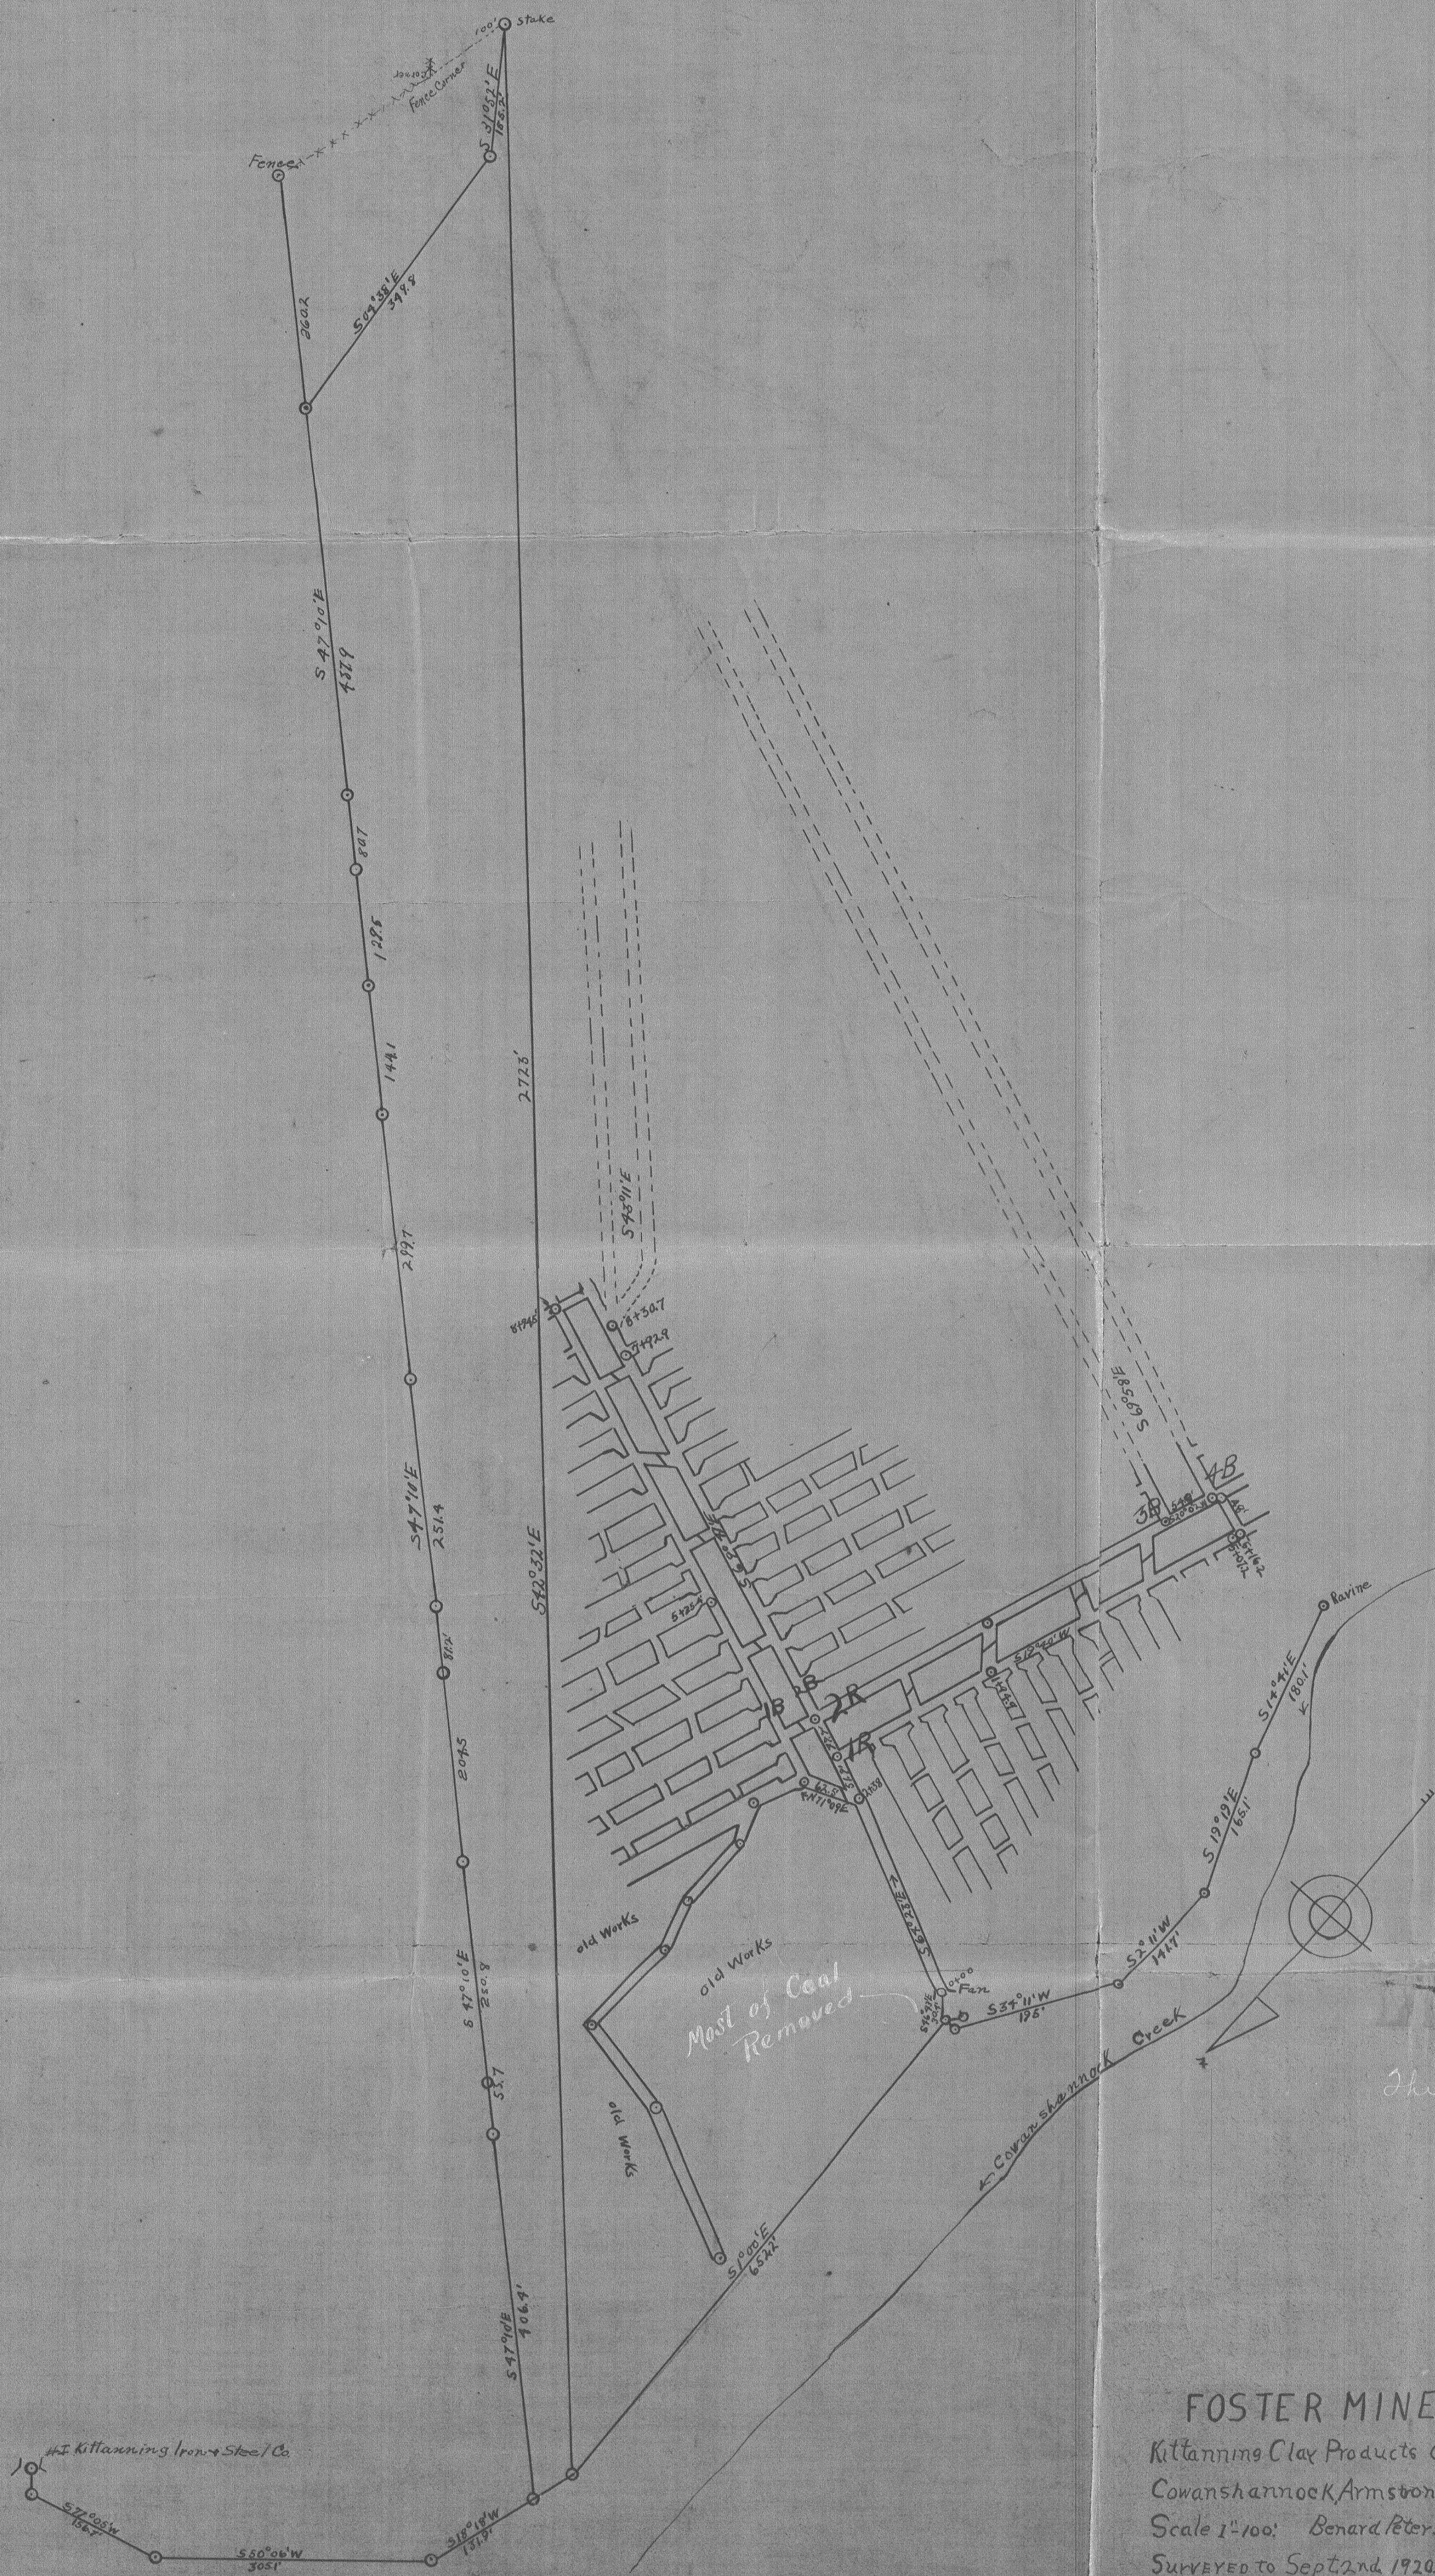

Property of
The Cowan-shannock Mining Co.,
Bradford, Pa.

FOSTER MINE.

Kittanning Clay Products Co.
Cowan-shannock, Armstrong Co.
Scale 1"=100'. Benard Peters Eng.
Surveyed to Sept 2nd, 1920.

Improvements consist of
Complete Electrical Power Plant
one 100 H.P. Gas Engine directed
connected to Generator - Cost \$10,000
2 - Sullivan Mining machines
Also mines cars, scales, pumps, ventilators, etc.
Tipple, Railroad Siding