


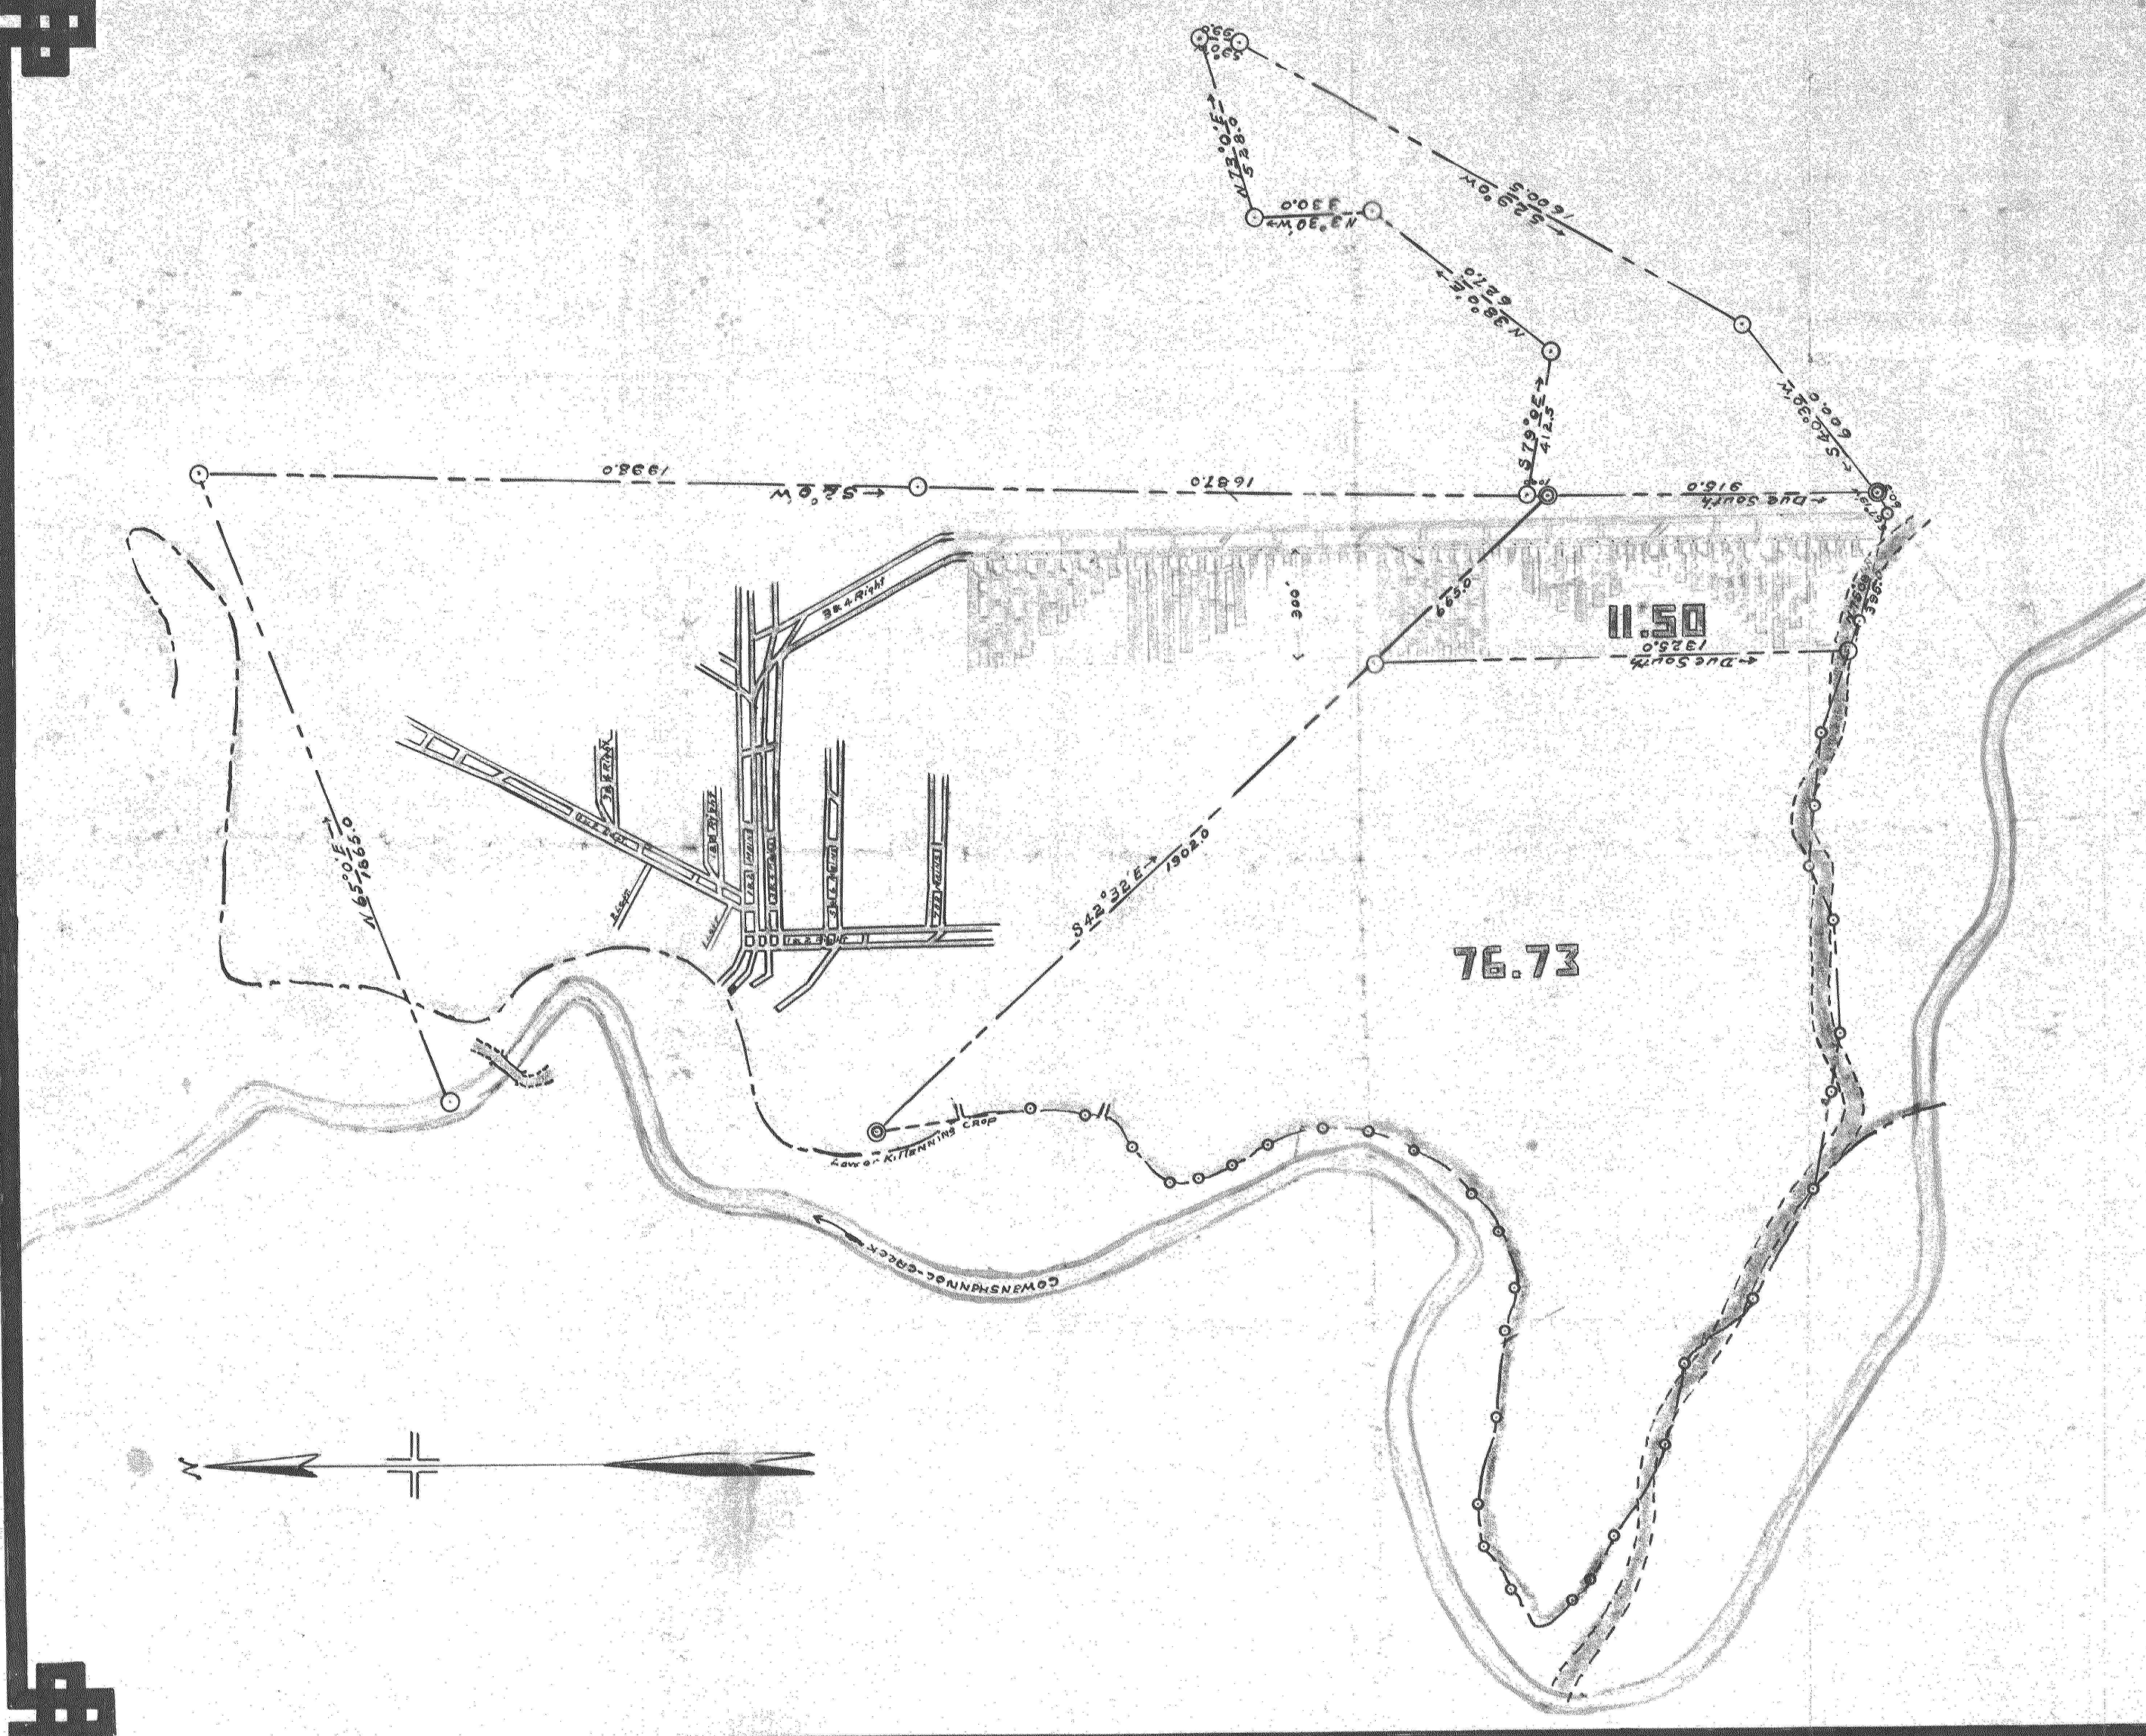

KIT TANNING IRON & STEEL MFG. CO.

PROPERTY IN RAYBURN TWP.
ARMSTRONG CO. PA.

SHOWING

G.W. FOSTER LEASE

SCALE 1 INCH = 400 FEET

APPROVED

Lang Hoffman GENL. SUPT.