
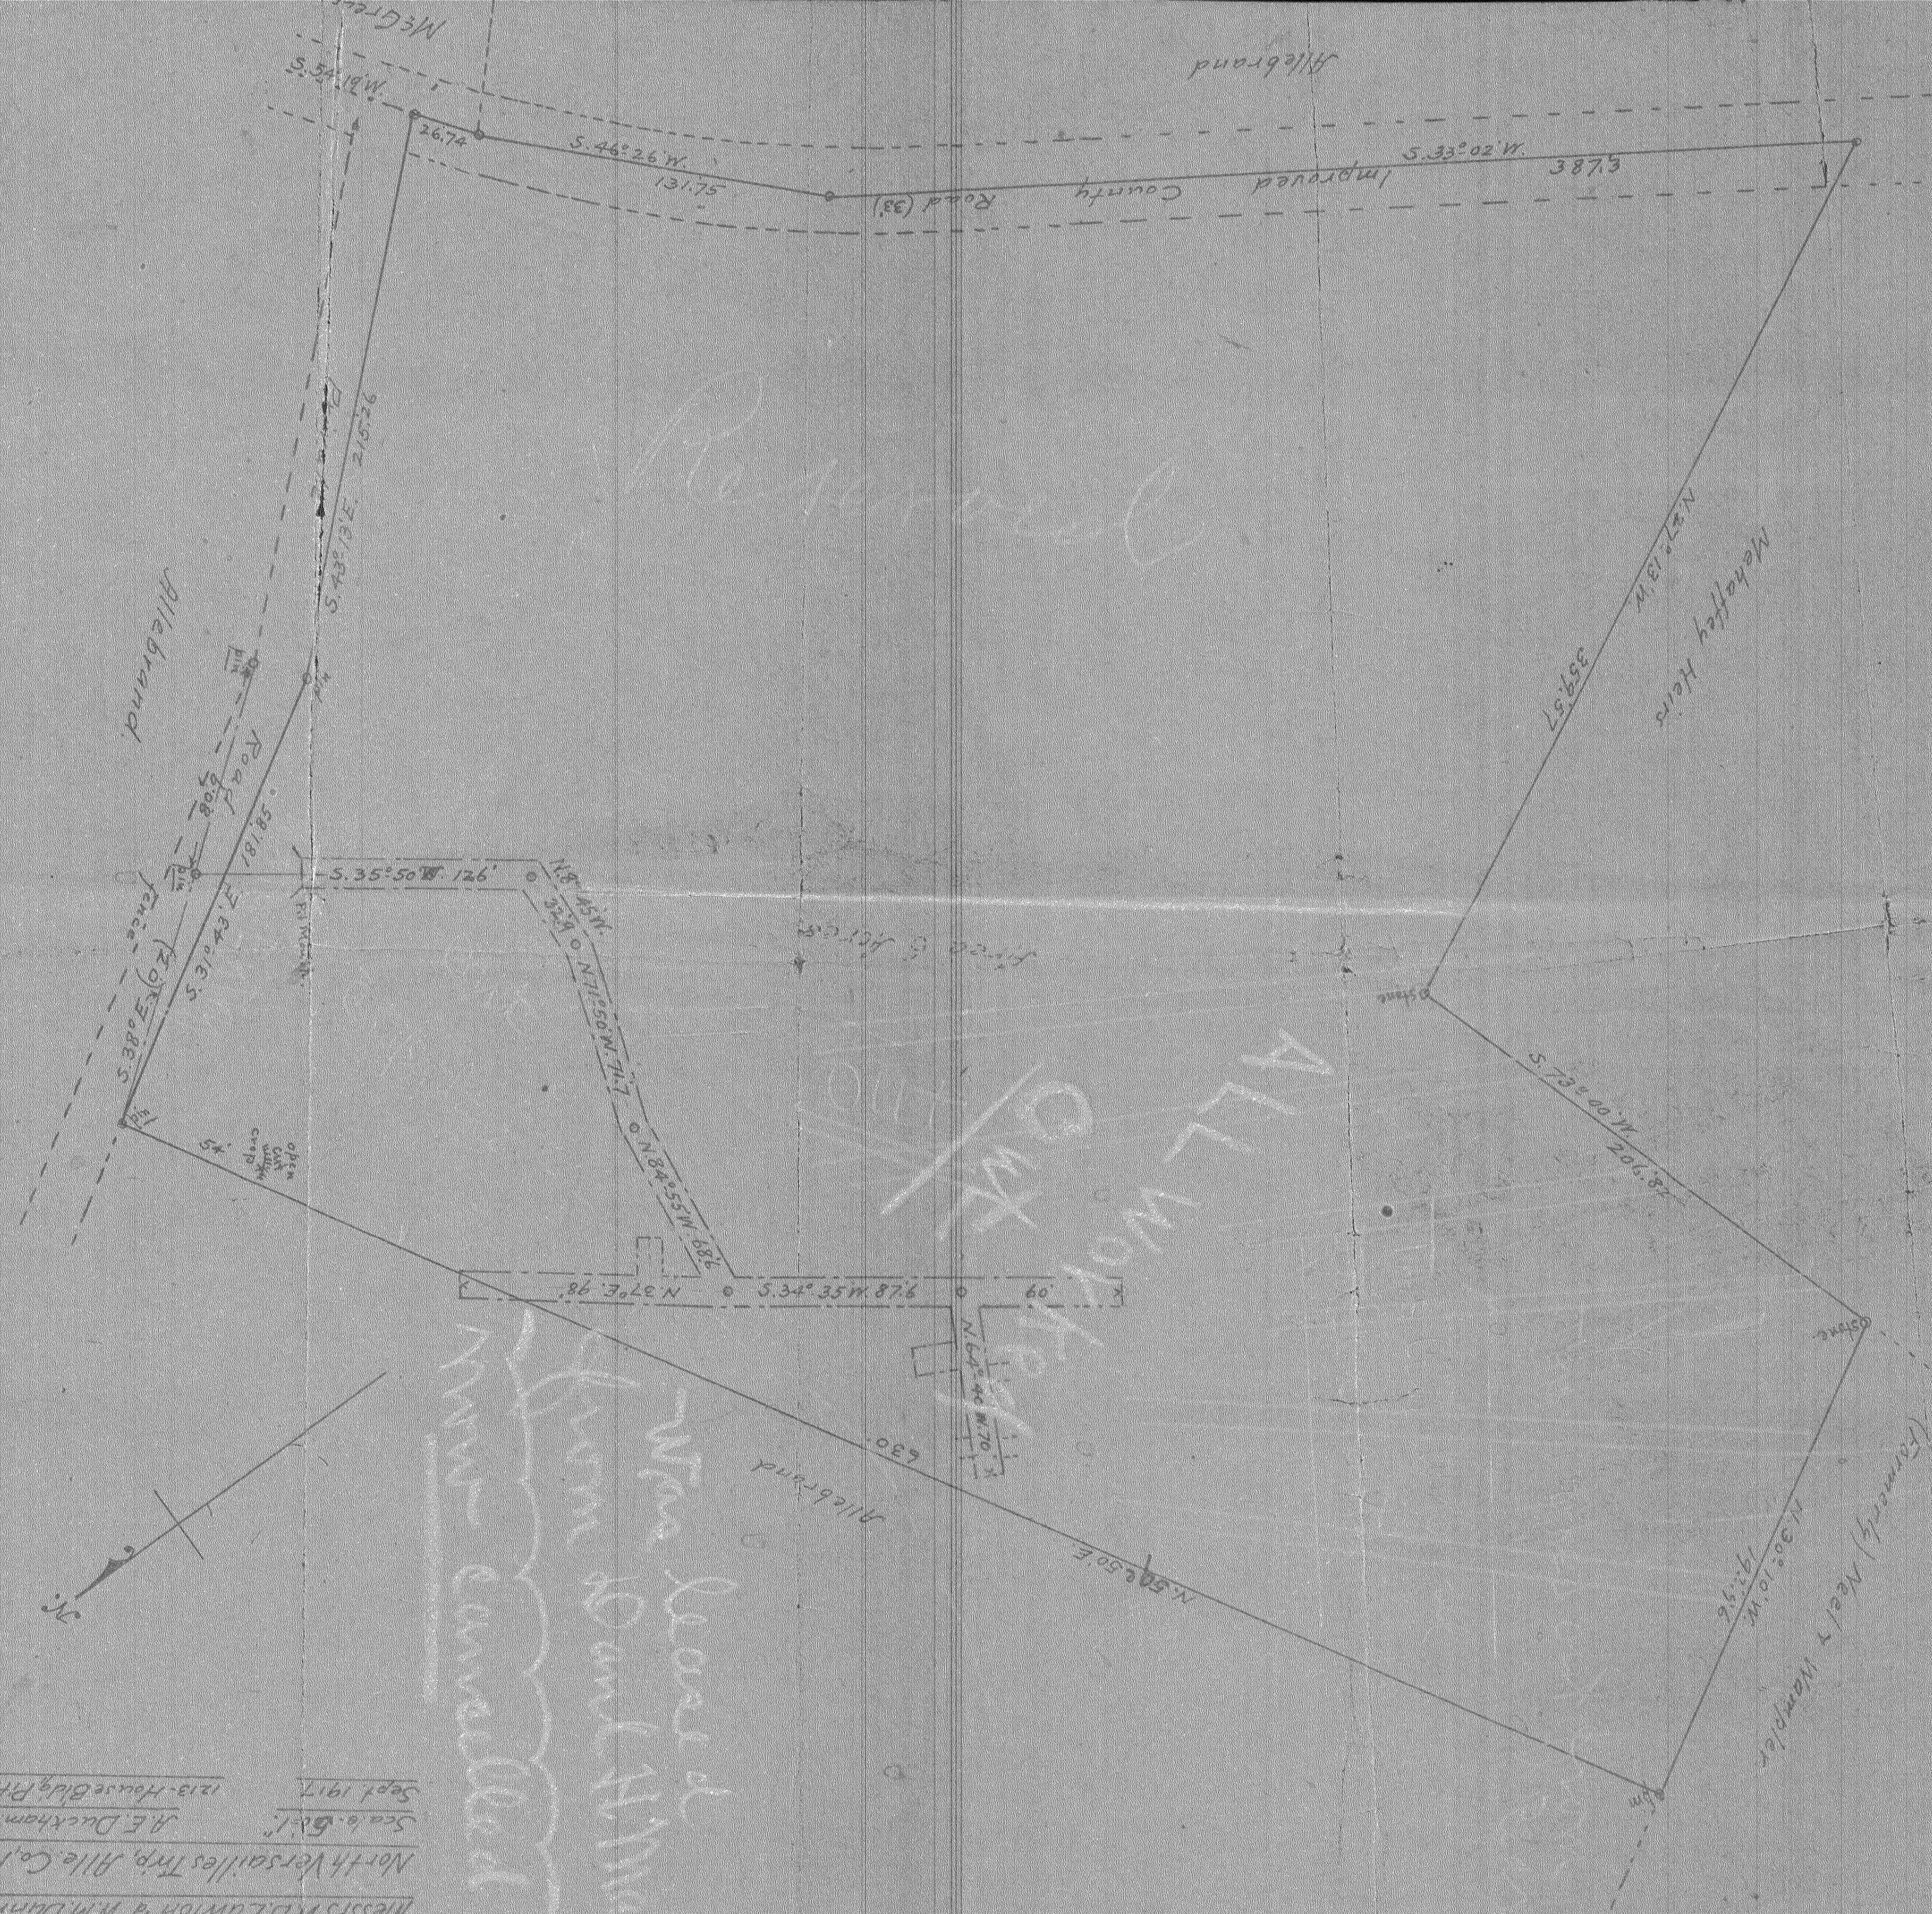


Survey of Coal Mine for
Messrs W.B. Lantry & M. Dunn
North Versailles Twp. Alle. Co. Pa.
A.E. Duckham C.E.
Sept 1917
1213-House Bldg. Pittsburgh

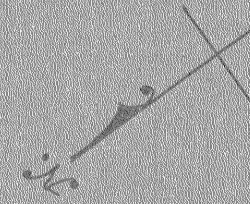

area
lost of
land & timber
now converted
to
open land

Allebrand

Area 6 Acres

N. 59° 50' E. 630.0

Improved Road (33)

Allebrand

Mehaffey Heirs

(Formerly) Neely & Wampler