


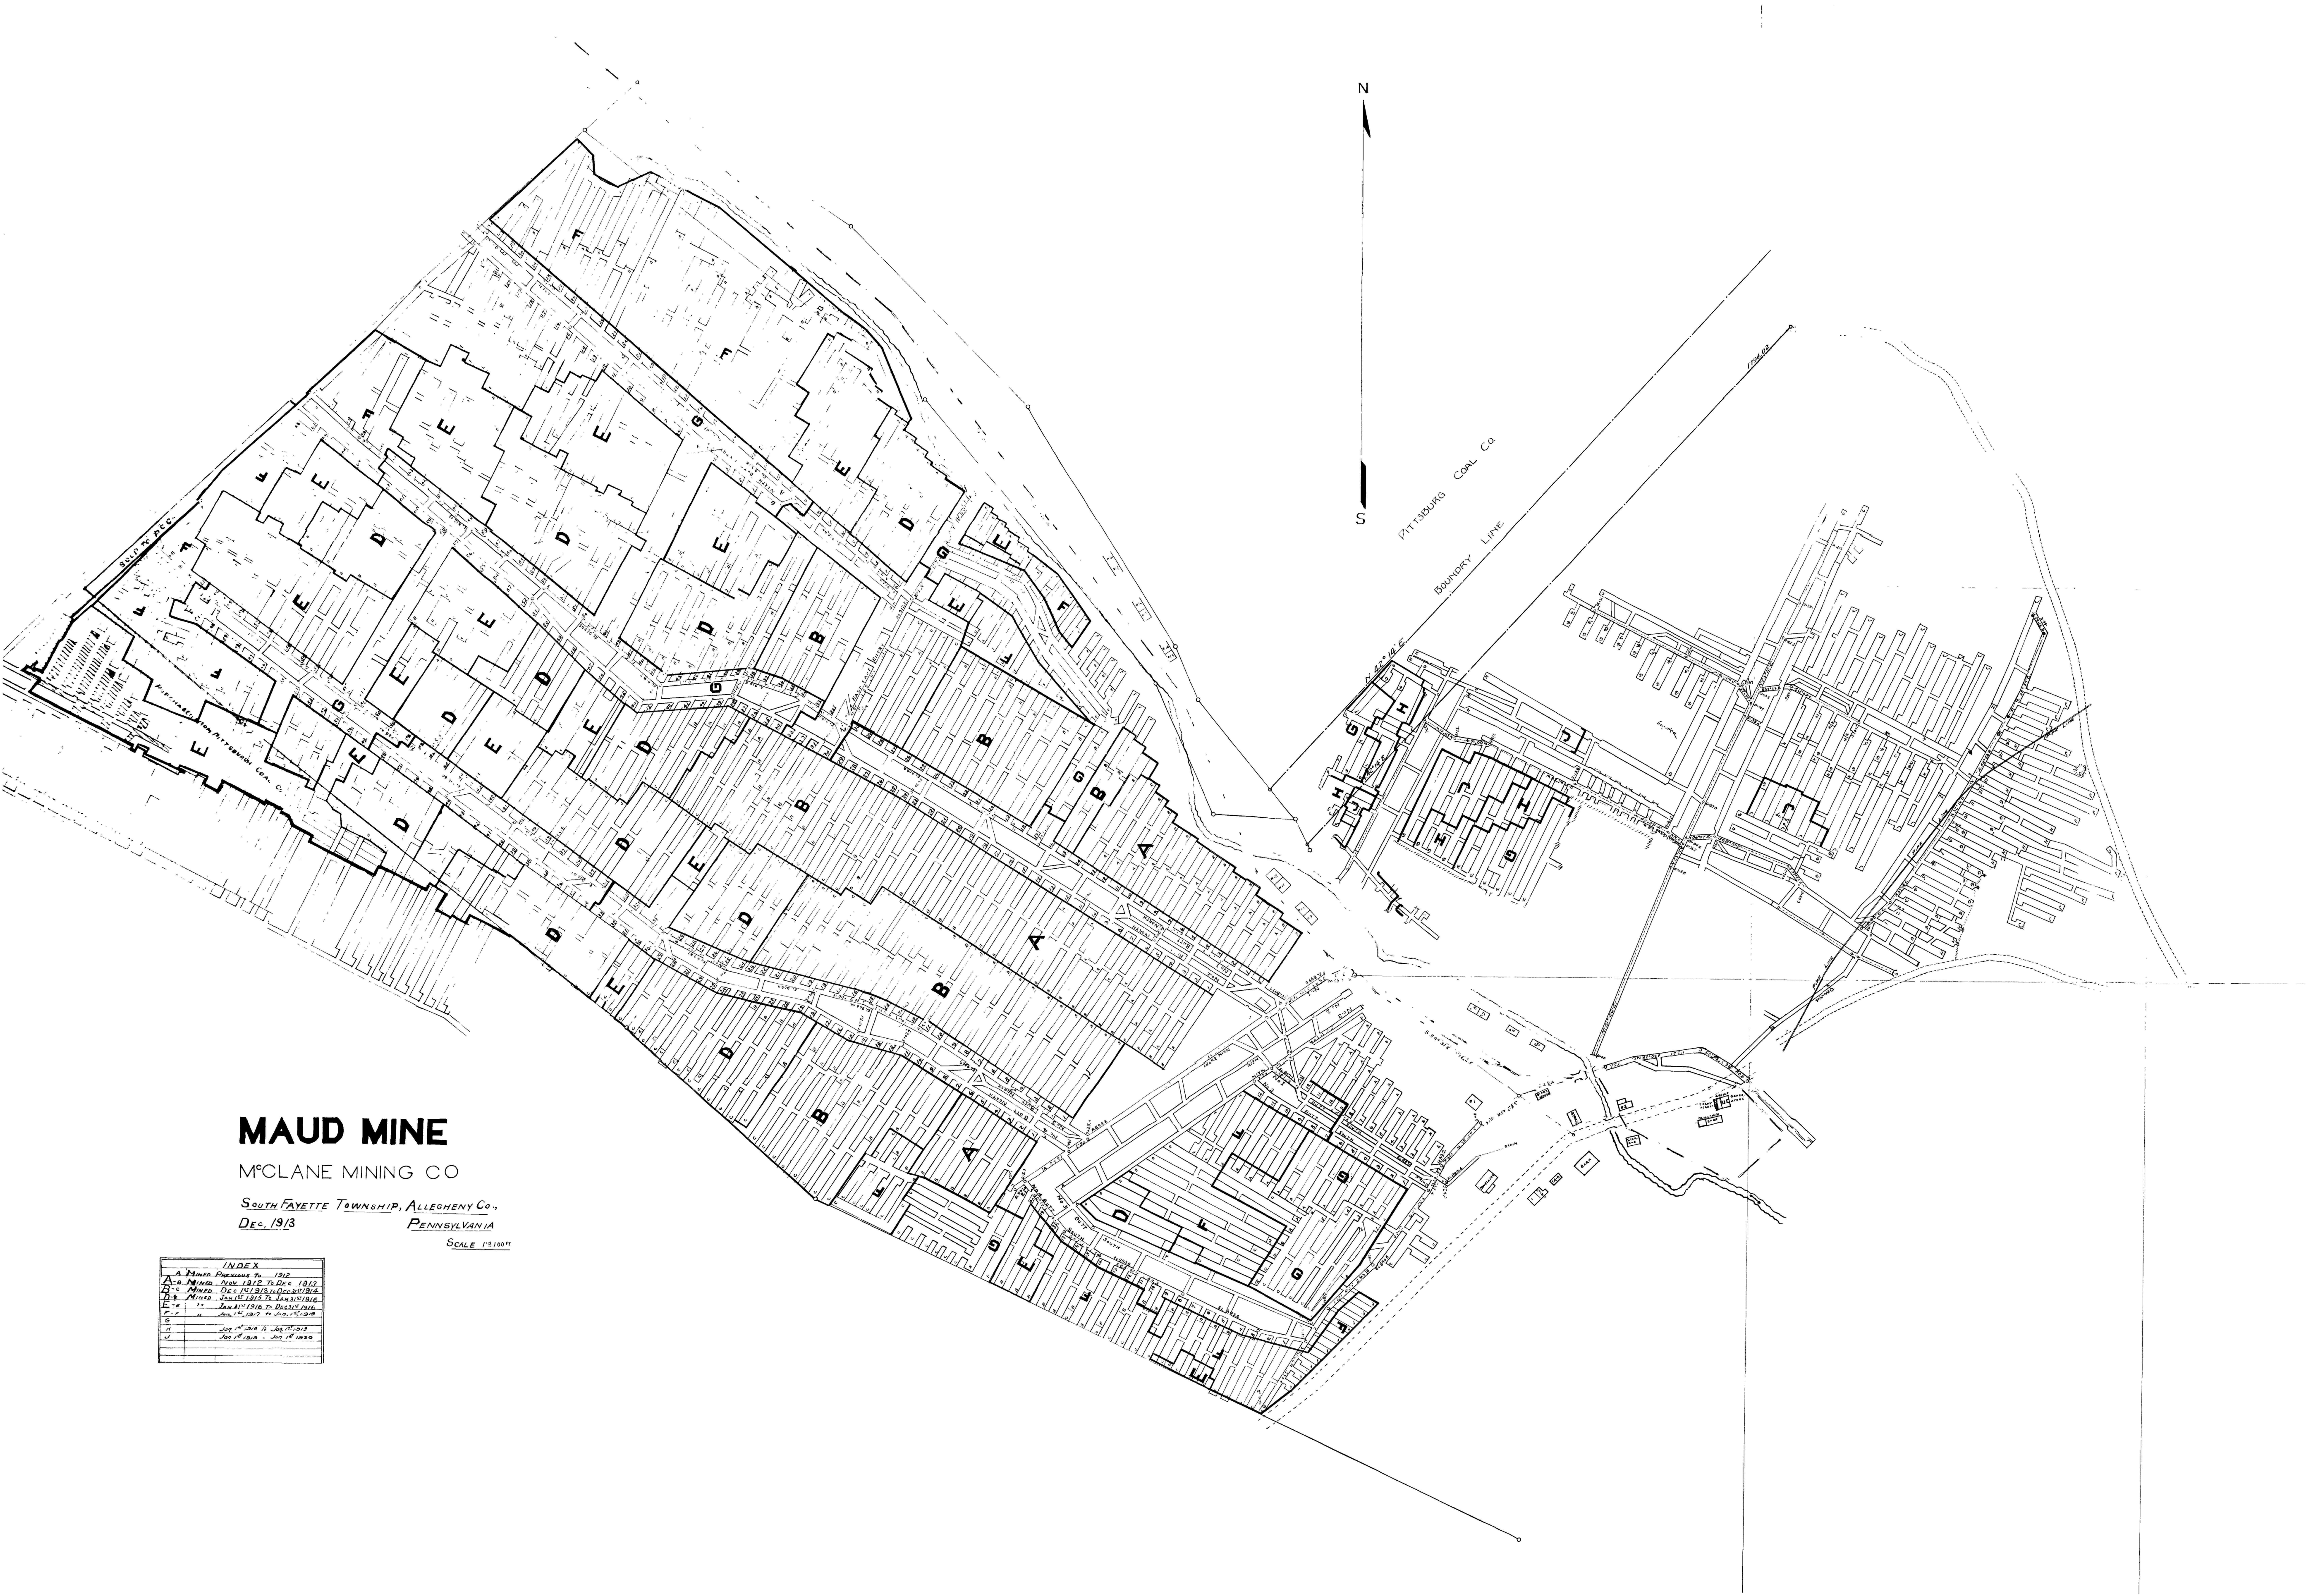

MAUD MINE

McCLANE MINING CO

SOUTH FAYETTE TOWNSHIP, ALLEGHENY CO.,
Dec. 1913 PENNSYLVANIA

SCALE 1"=100'

INDEX	
