


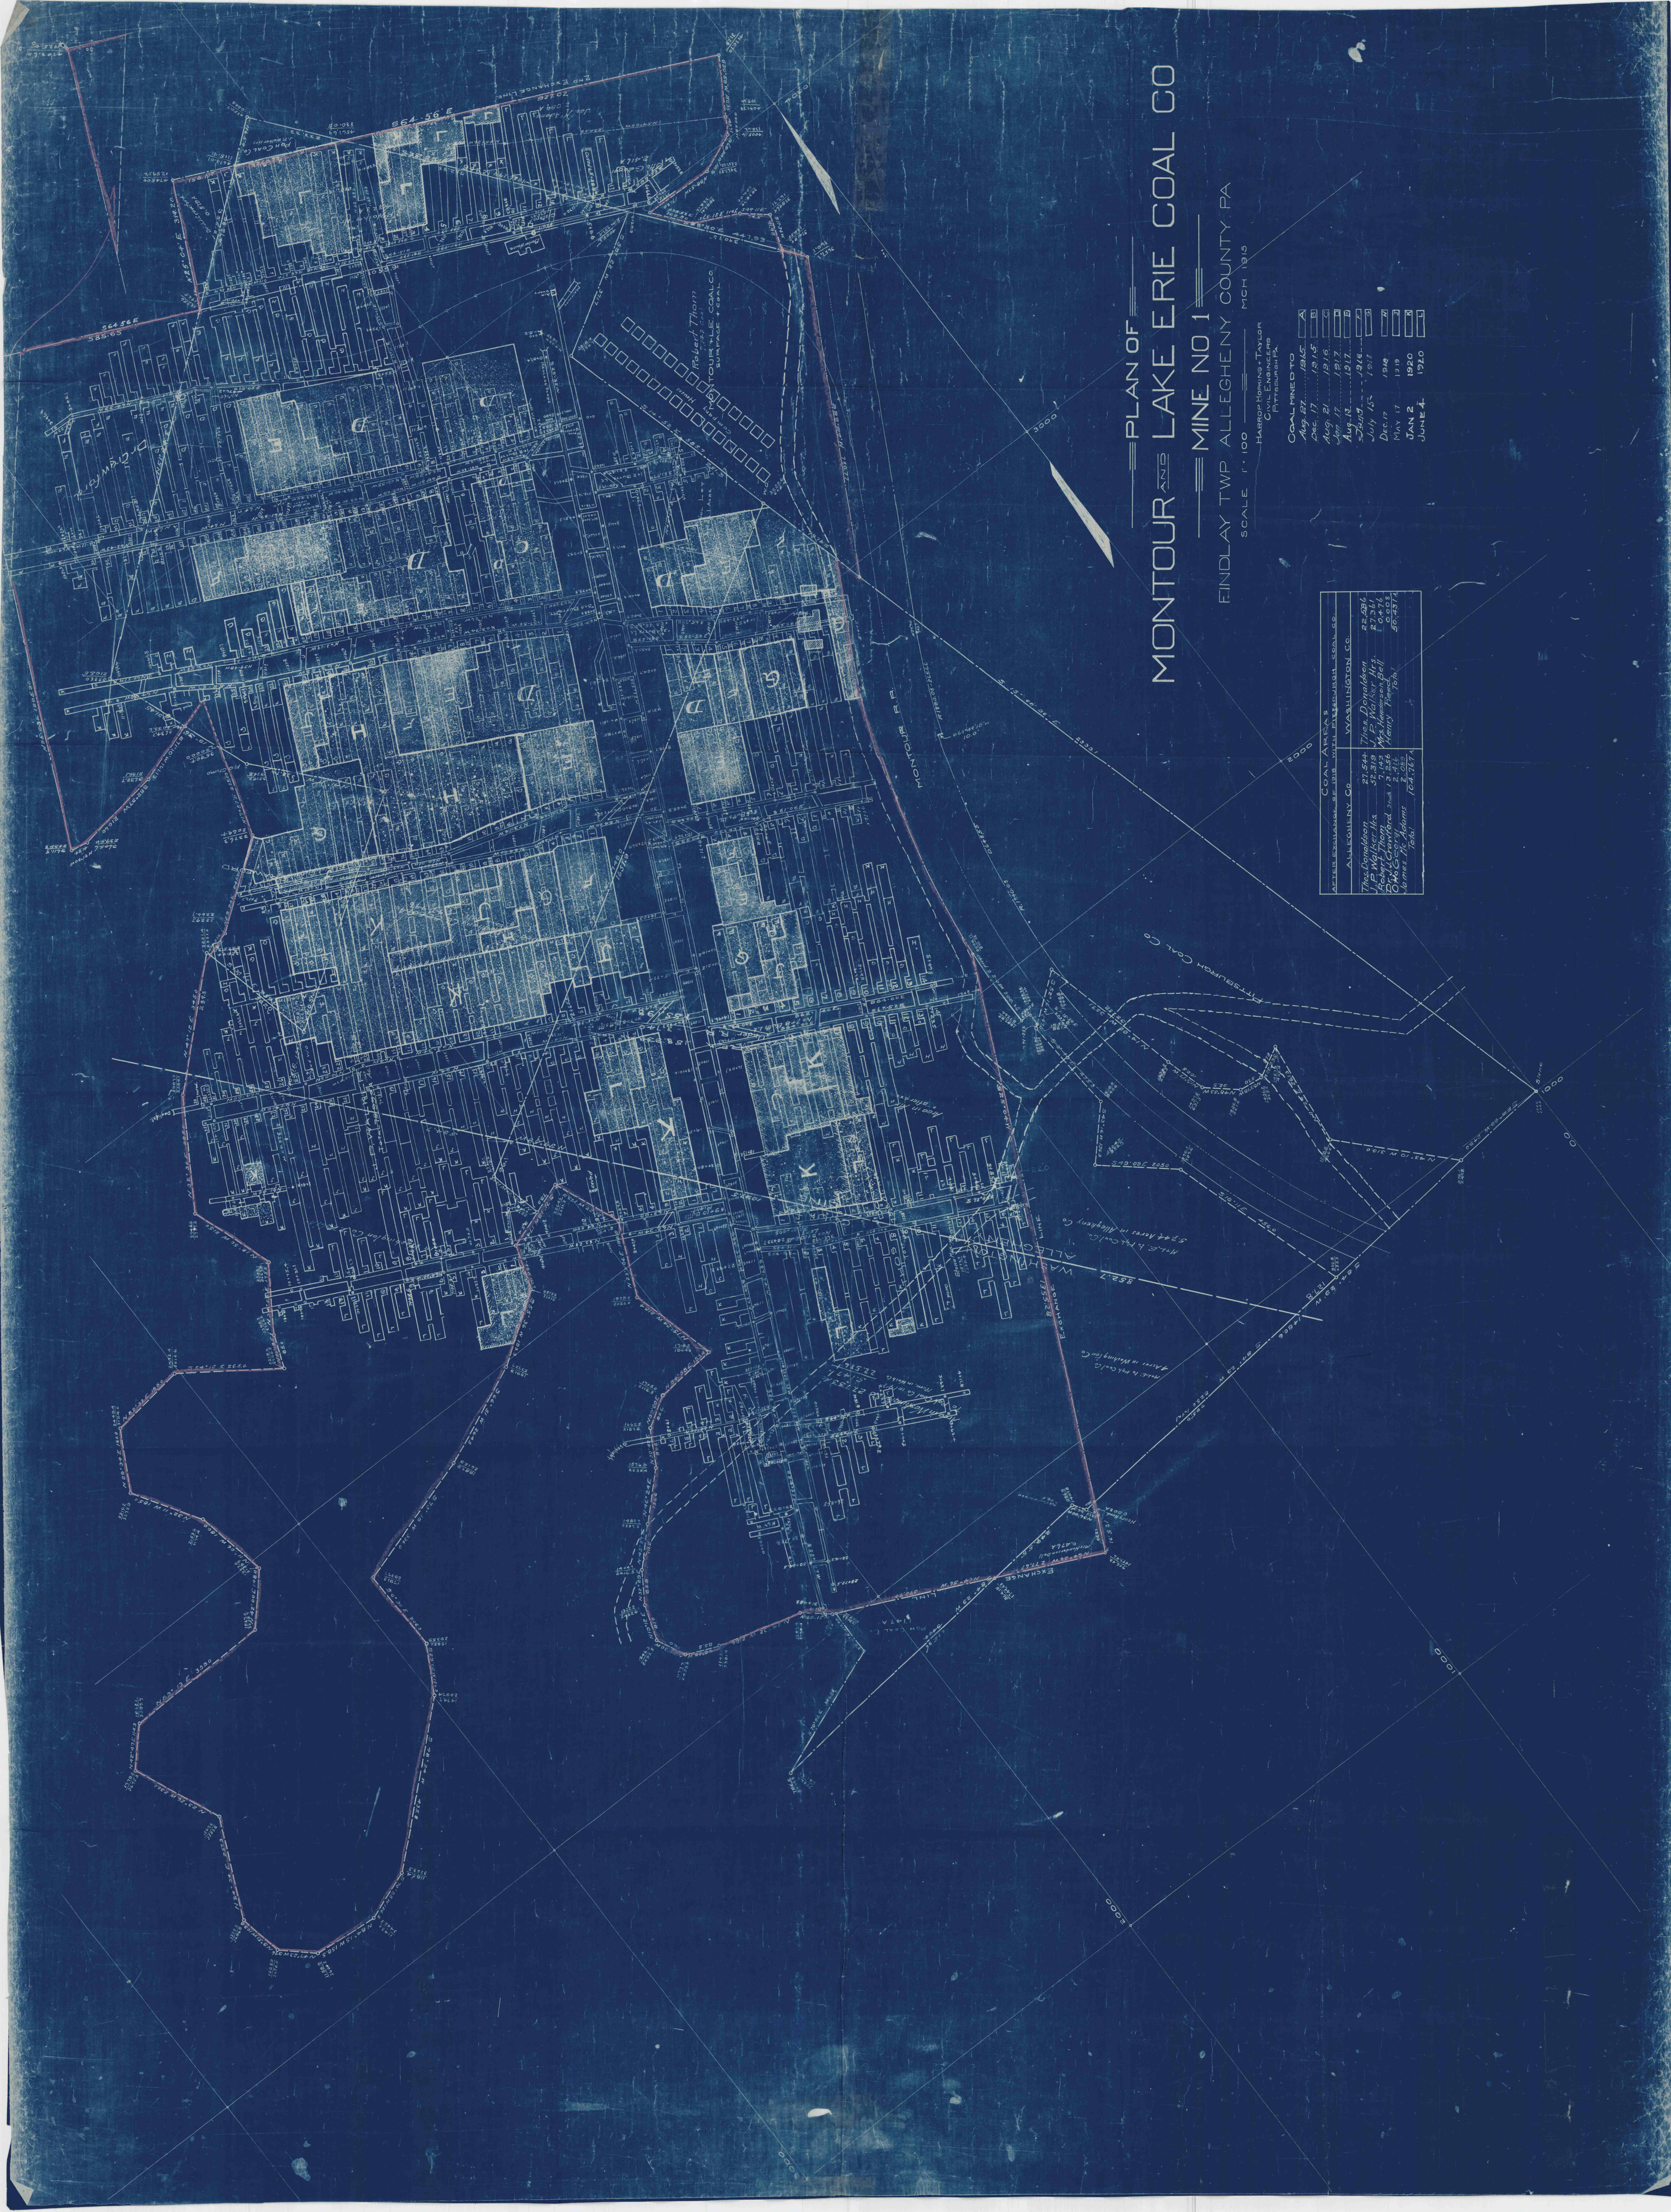

PLAN OF
MONROEVILLE LAKE ERIE COAL CO.

MINE NO. 1

FINDLAY TWP ALLEGHENY COUNTY PA

SCALE 1" = 100'

HARRISON HOBBS, TAYLOR
CIVIL ENGINEER
PITTSBURGH, PA.

COAL MINED TO	DATE	AMOUNT
Aug. 27, 1915	1915	A
Dec. 17, 1915	1915	B
Aug. 27, 1916	1916	C
Aug. 17, 1917	1917	D
Aug. 14, 1917	1917	E
Aug. 14, 1917	1917	F
July 15, 1918	1918	G
Dec. 17, 1918	1918	H
May 1, 1919	1919	I
JAN. 2, 1920	1920	J
JUNE 4, 1920	1920	K

