4-743-C

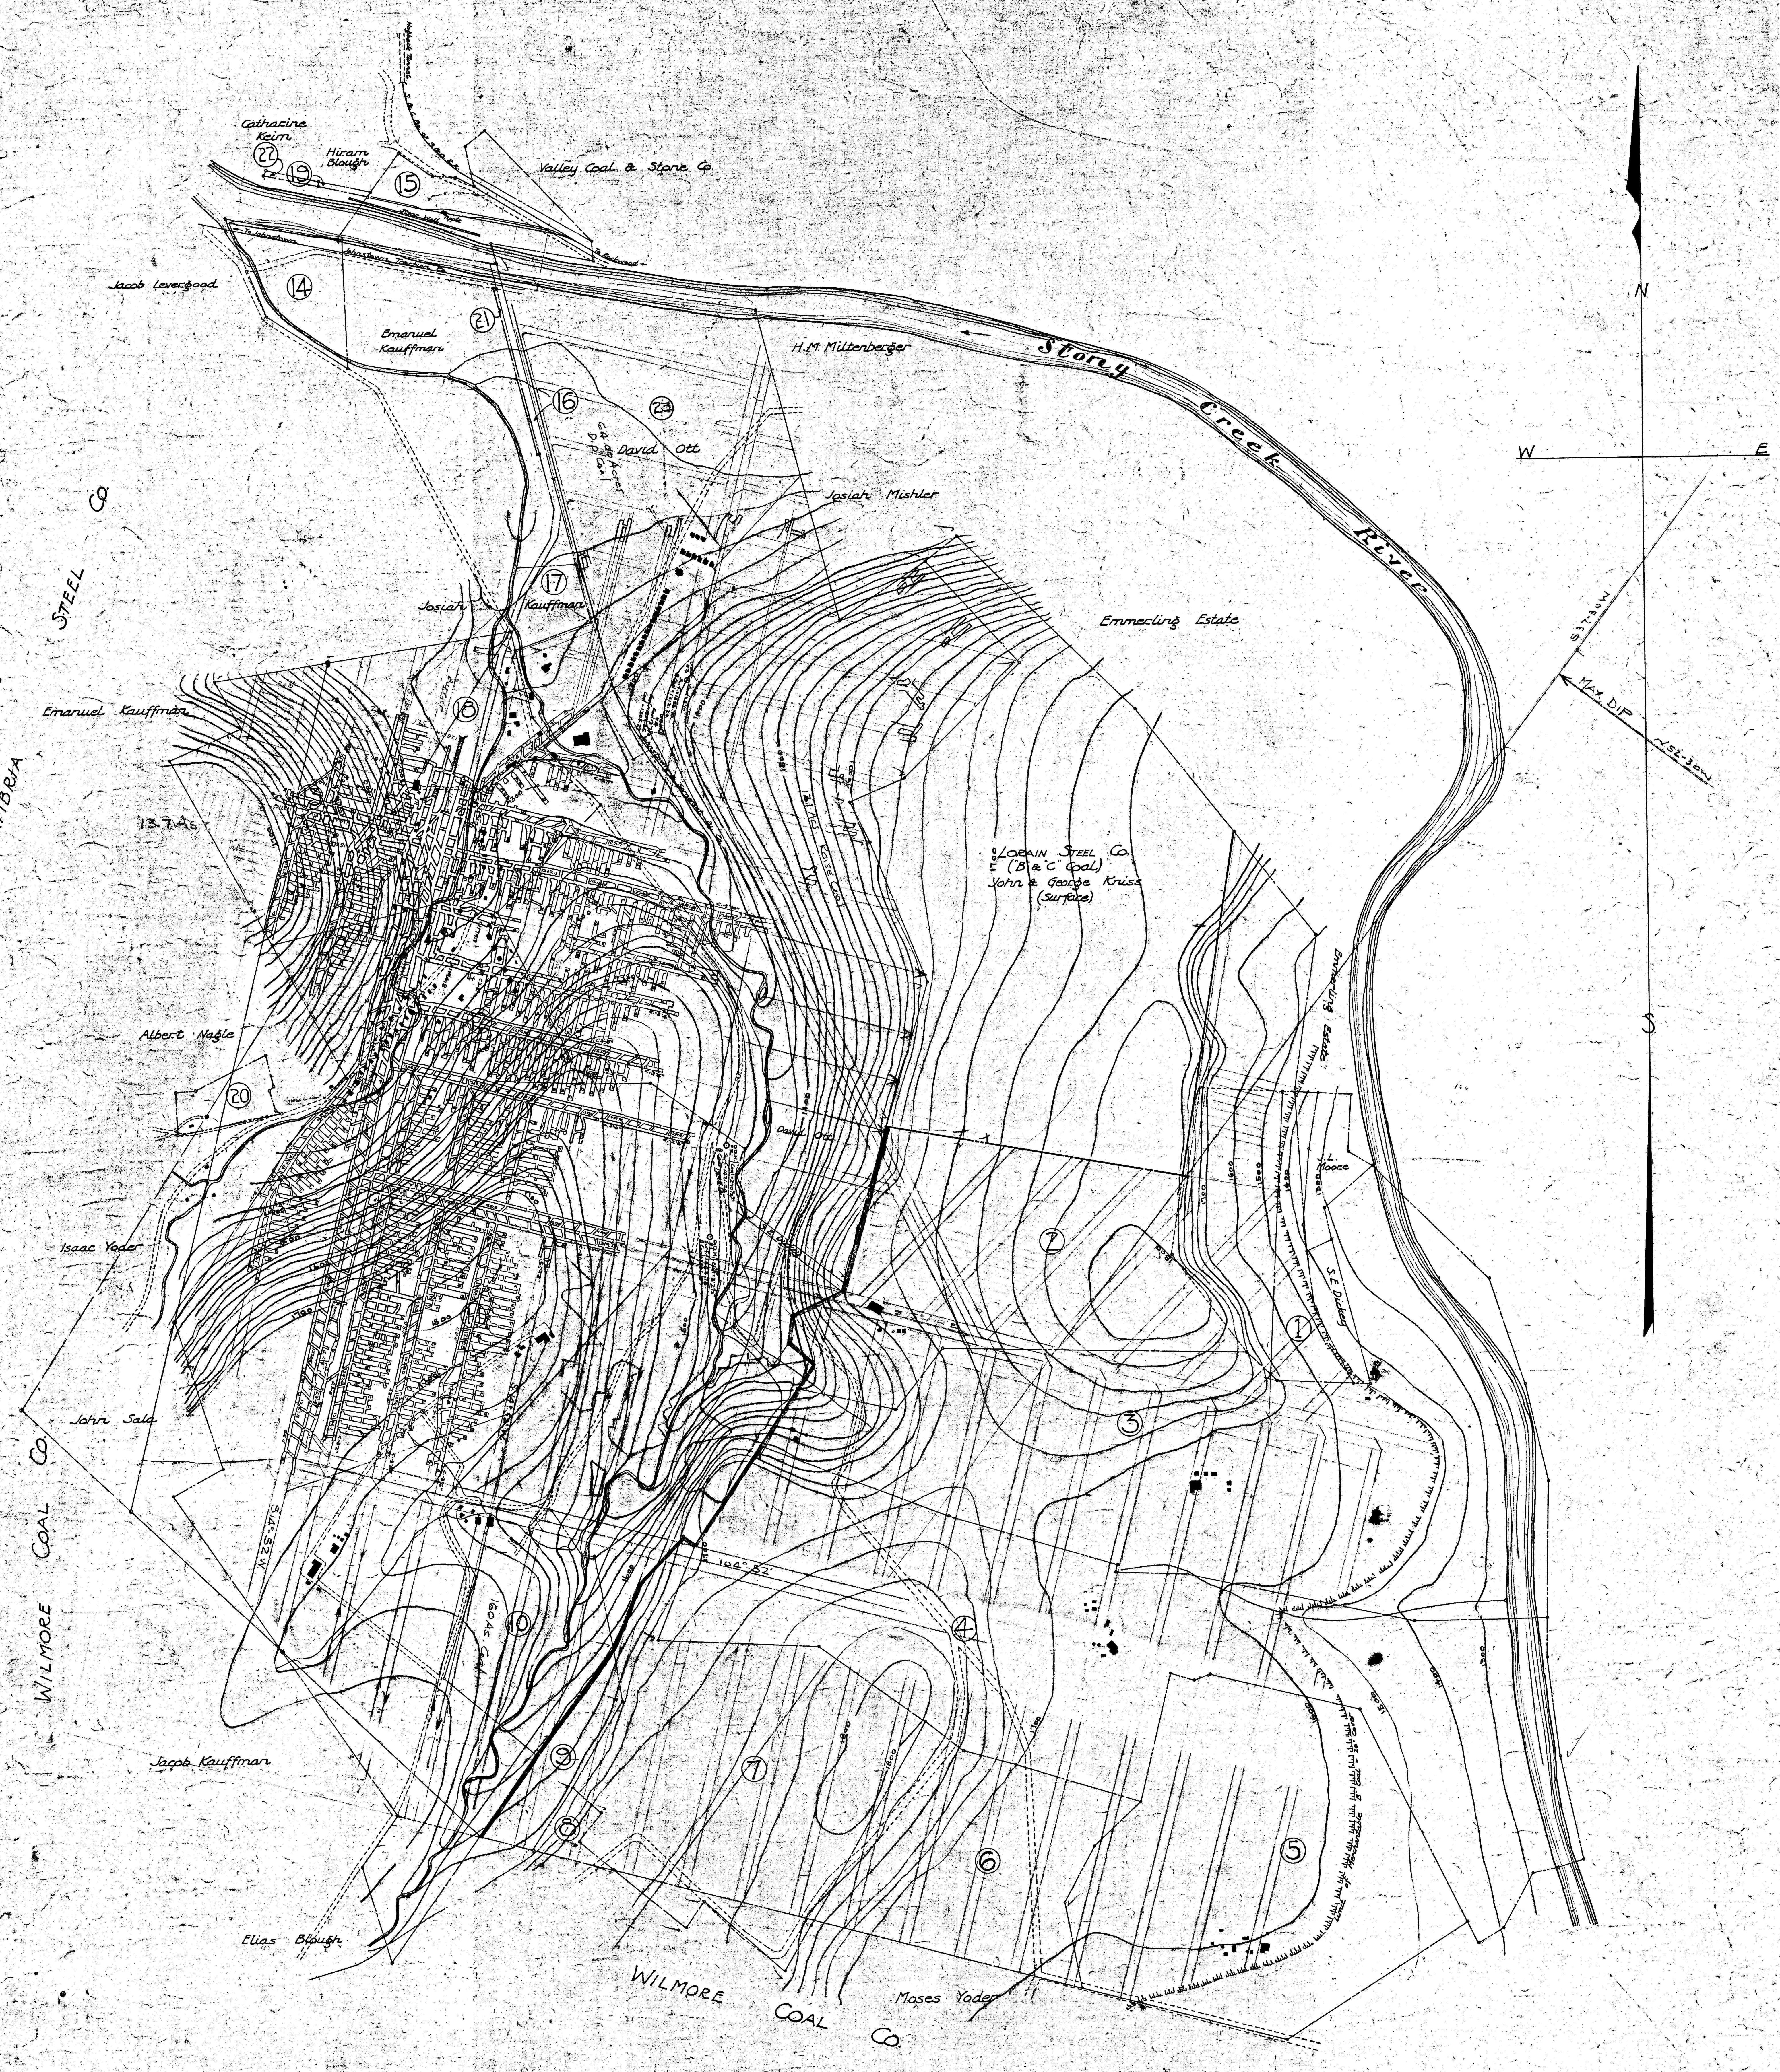

No	Name of Tract
1	Isaac Kauffman
2	Joseph Risch
3	Lewis Shettler
4	Abram Shettler
5	Jacob Alwine
6	Moses Yoder
7	Jacob Harshberger
8	Jacob I. Kauffman
9	Joseph I. Kauffman
10	L.J. Foust
11	Joseph T. Yoder
12	D.K. Berkey
13	John Kauffman
14	John Kauffman
15	Emanuel Blough
16	Emanuel Kauffman
17	Josiah Kauffman
18	John Kauffman
19	Hiram Blough
20	Andy Blackner.
21	Emanual Kaufman
22	Catherine Keim

INDEX TO SURVEYS

Letter	Date
C	Prior to Jan. 1, 1918
E	Jan. 1, 1919
H	Jan. 1, 1920
L	Jan. 1, 1921
P	Jan. 1, 1922.
R	Jan. 1, 1923.
U	Jan. 1, 1924.
A	JAN. 5, 1926
D	JAN. 13, 1927
G	DEC 9 1927

DEEP MINE SAFETY 400
0 400 800 Feet

MINE NO. 4
BIRD COAL CO.
B SEAM MINING OPERATIONS

SITUATE IN
CONEMAUGH TWP., SOMERSET COUNTY, PA.
AND
STONY CREEK TWP., CAMBRIA COUNTY, PA.

Scale 1" = 400'   S.E. Dickey & Co.   Feb. 25, 1921.
Civil and Mining Engrs.
Johnstown, Pa.

NOV. 15, 1922.   BIRD COAL CO. ENGR DEP'T.
C.P. BRINTON ENGR.