


INDEX TO SURVEYS.

LETTER	DATE
A	Prior to Jan. 1, 1918.
B	Jan. 1, 1918.
C	Jan. 1, 1919.
D	Jan. 1, 1920.

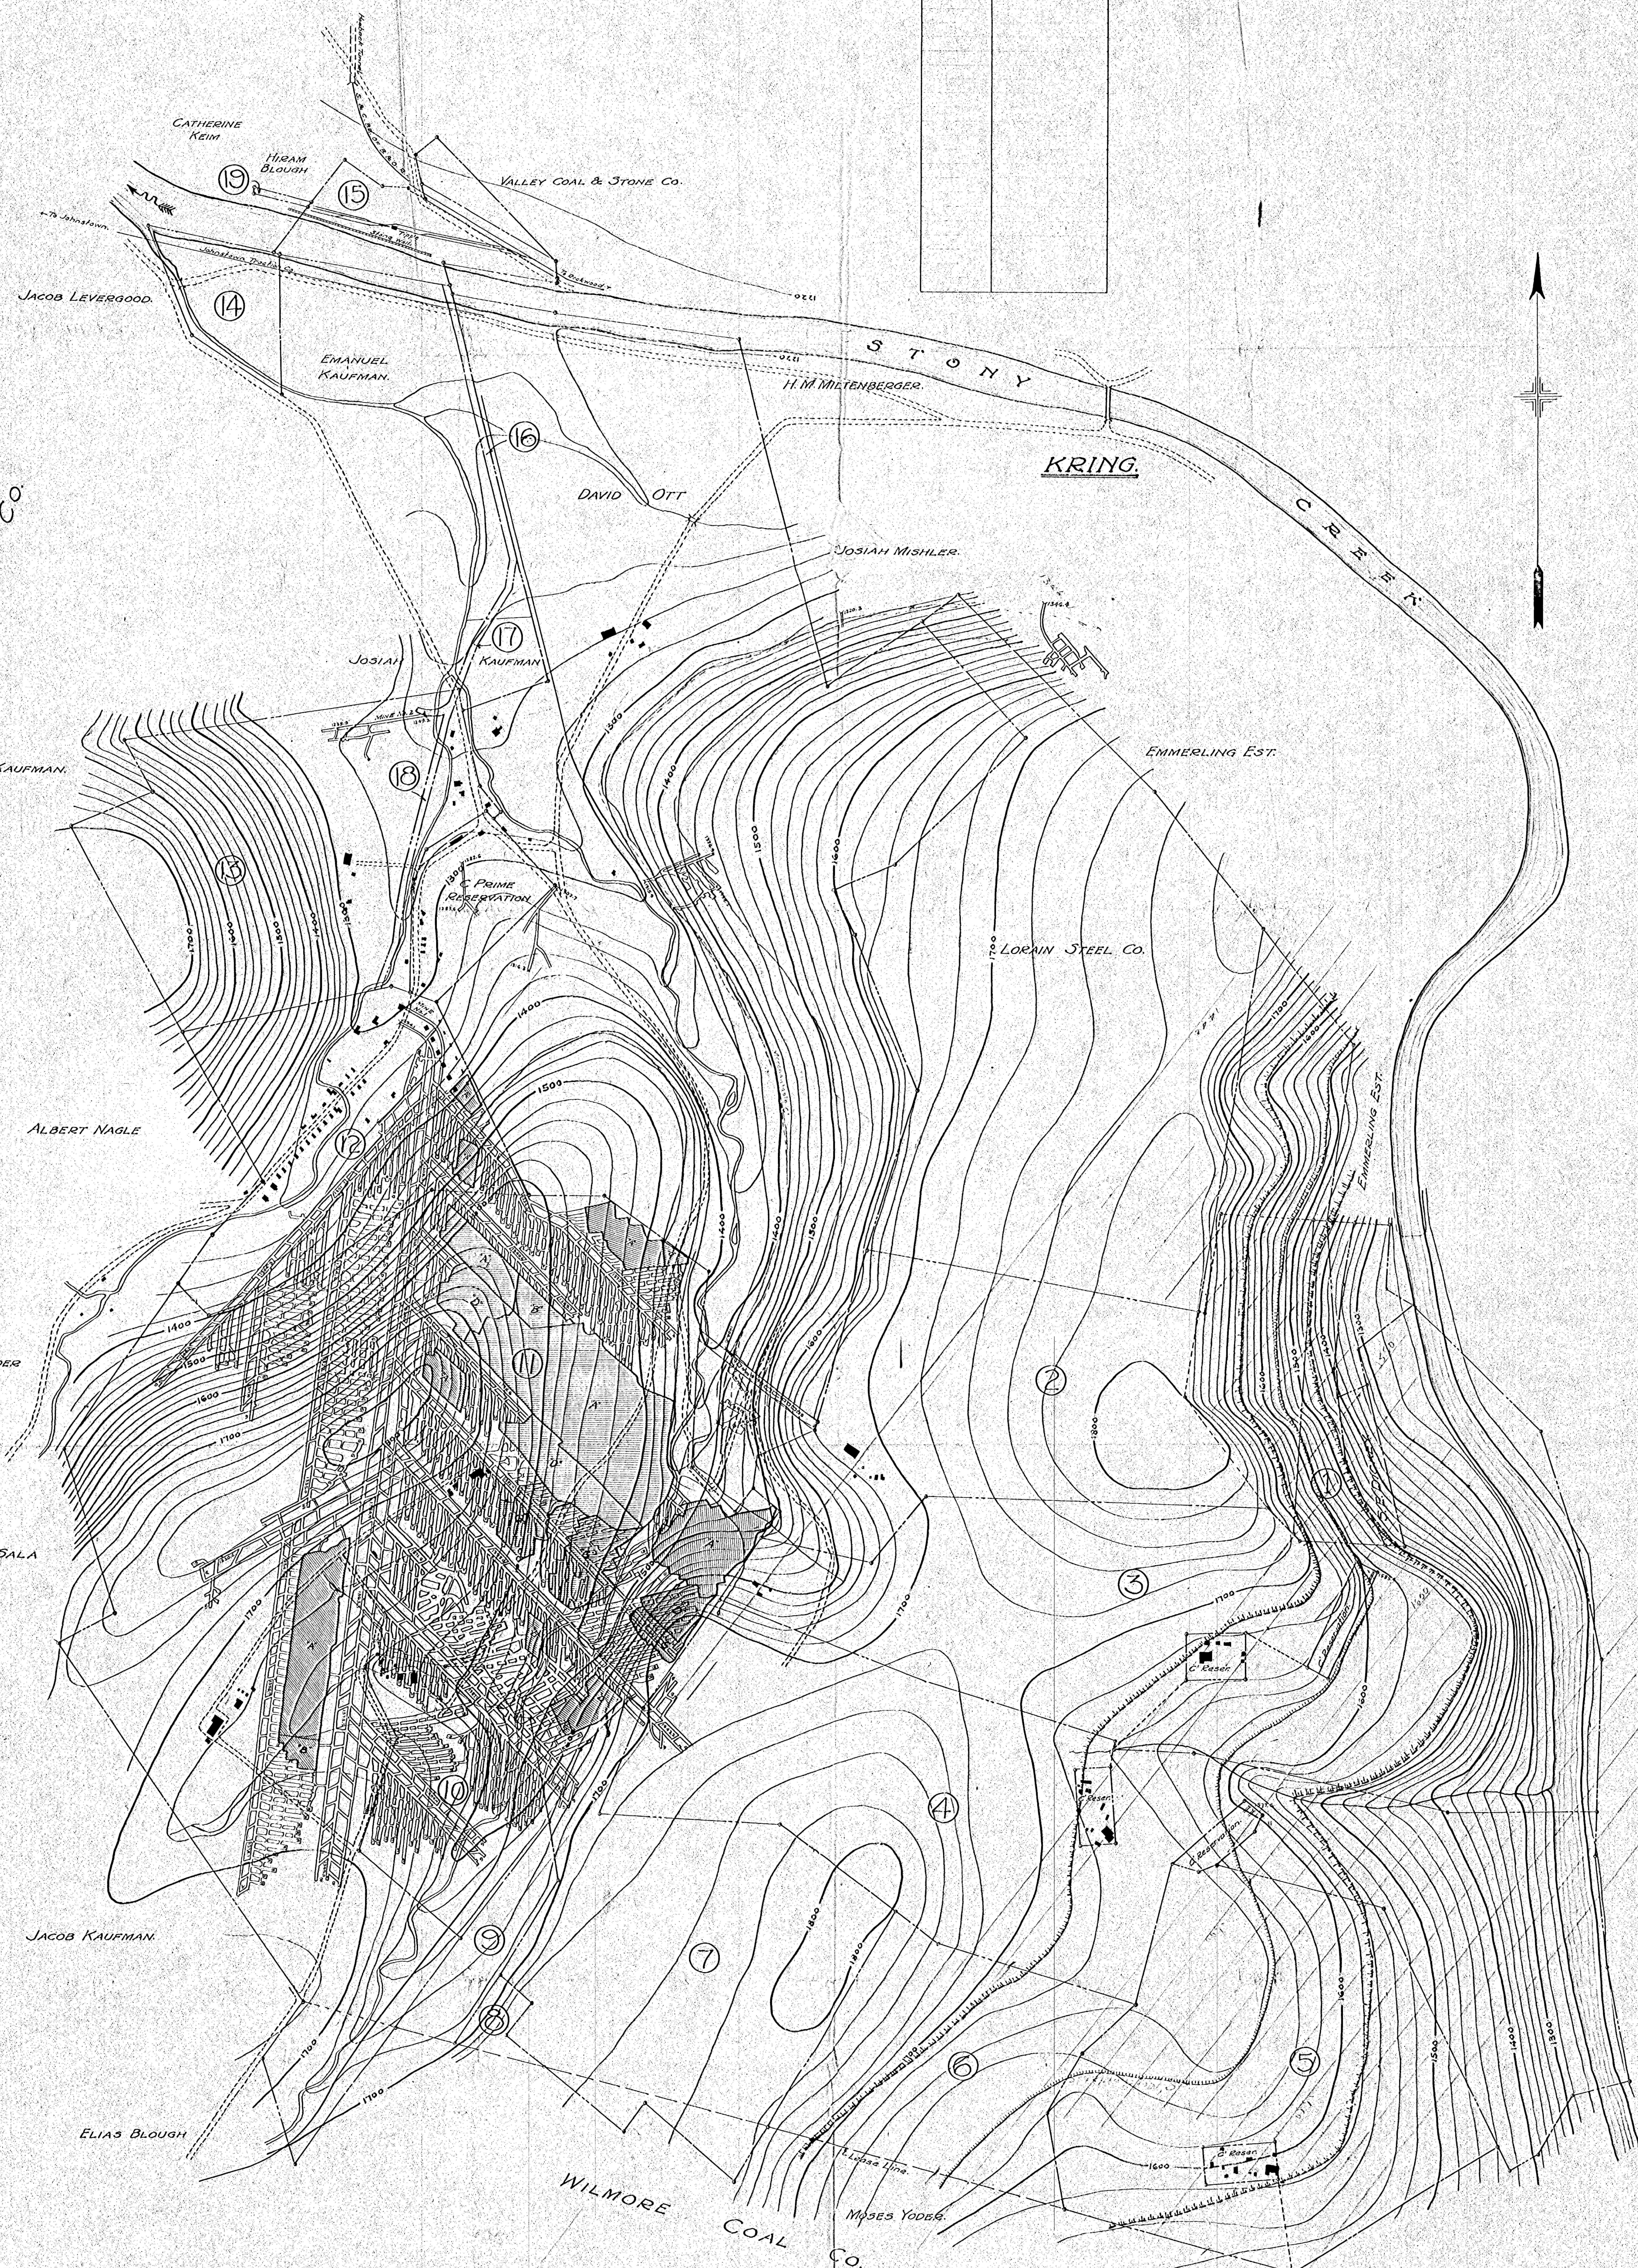

NO.	NAME OF TRACT.
1	ISAAC KAUFMAN.
2	JOSEPH BACH.
3	LEWIS SHETTLER.
4	ABRAHAM SHETTLER.
5	JACOB ALVINE.
6	MOSES YODER.
7	JACOB MARSHBERGER.
8	JACOB I. KAUFMAN.
9	JOSEPH I. KAUFMAN.
10	L. J. FOUST.
11	JOSEPH T. YODER.
12	D. K. BERKEY.
13	JOHN KAUFMAN.
14	JOHN KAUFMAN.
15	EMANUEL BLOUGH.
16	EMANUEL KAUFMAN.
17	JOSIAH KAUFMAN.
18	JOHN KAUFMAN.
19	HIRSH BLOUGH.

BIRD COAL CO.
C PRIME MINING OPERATIONS
 SITUATE IN
 CONEMAUGH TWP., SOMERSET COUNTY, PA.
 AND
 STONY CREEK TWP., CAMBRIA COUNTY, PA.
 Scale 1" = 400' S. E. Dickey & Co. July 2, 1920.
 Civil and Mining Engrs.
 Johnstown, Pa.