


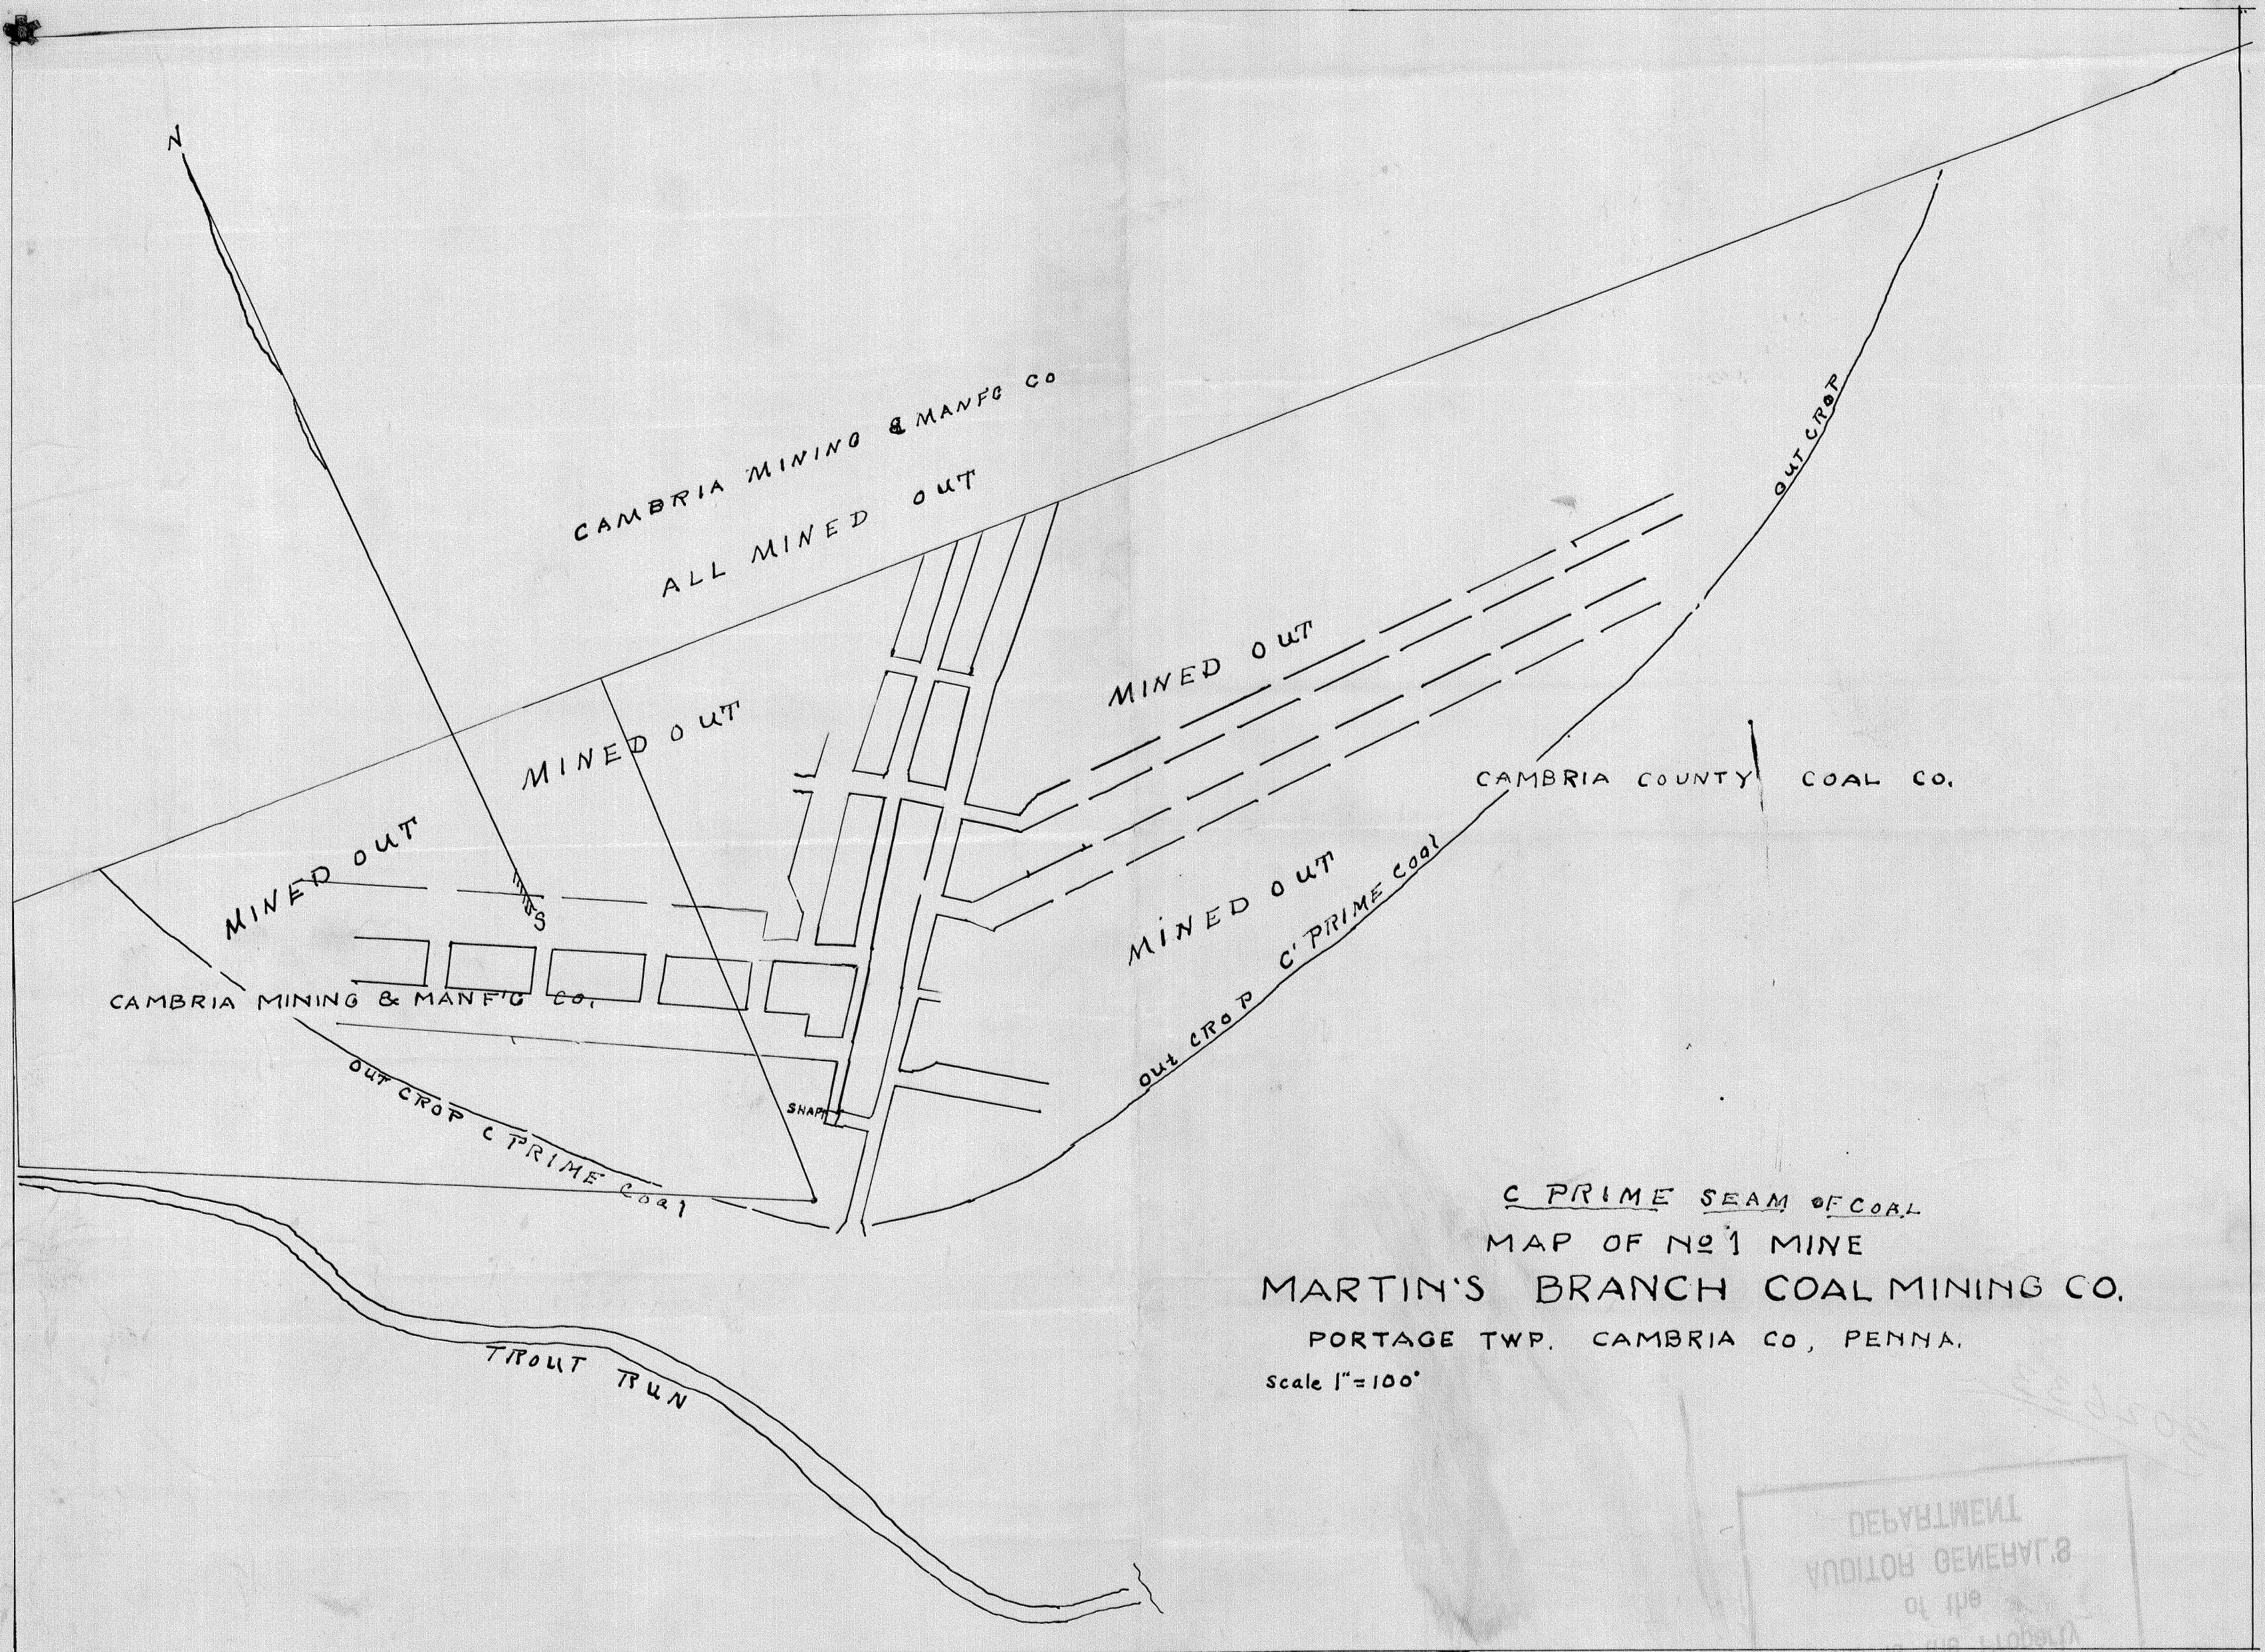

C PRIME SEAM OF COAL
MAP OF NO 1 MINE
MARTIN'S BRANCH COAL MINING CO.
PORTAGE TWP. CAMBRIA CO, PENNA.
Scale 1" = 100'

