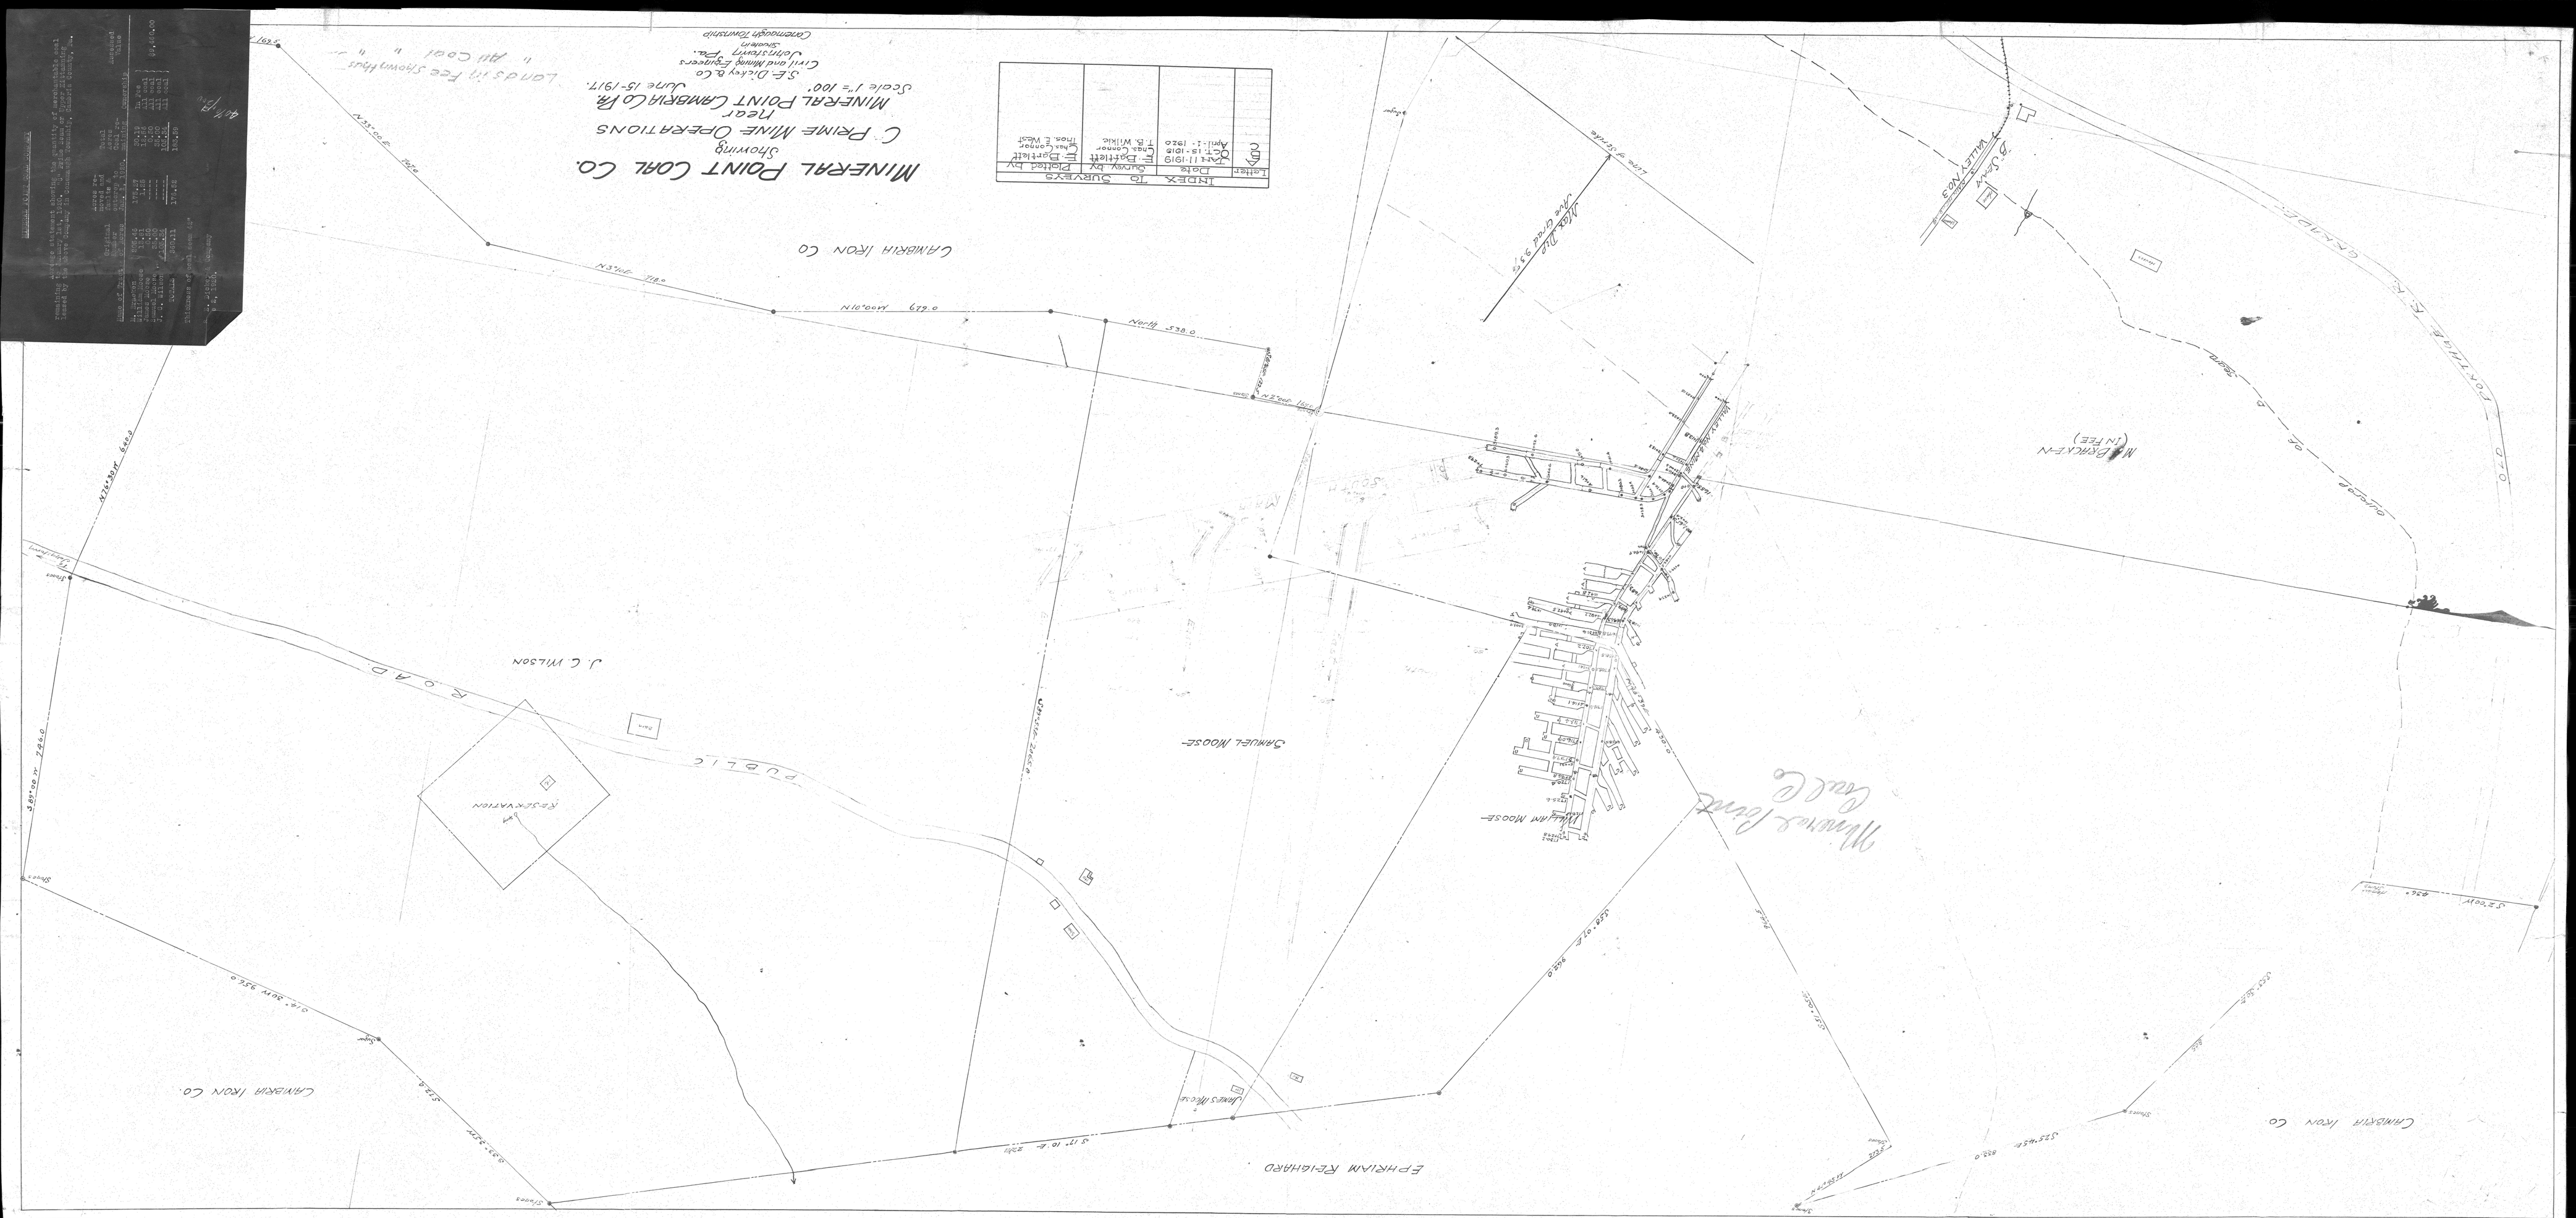
MINERAL POINT COAL CO.
Showing
C. PRIME MINE OPERATIONS
near
MINERAL POINT CAMBRIA CO PA.
Scale 1" = 100'. June 15-1917.
S.E. Dickey & Co
Civil and Mining Engineers
Lands in Fee Shown thus
" All Coal " " "
INDEX To SURVEYS
Letter | Date | Survey by | Plotted by
A | Oct 15-1915 | E. Dorthitt | E. Dorthitt
Apri-1-1920 | Chas Conner | Chas Conner
T.B. Wilkie | Thos E. West
CAMBRIA IRON CO
North 538.0
