

MAP OF PROPERTY OF THE MORRELLVILLE COAL & COKE CO.


UNDER LEASE TO THE
MORRELLVILLE COAL MINING CO.
LOWER YODER TWP. CAMBRIA CO. PENNA.
SHOWING AREAS OF MERCHANTABLE 'B' OR MILLER SEAM COAL
Prepared by the Undersigned arbitrators in pursuance of the agreement of Aug. 26, 1913
to accompany report dated Feb. 23, 1913.

Scale 1"=400'

COPIED BY
FETTERMAN ENG. CO.
APRIL 24, 1916.

Signed *Andrew B. Crichton*
W. A. Sellman
C. P. Collins

NOTE—
The areas of Merchantable 'B' Seam Coal are outlined in red.

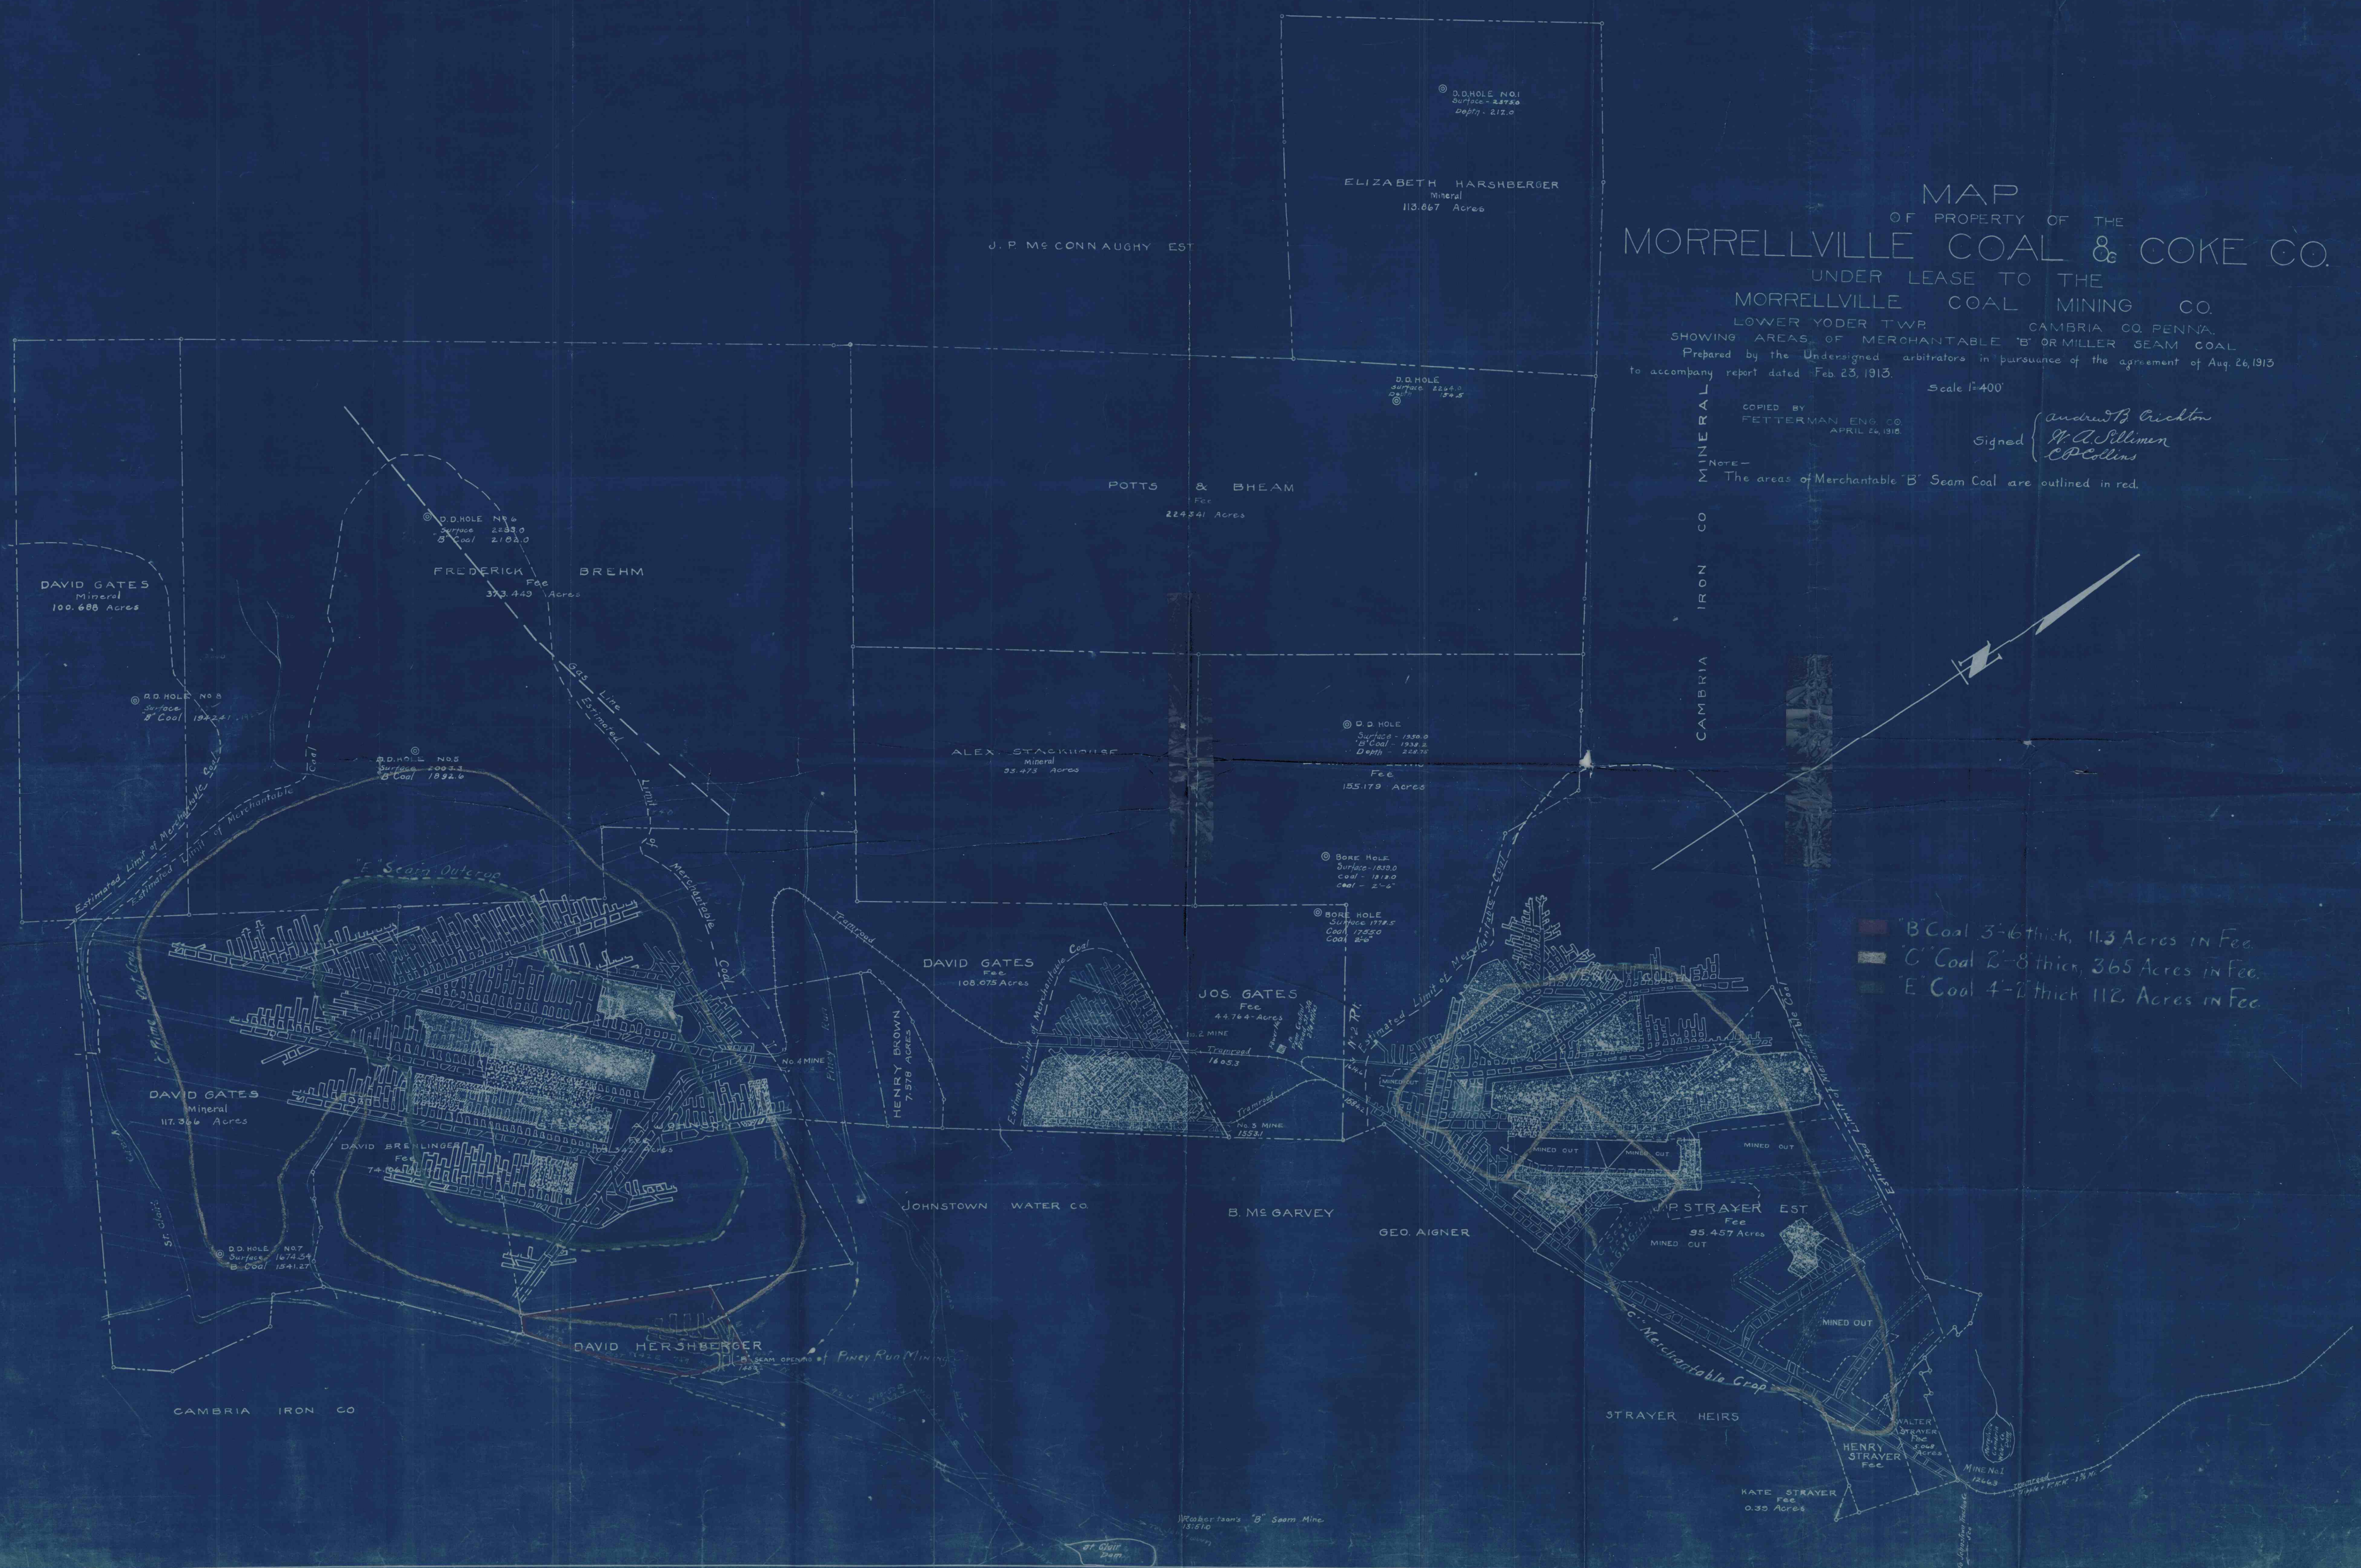

"B" Coal 3-6 thick, 11.3 Acres in Fee.
"C" Coal 2-8 thick, 365 Acres in Fee.
"E" Coal 4-7 thick, 112 Acres in Fee.