#348
6-10-1
CC
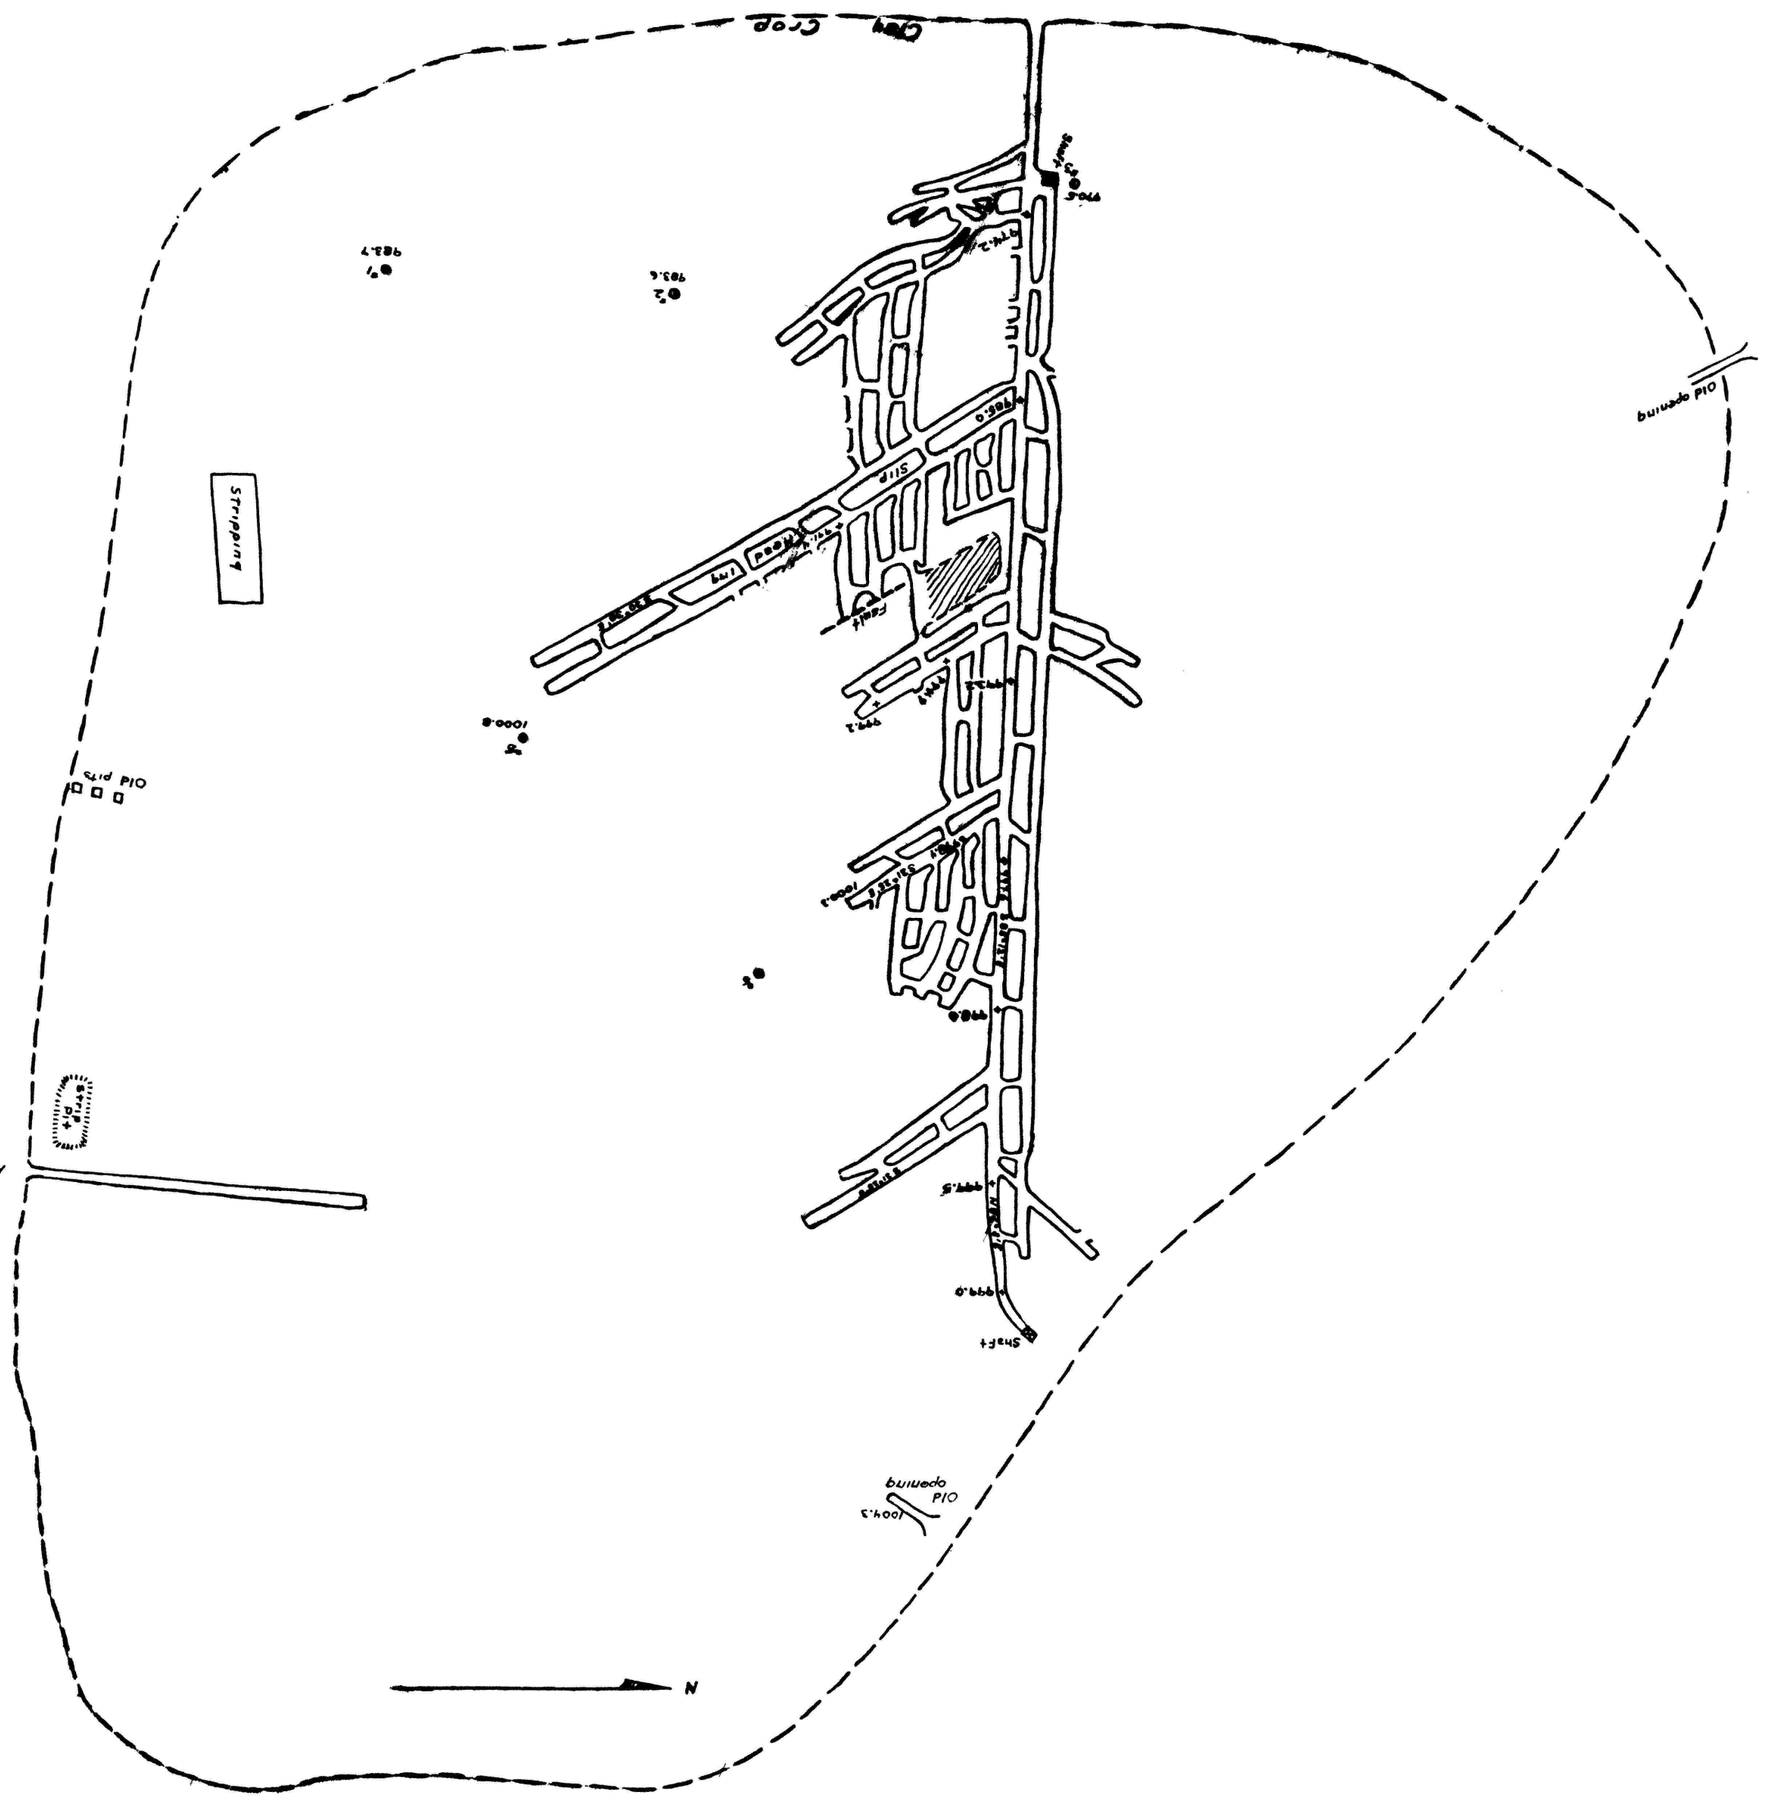
BIRGE RUN MINE (Old Shaw-Fuller Ref Co. prop.)
General Refractories Co
100 Feet 300