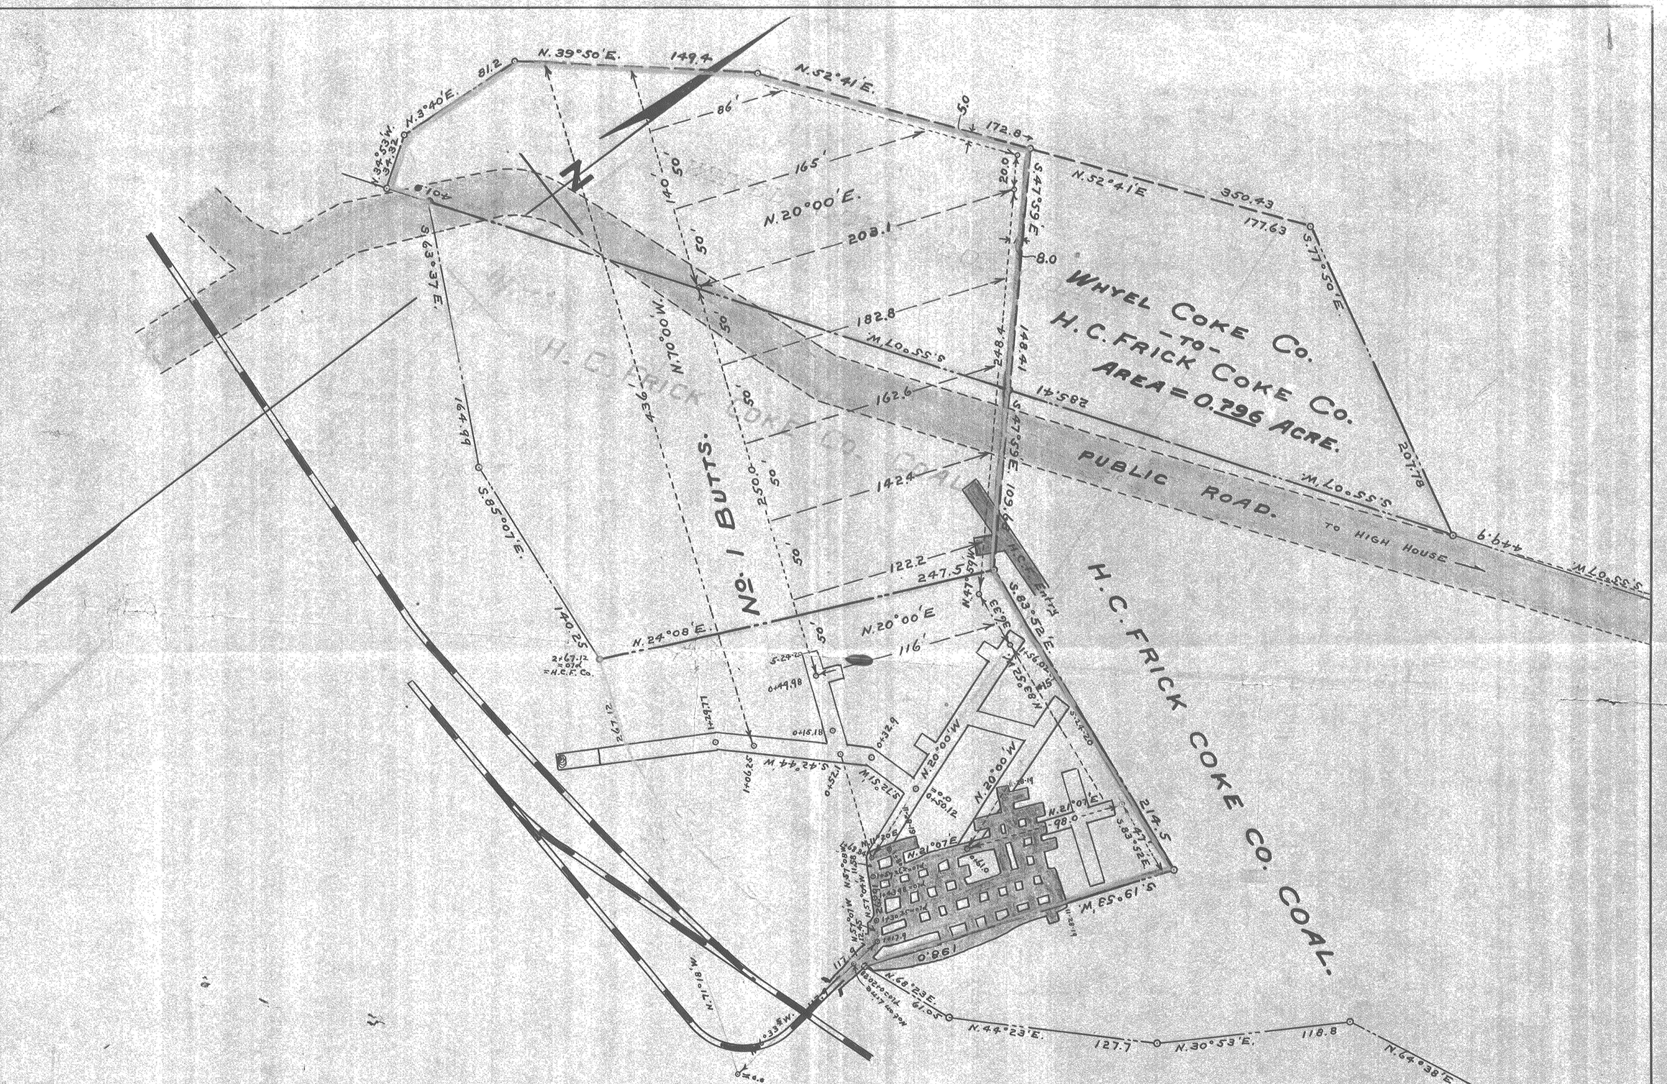

BLUE ROCK No. 2 MINE

WHYEL COKE COMPANY

SITUATE IN

NICHOLSON TOWNSHIP, FAYETTE CO., PA.

SCALE: 1" = 50' — DEC. 4, 1919.

F. E. Co.