DATE OF SURVEY.
JAN. 1, 1918 = A.
APR. 11, " = B.
AUG. 11, 1919 = C.

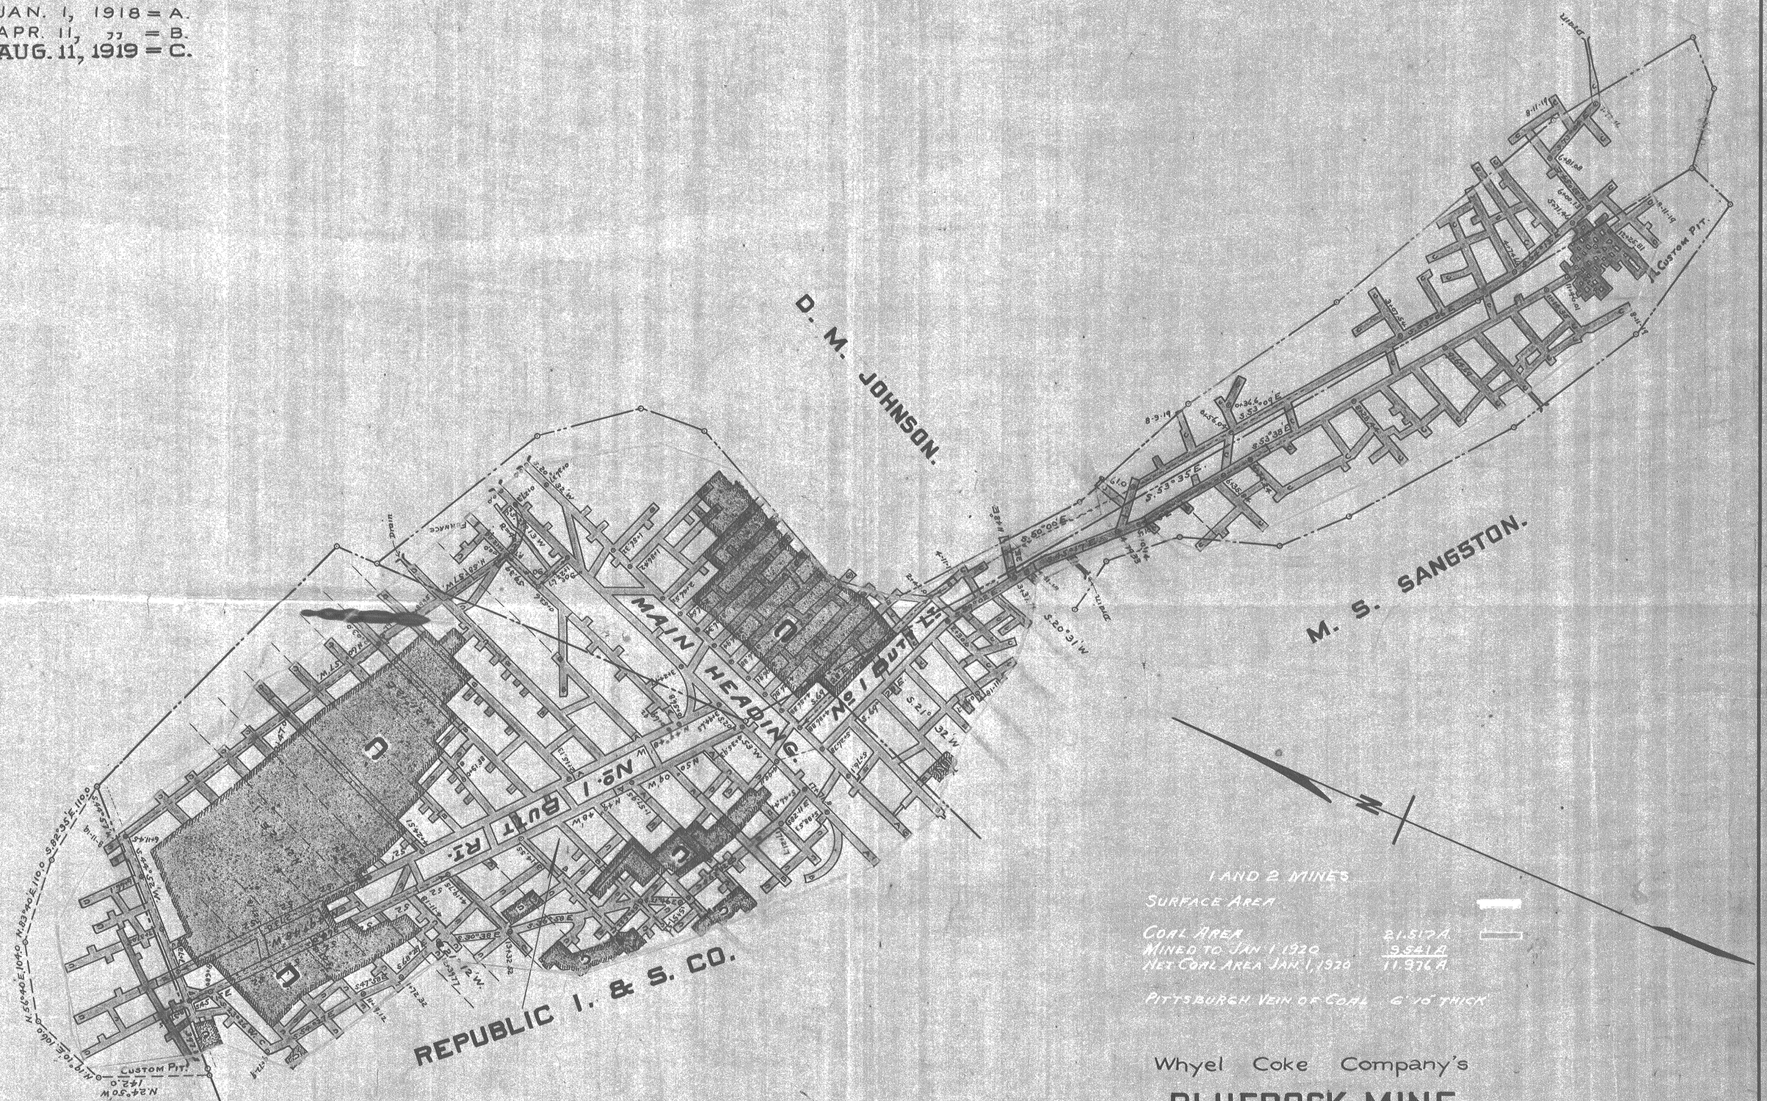

Whyel Coke Company's

BLUEROCK MINE

Situate in Nicholson Twp., Fayette Co., Penna.

Scale:- 1"=100'-0" April 25, 1918.

W.R.C.
F.R.C.