


DATE OF SURVEY.
 JAN. 1, 1918 = A.
 APR. 11, 1919 = B.
 AUG. 11, 1919 = C.

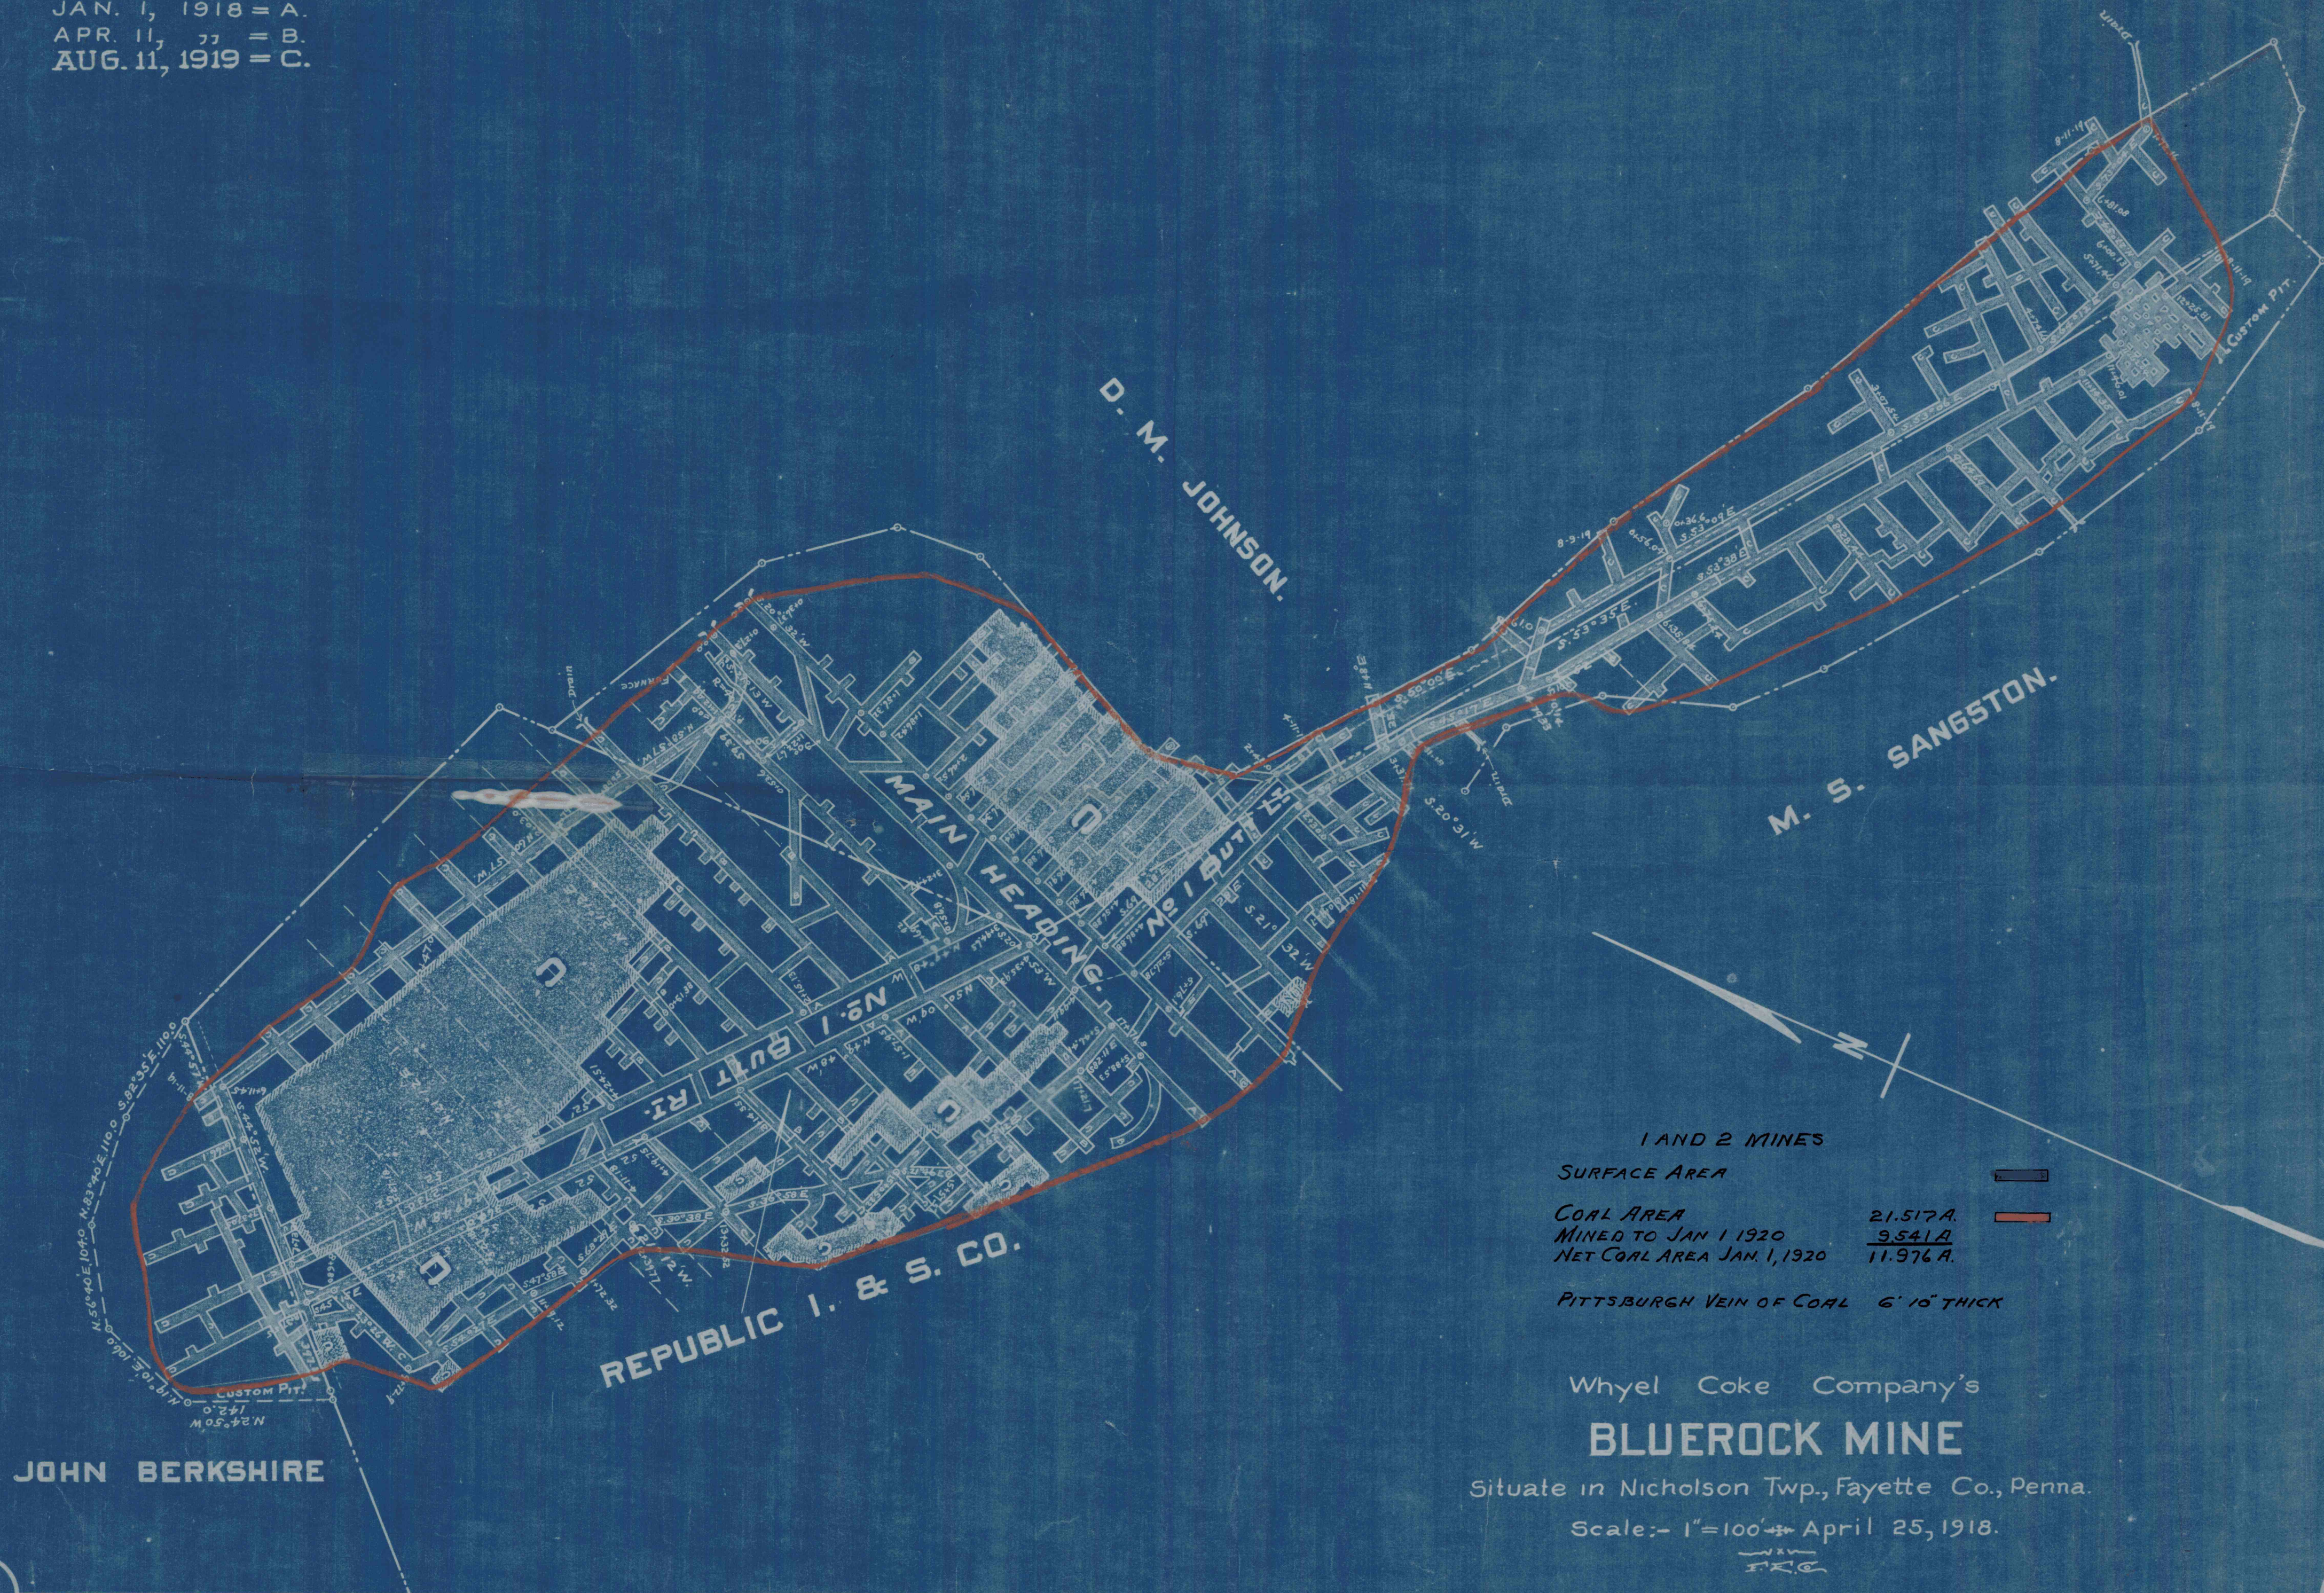

1 AND 2 MINES
 SURFACE AREA
 COAL AREA 21.517 A.
 MINED TO JAN 1 1920 9.541 A.
 NET COAL AREA JAN. 1, 1920 11.976 A.
 PITTSBURGH VEIN OF COAL 6' 10" THICK

Whyel Coke Company's
BLUEROCK MINE
 Situate in Nicholson Twp., Fayette Co., Penna.
 Scale:- 1"=100' April 25, 1918.

JOHN BERKSHIRE