


W. H. Connell & Co. Coal Co.
 Fayette County

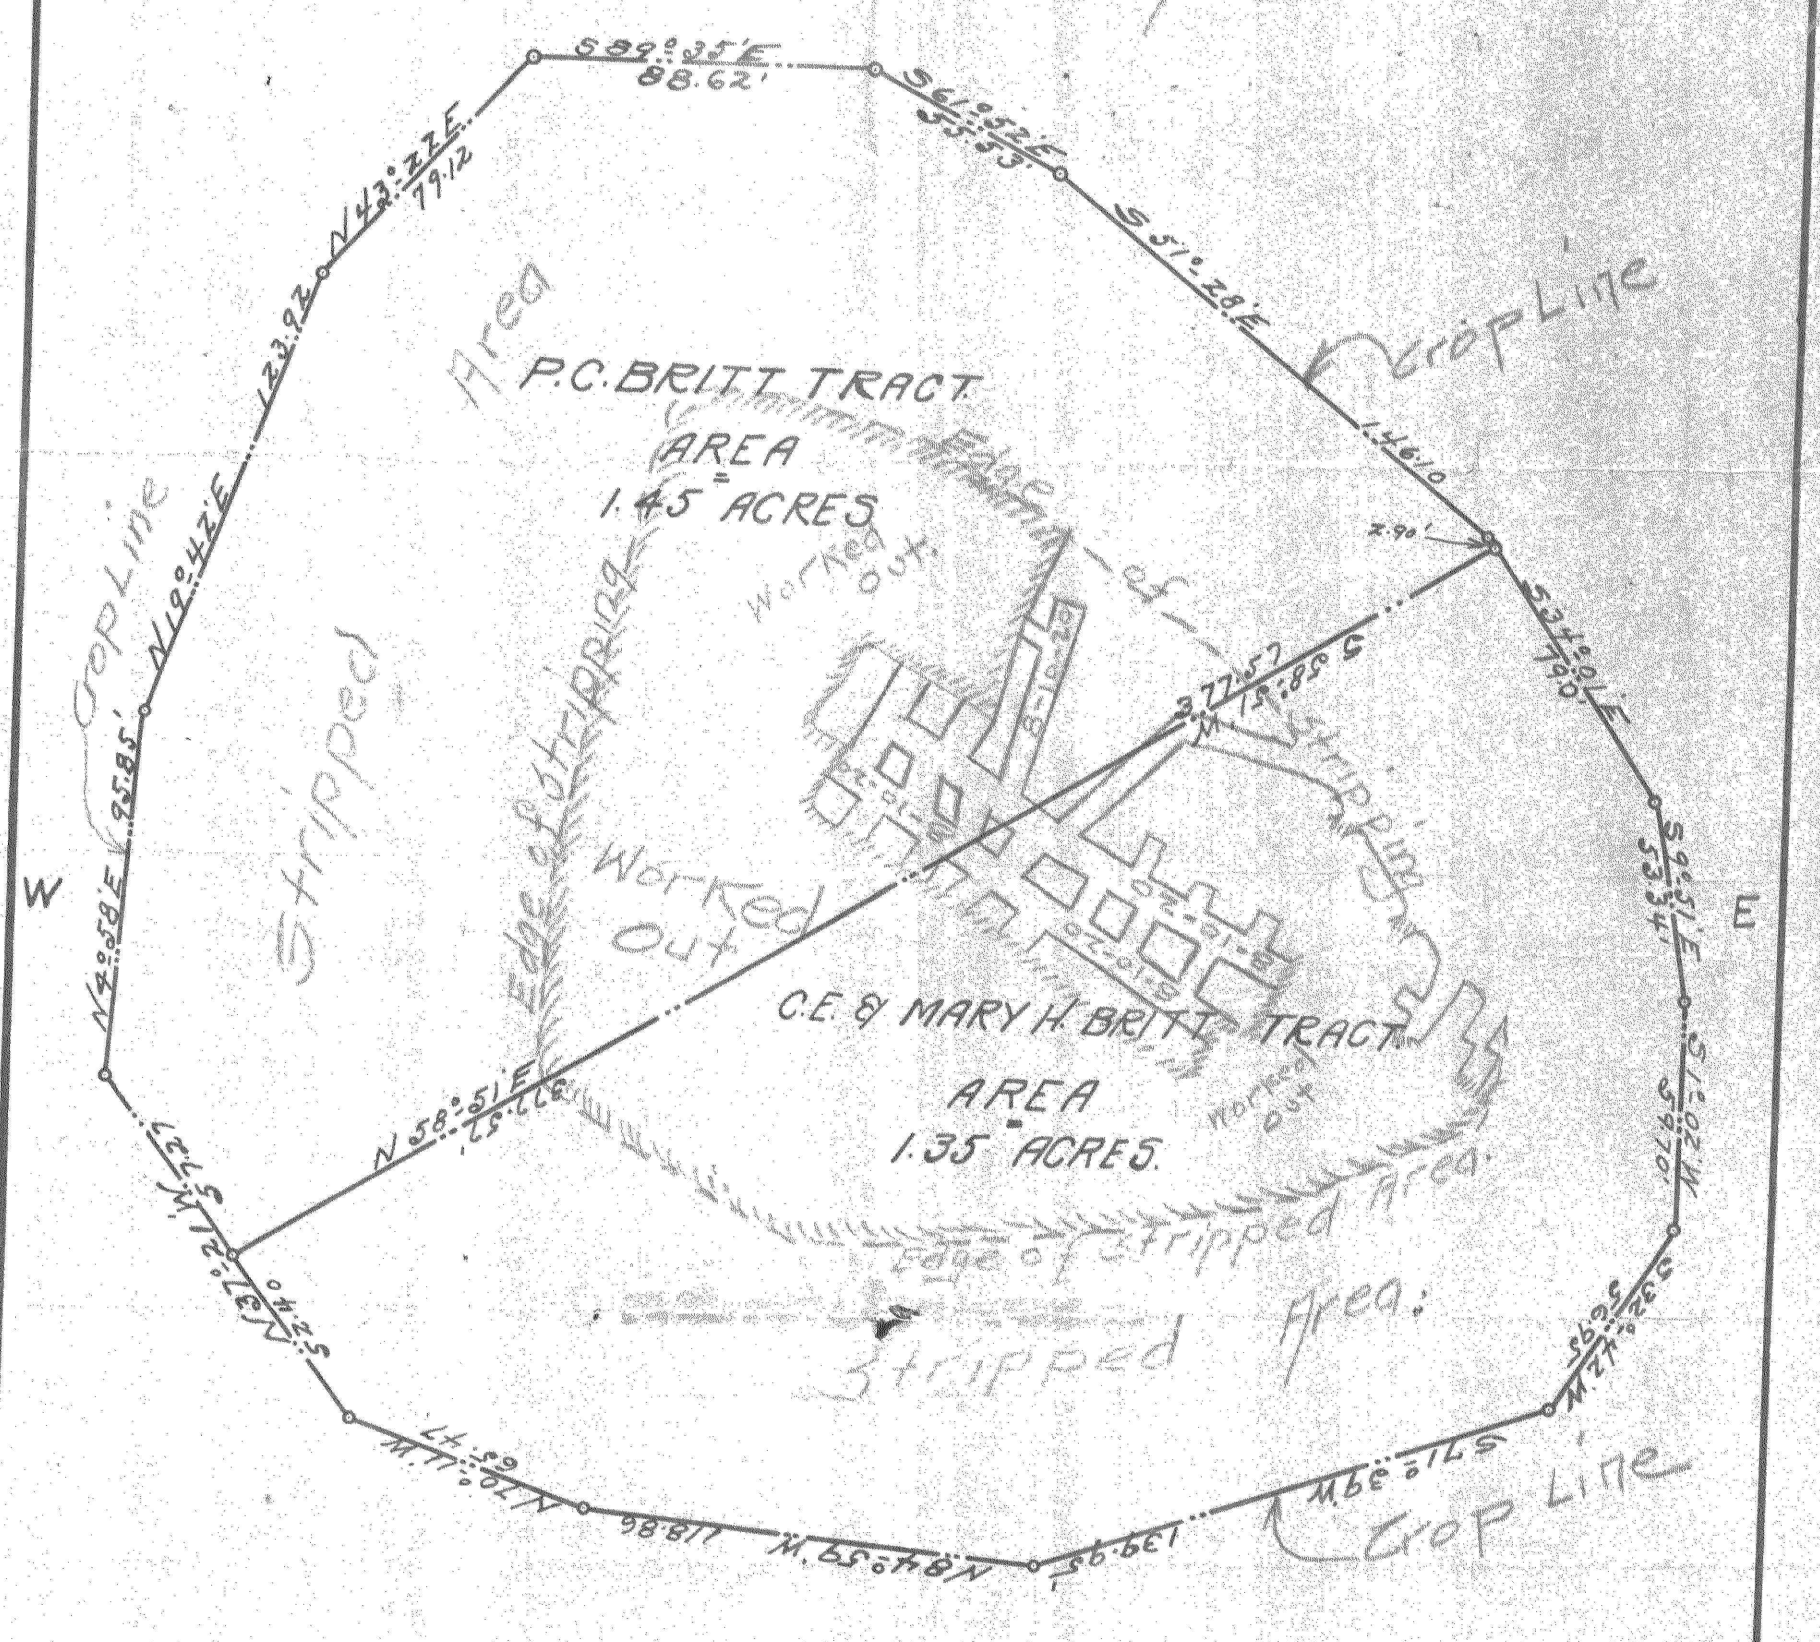

This Work of Coal is located about 1 1/4 miles from Smithfield toward Fairchance on Morgantown Road and about 300 ft SE of Road.