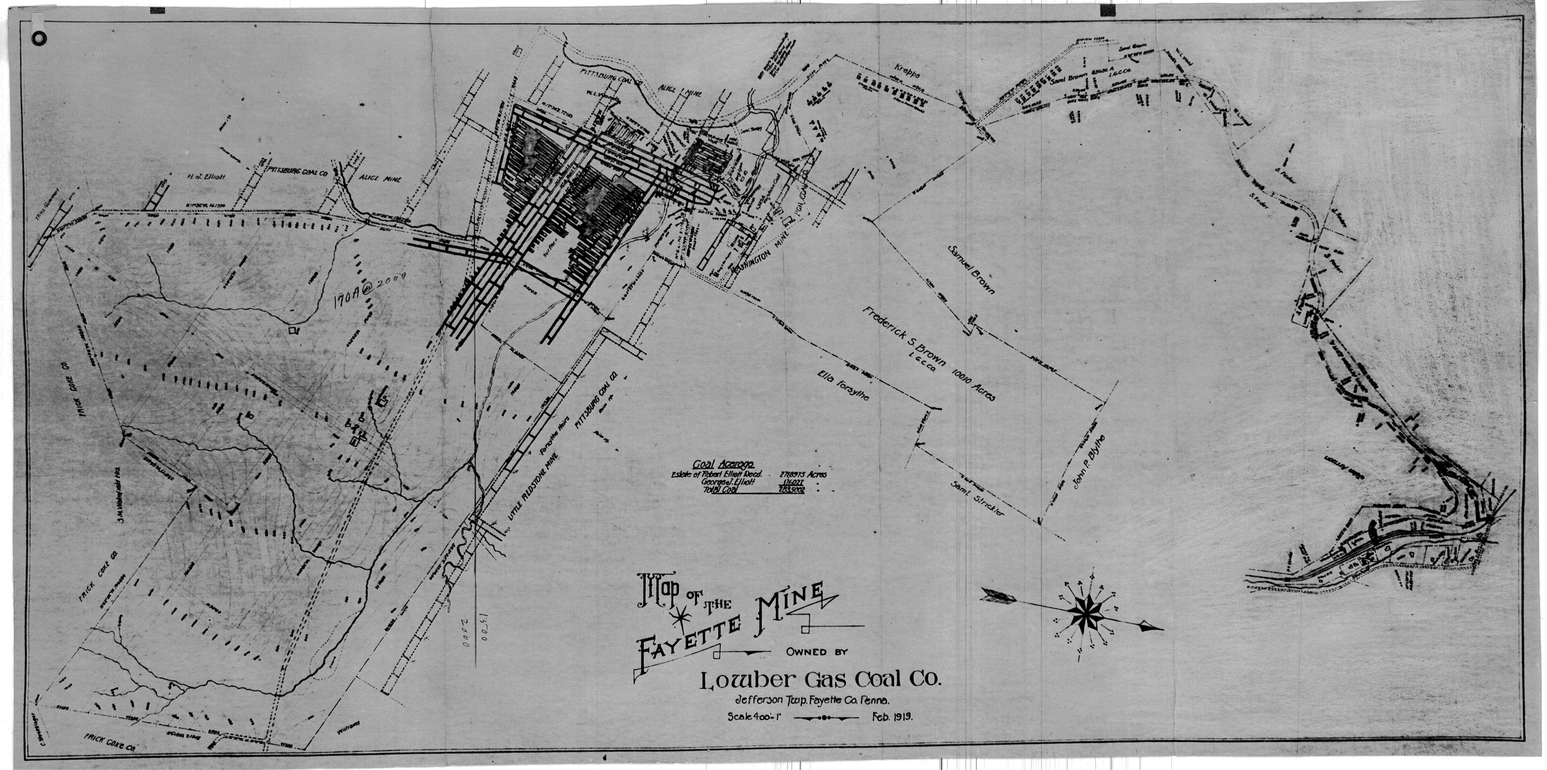

Map of the
Fayette Mine
Owned by
Lowber Gas Coal Co.
Jefferson Twp. Fayette Co. Penna.
Scale 400-1"
Feb. 1919.
Coal Acreage
Estate of Robert Elliott Decd.
George E. Elliott
Total Coal
1704 15/100 Acres
Under
Water
Pittsburg Coal Co
Alice Mine
Frick Coke Co
Little Pleasant Mine
Samuel Brown
Frederick S. Brown
Leased
1000 Acres
Ella Forsythe
Saint Sinclair
John P. Blythe