


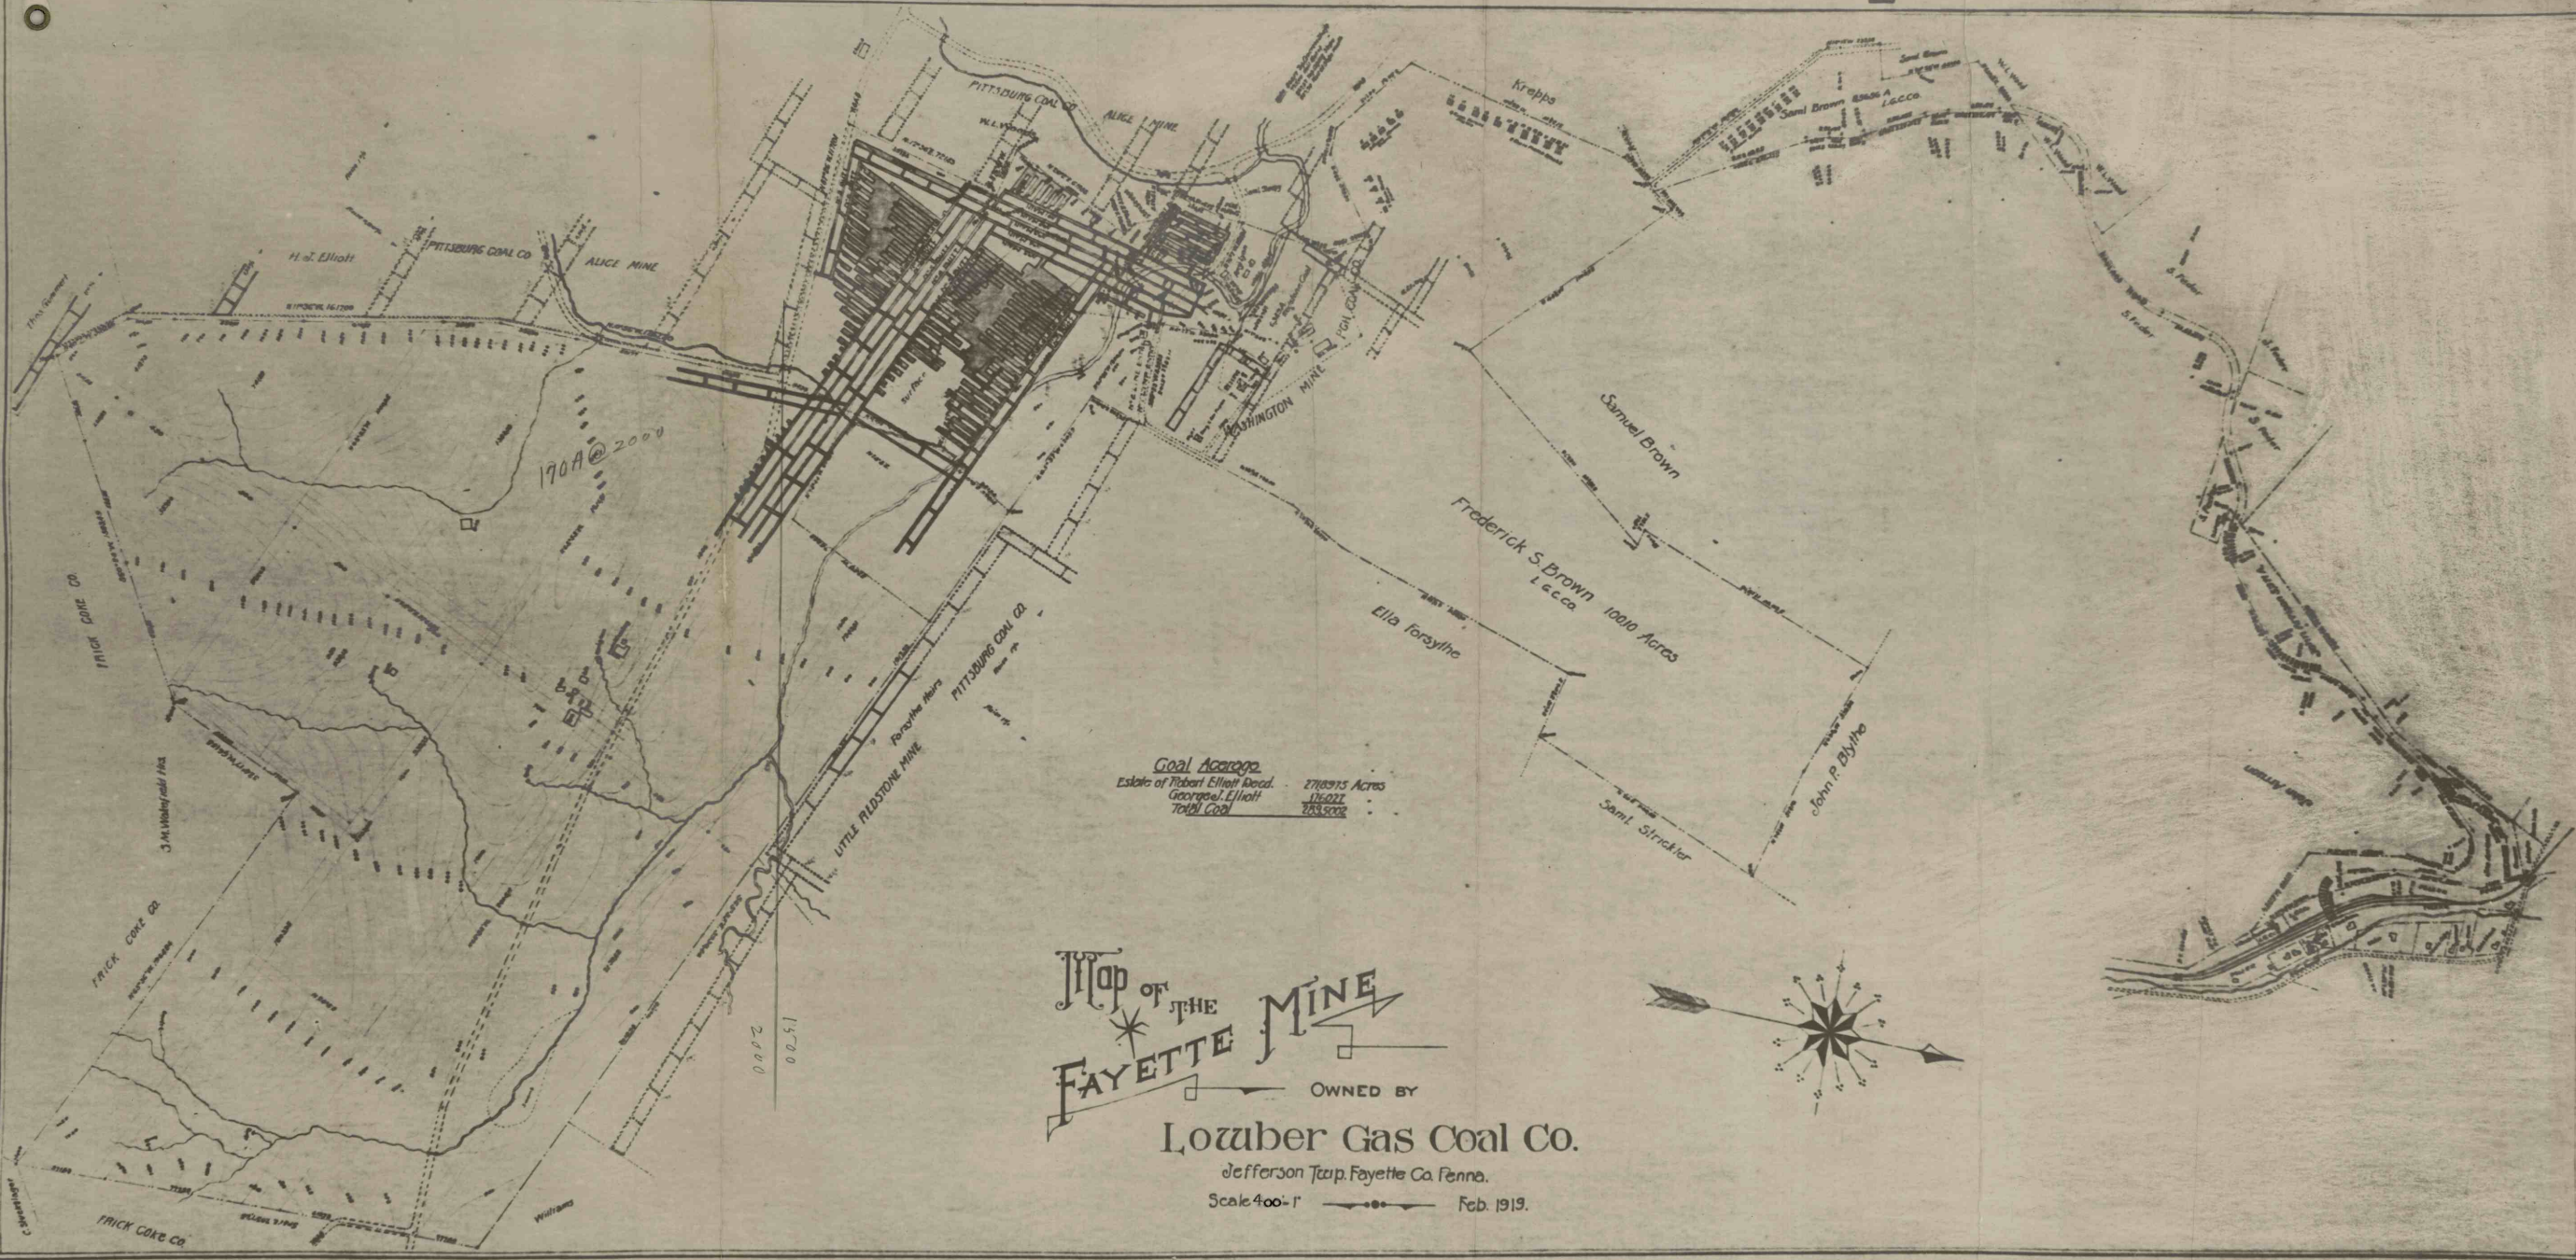

Coal Acarage
Estate of Robert Elliott Dead.
Georgel Elliott
TOTAL COAL

278315 Acres
176,027
283,502

Map of THE FAYETTE MINE

OWNED BY

Lozuber Gas Coal Co.

Jefferson Twp. Fayette Co. Penna.

Scale 400'-1" Feb. 1919.

