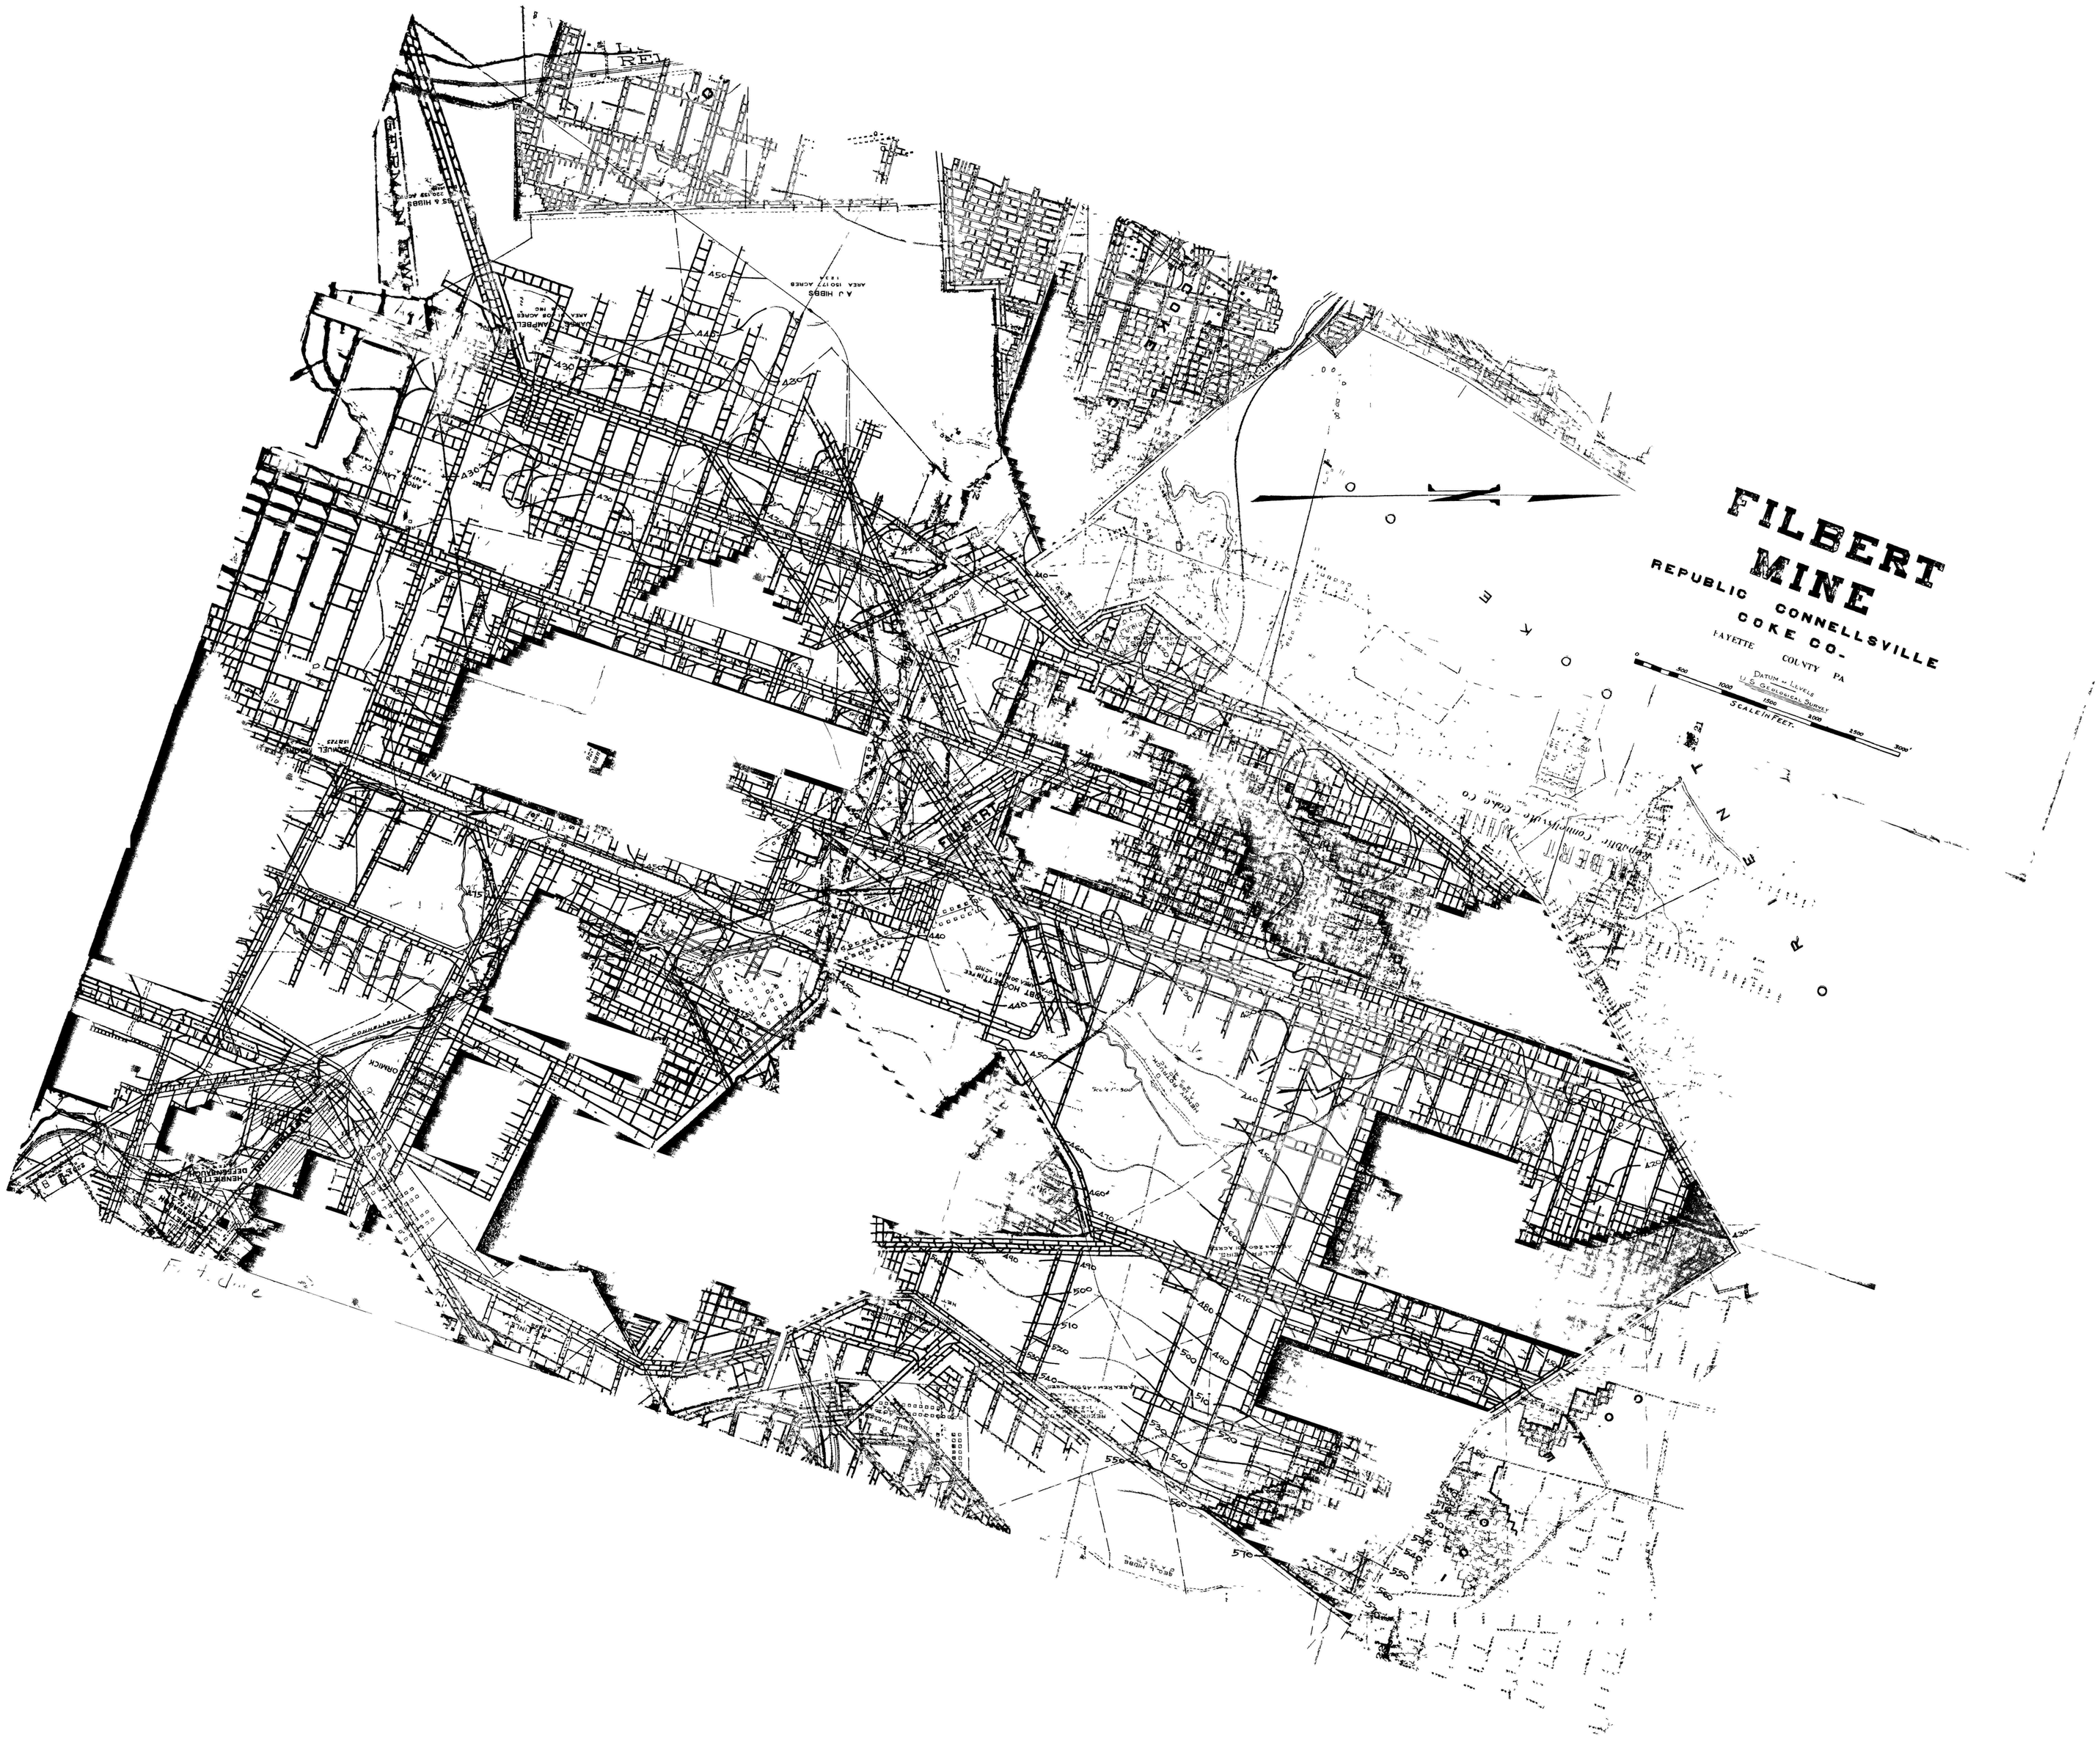
FILBERT
MINE
REPUBLIC CONNELLSVILLE
COKE CO-
FAYETTE COUNTY PA
DATUM OF LEVELS
U.S. GEOLOGICAL SURVEY
SCALE IN FEET
0 500 1000 1500 2000 2500 3000
N
W
E
S
A J HIBBS
AREA 150.177 ACRES
FILBERT
ORNICK