


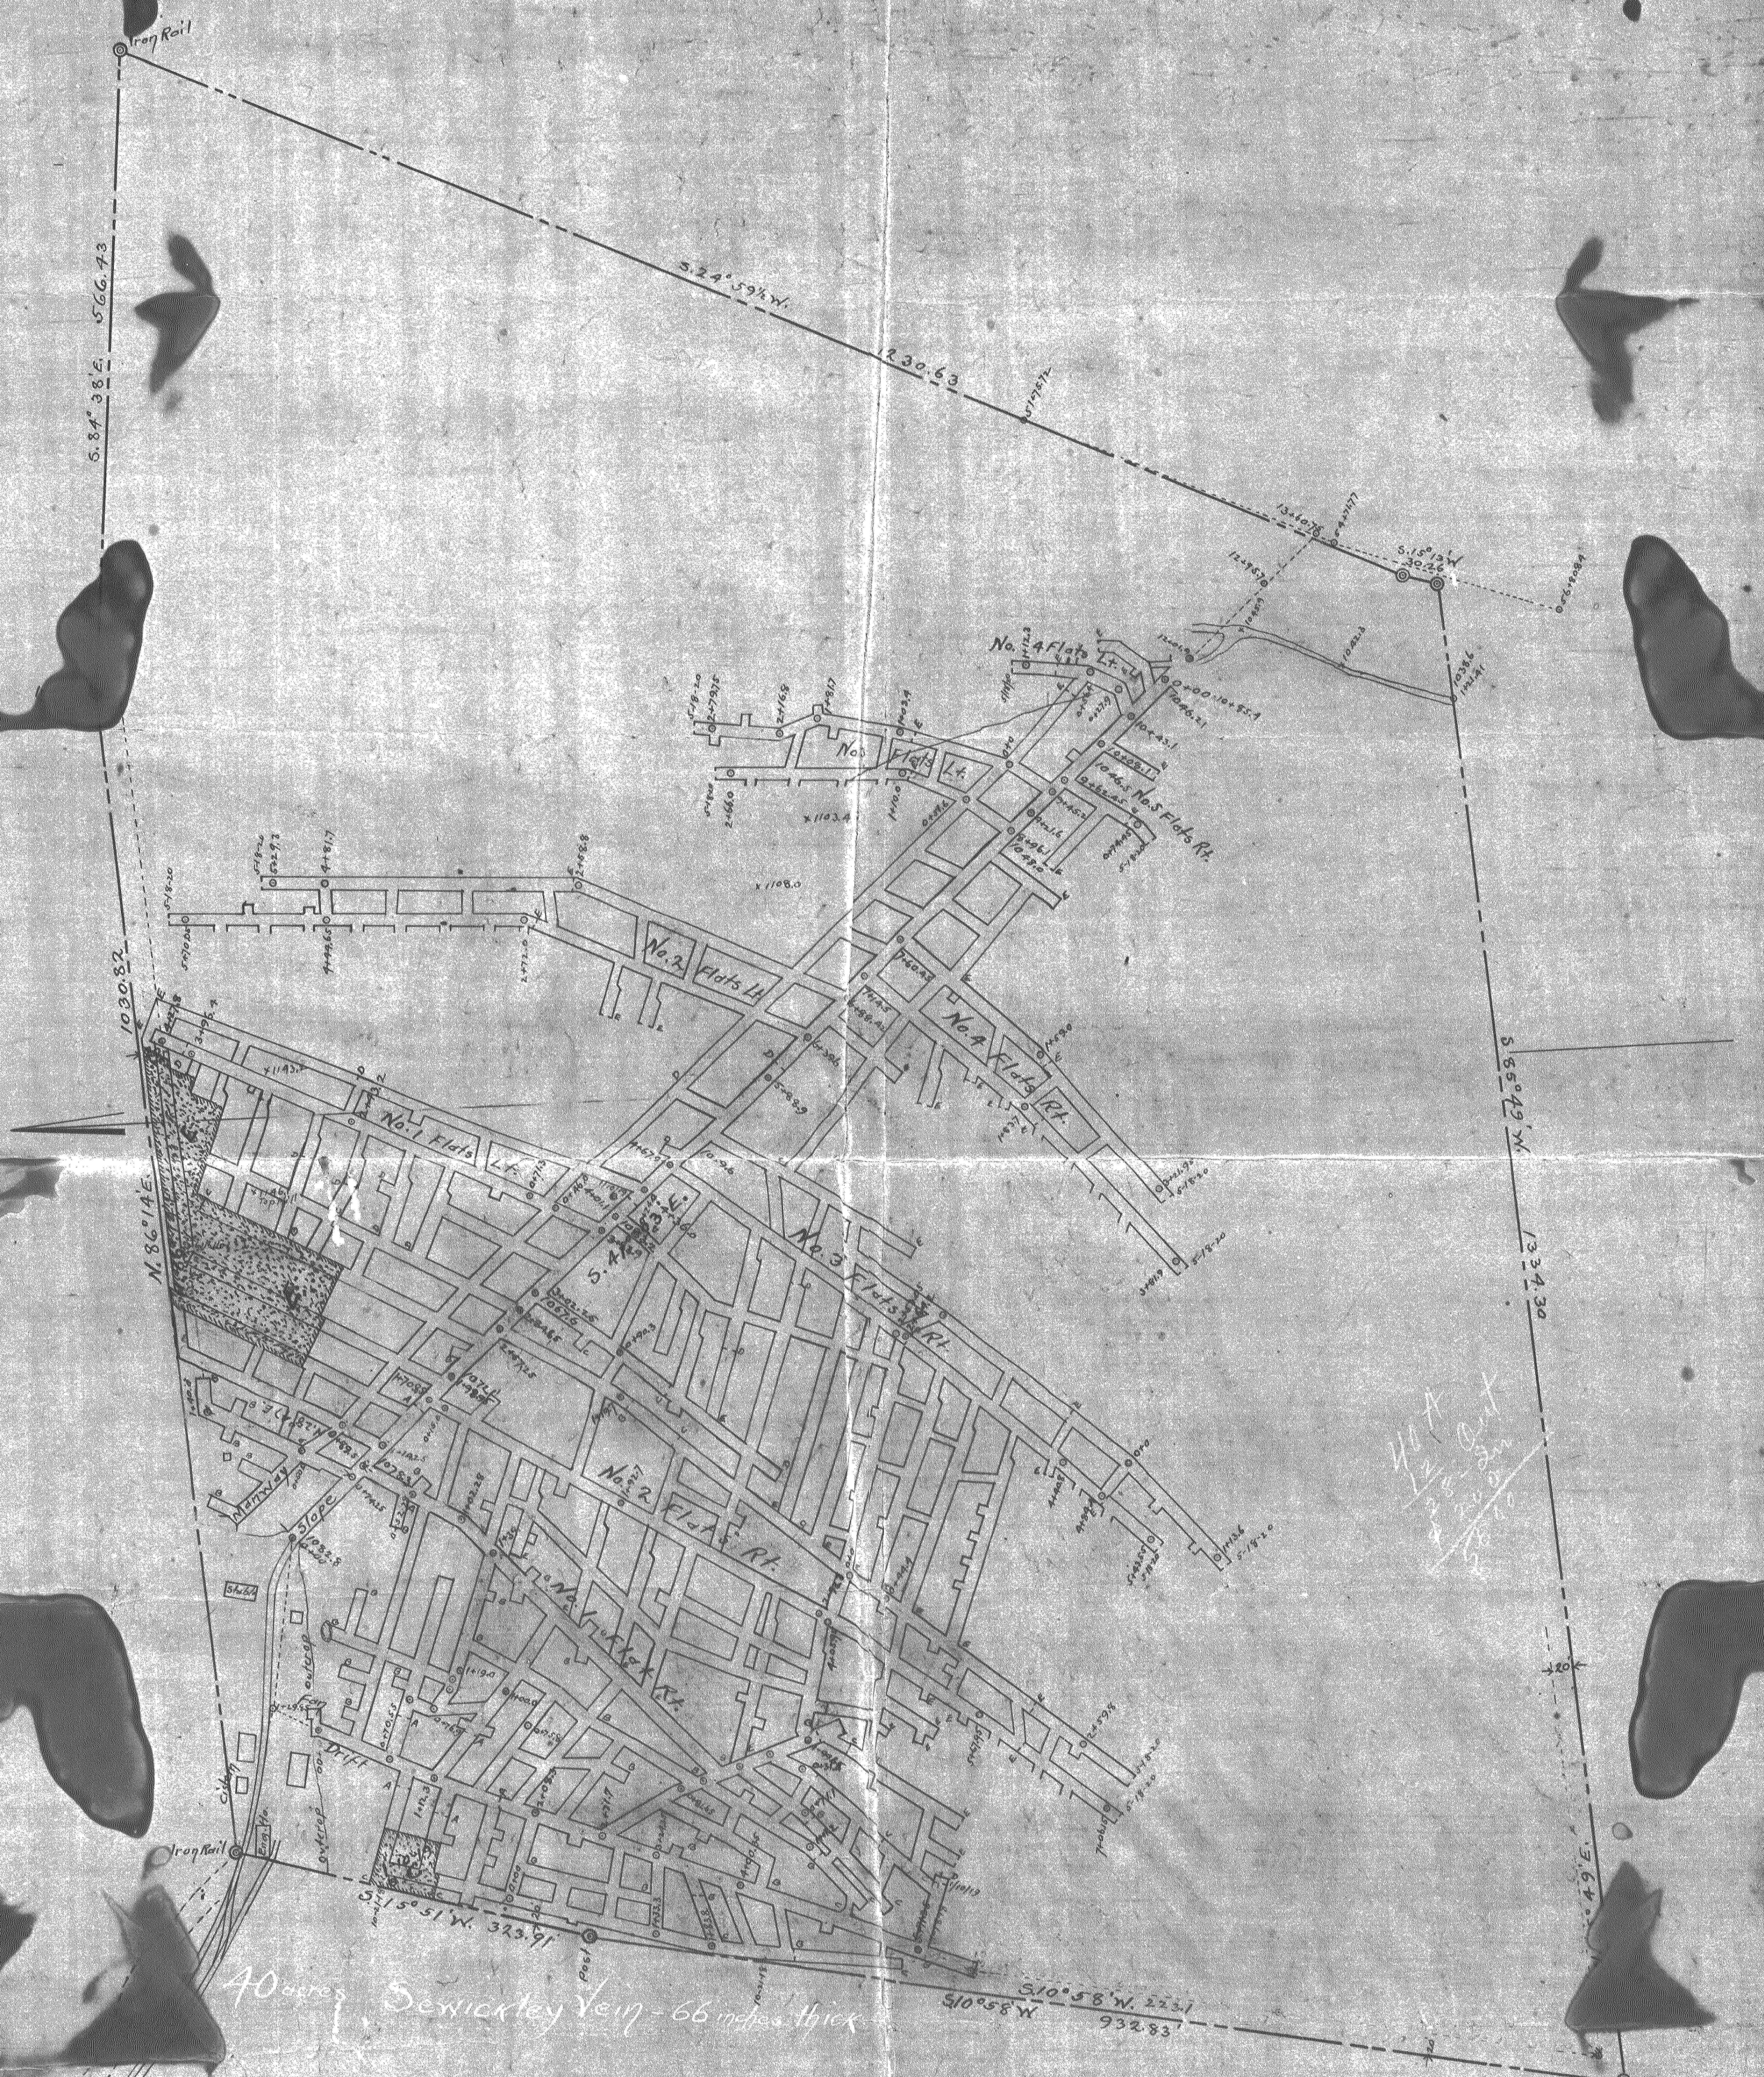

40 A
12
220.00
220.00
220.00
220.00

40 Acres Sewickley Vein - 66 inches thick

Project Map of
 Liberty Coal and Coke Co.
 Mine No. 1.
 Scale 1 in. = 100 ft. May 1918
 Uniontown, Pa. H. J. Huntzinger
 Georges Township - Fayette County

- A = May 15-1918
- B = Nov. 18-1918
- C = Feb. 25-1919
- D = July 28-1919
- E = Dec. 31-1919