


LOGAN COAL CO.  
MAP OF  
D'SEAM PROPERTY  
SHOWING No 6 & MINE

Scale 1"=400'  
Andrew D. Critchfield  
Mining Engineer  
Johnstown, Penn.  
Apr. 1915

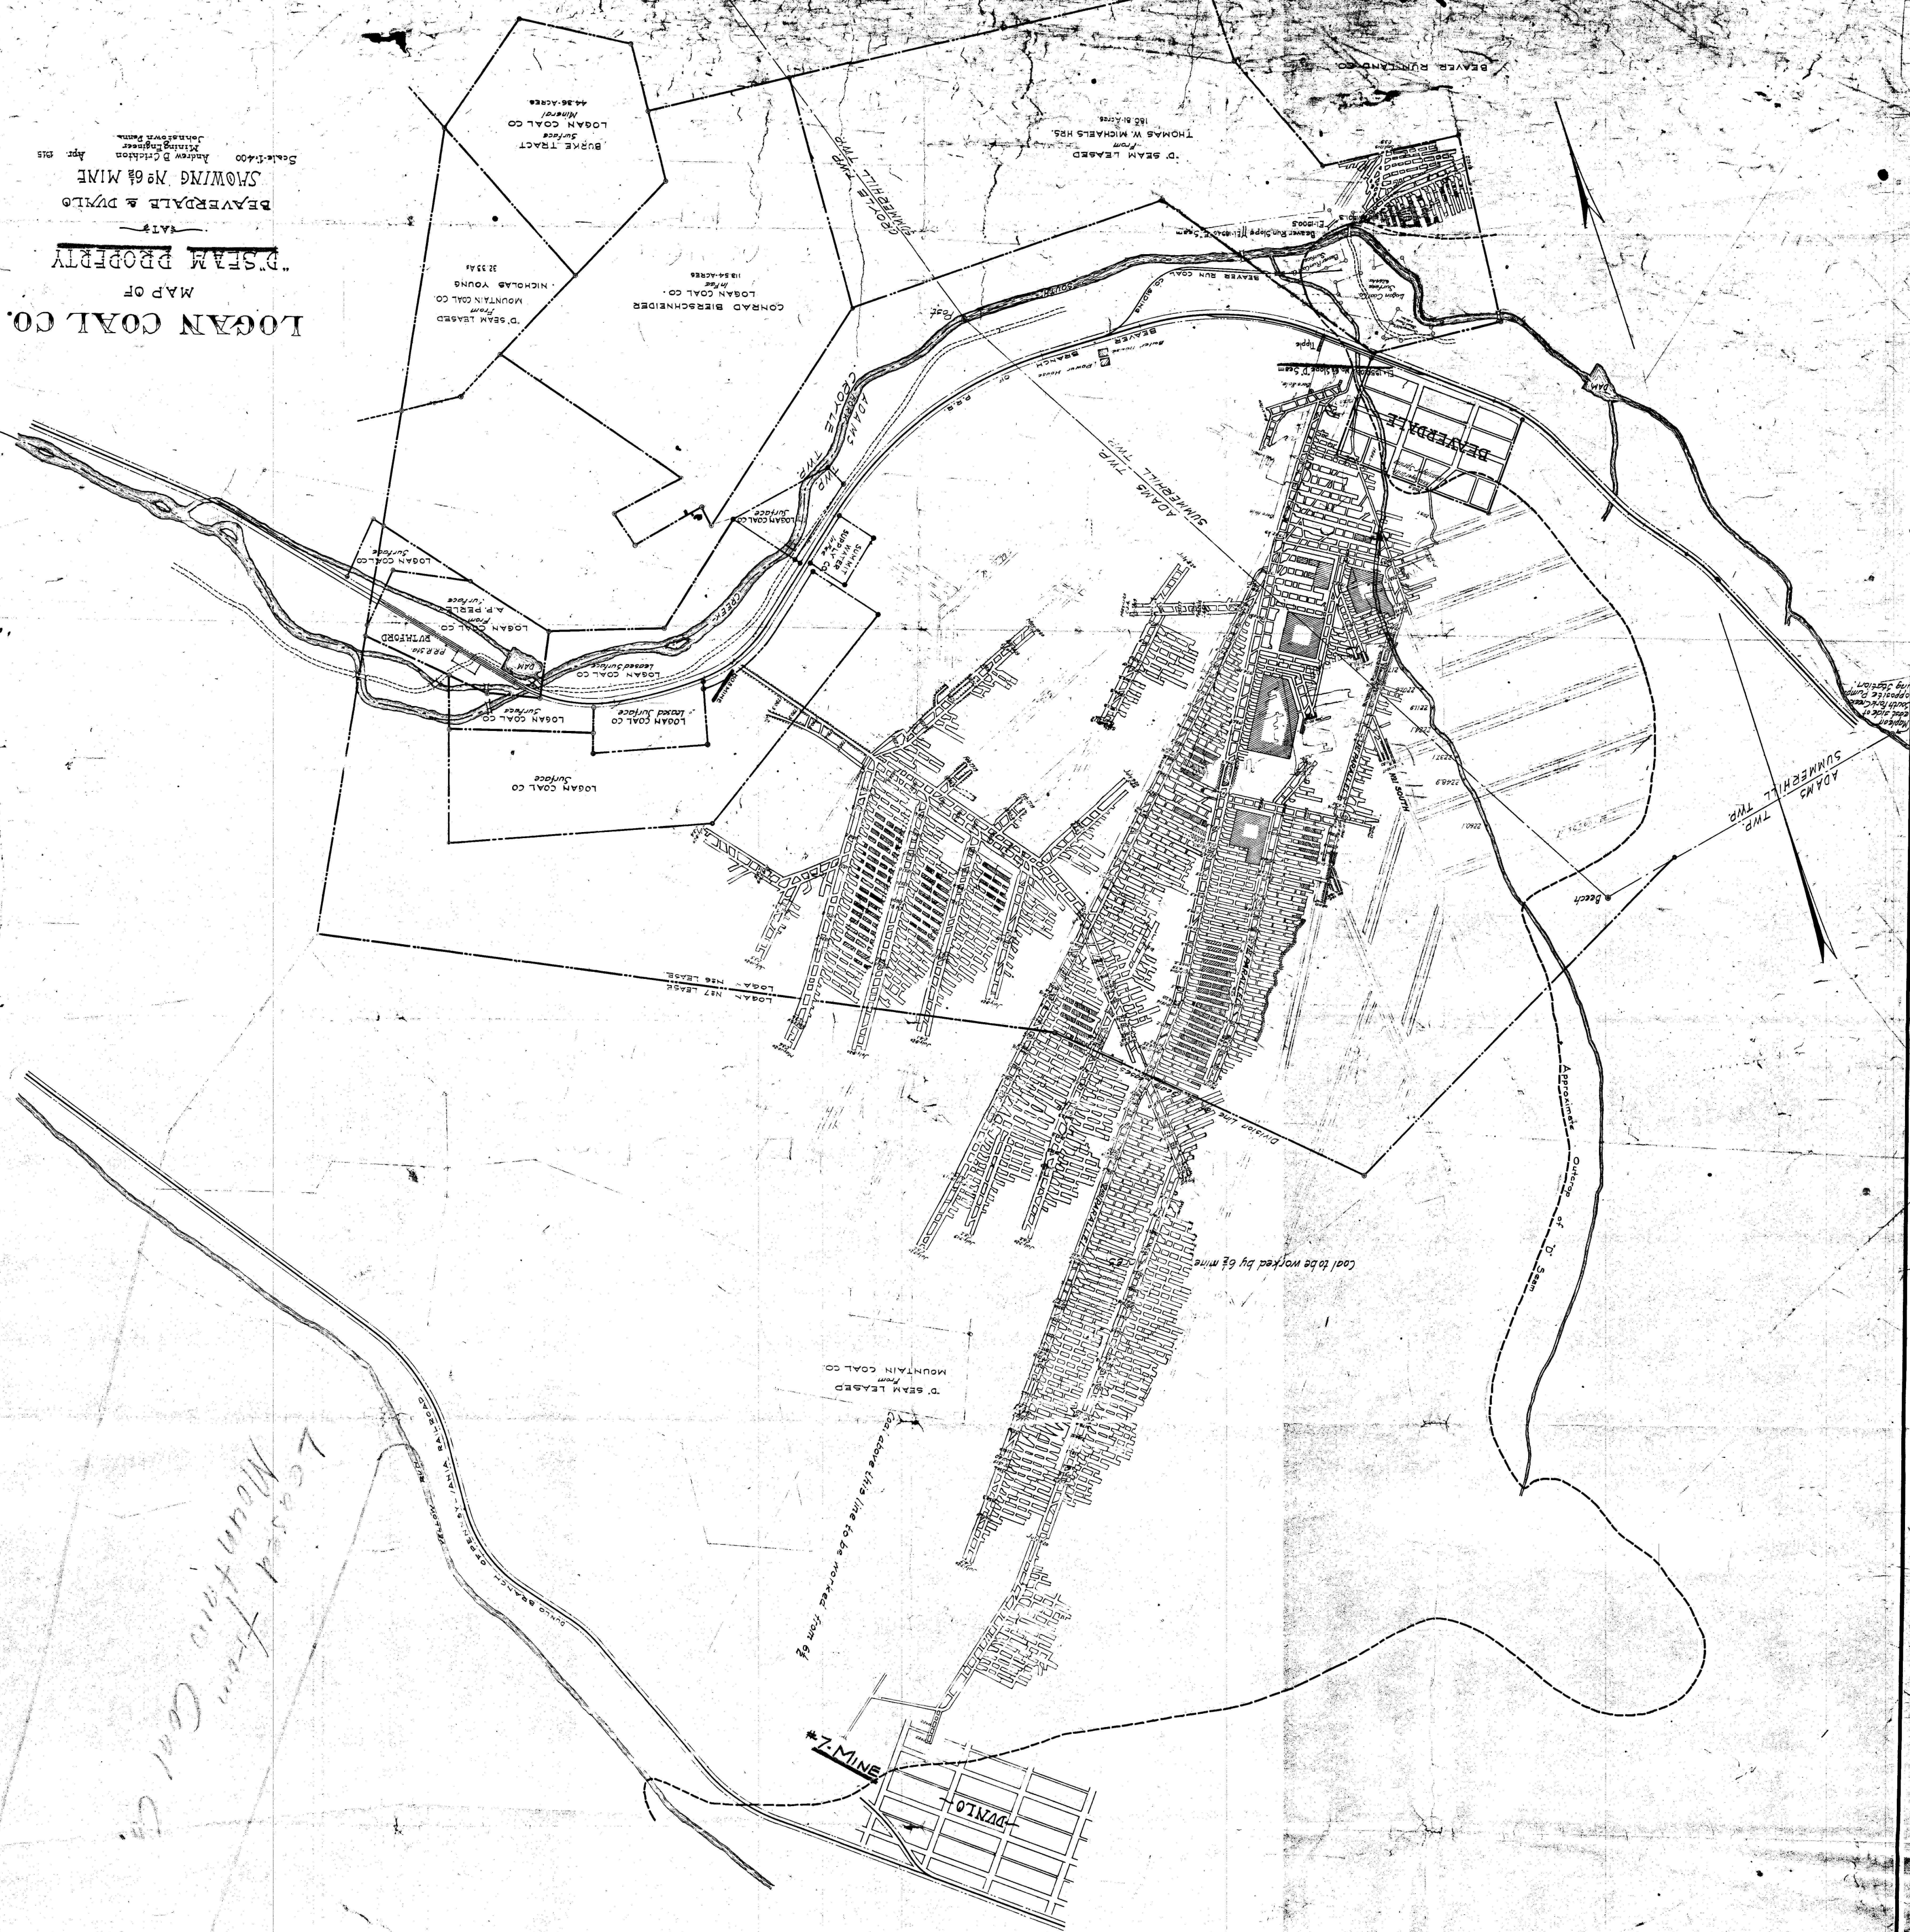

Leased from Coal Co.  
Mountain