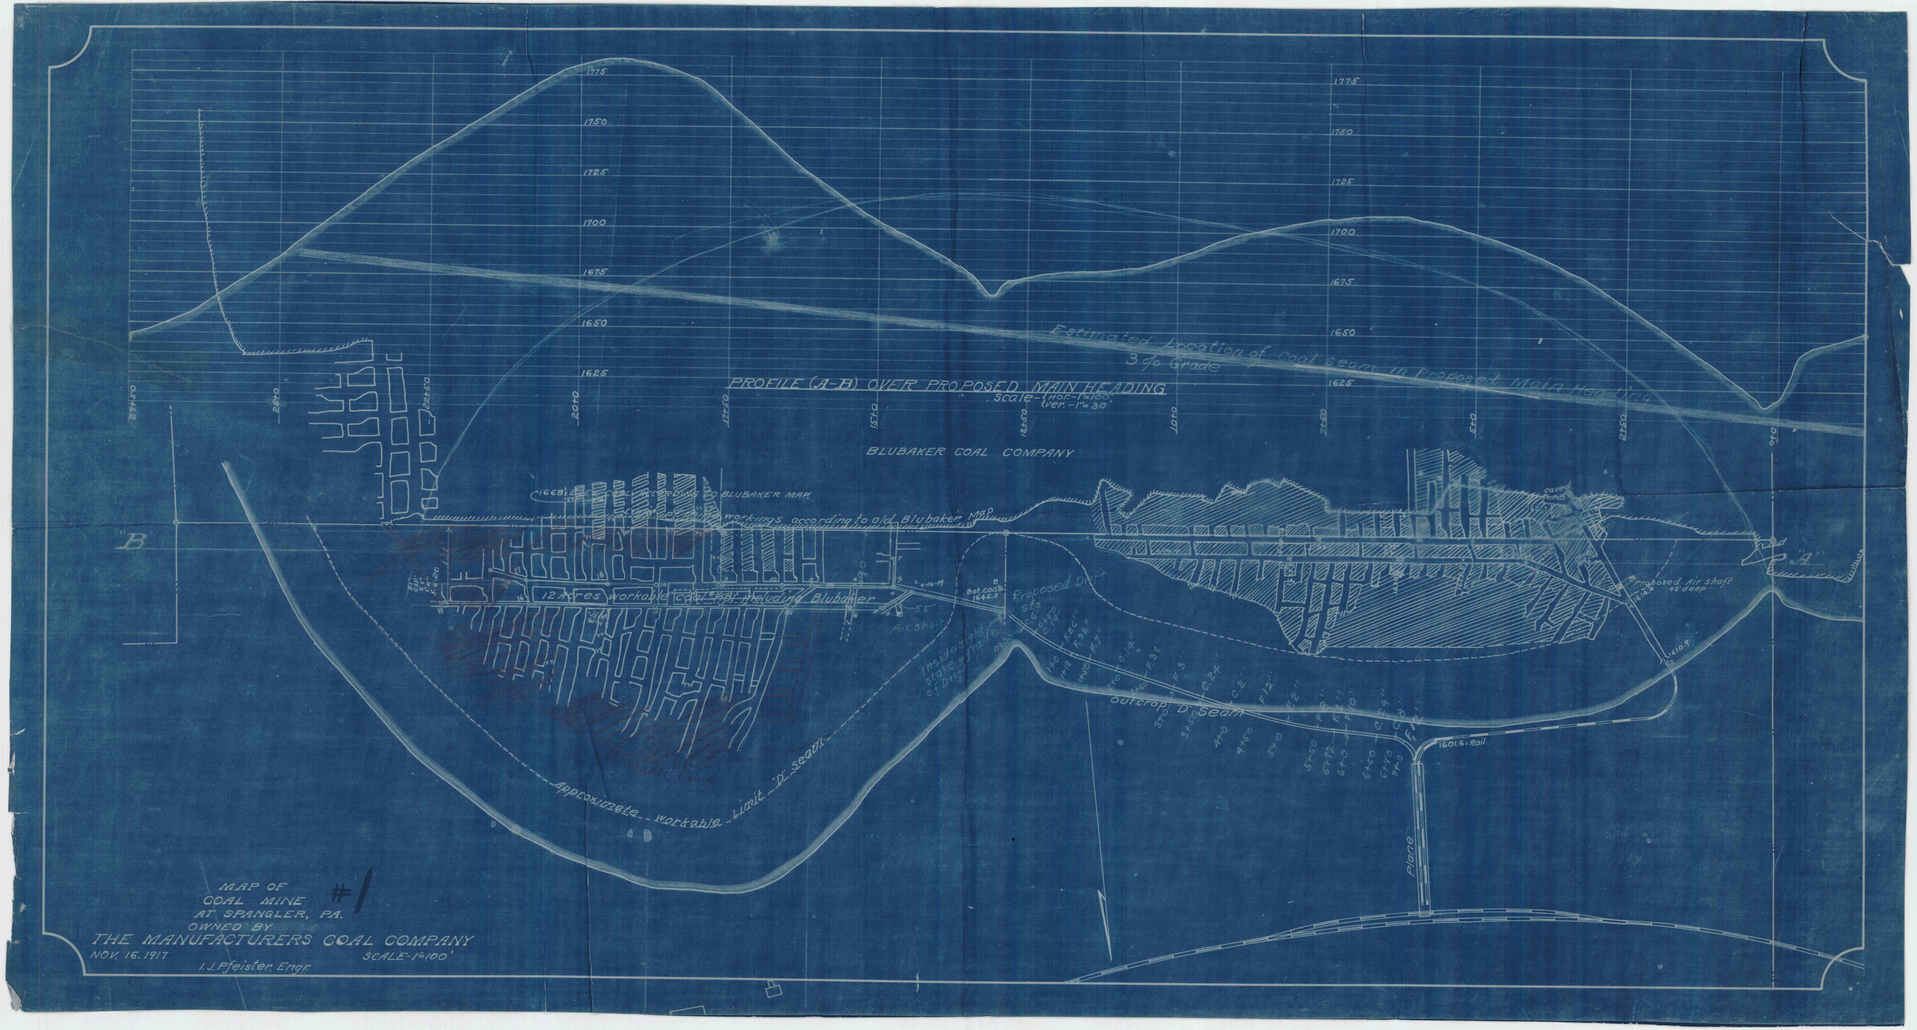
PROFILE (A-B) OVER PROPOSED MAIN HEADING
Scale-Hor.-1"=100'
Ver.-1"=30'
Estimated Location of Coal Seam in Proposed Main Heading
3% Grade
BLUBAKER COAL COMPANY
BLUBAKER MAP
Workings according to old Blubaker Map
12 Acres workable coal left holding Blubaker
Proposed Drift
Proposed Air Shaft
Outcrop D Seam
Approximate Workable Limit "D" Seam
Plane
MAP OF
COAL MINE
AT SPANGLER, PA.
OWNED BY
THE MANUFACTURERS COAL COMPANY
NOV. 16. 1917
I. J. Pfeister, Engr.
SCALE-1"=100'