
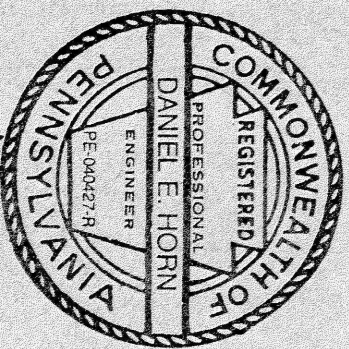


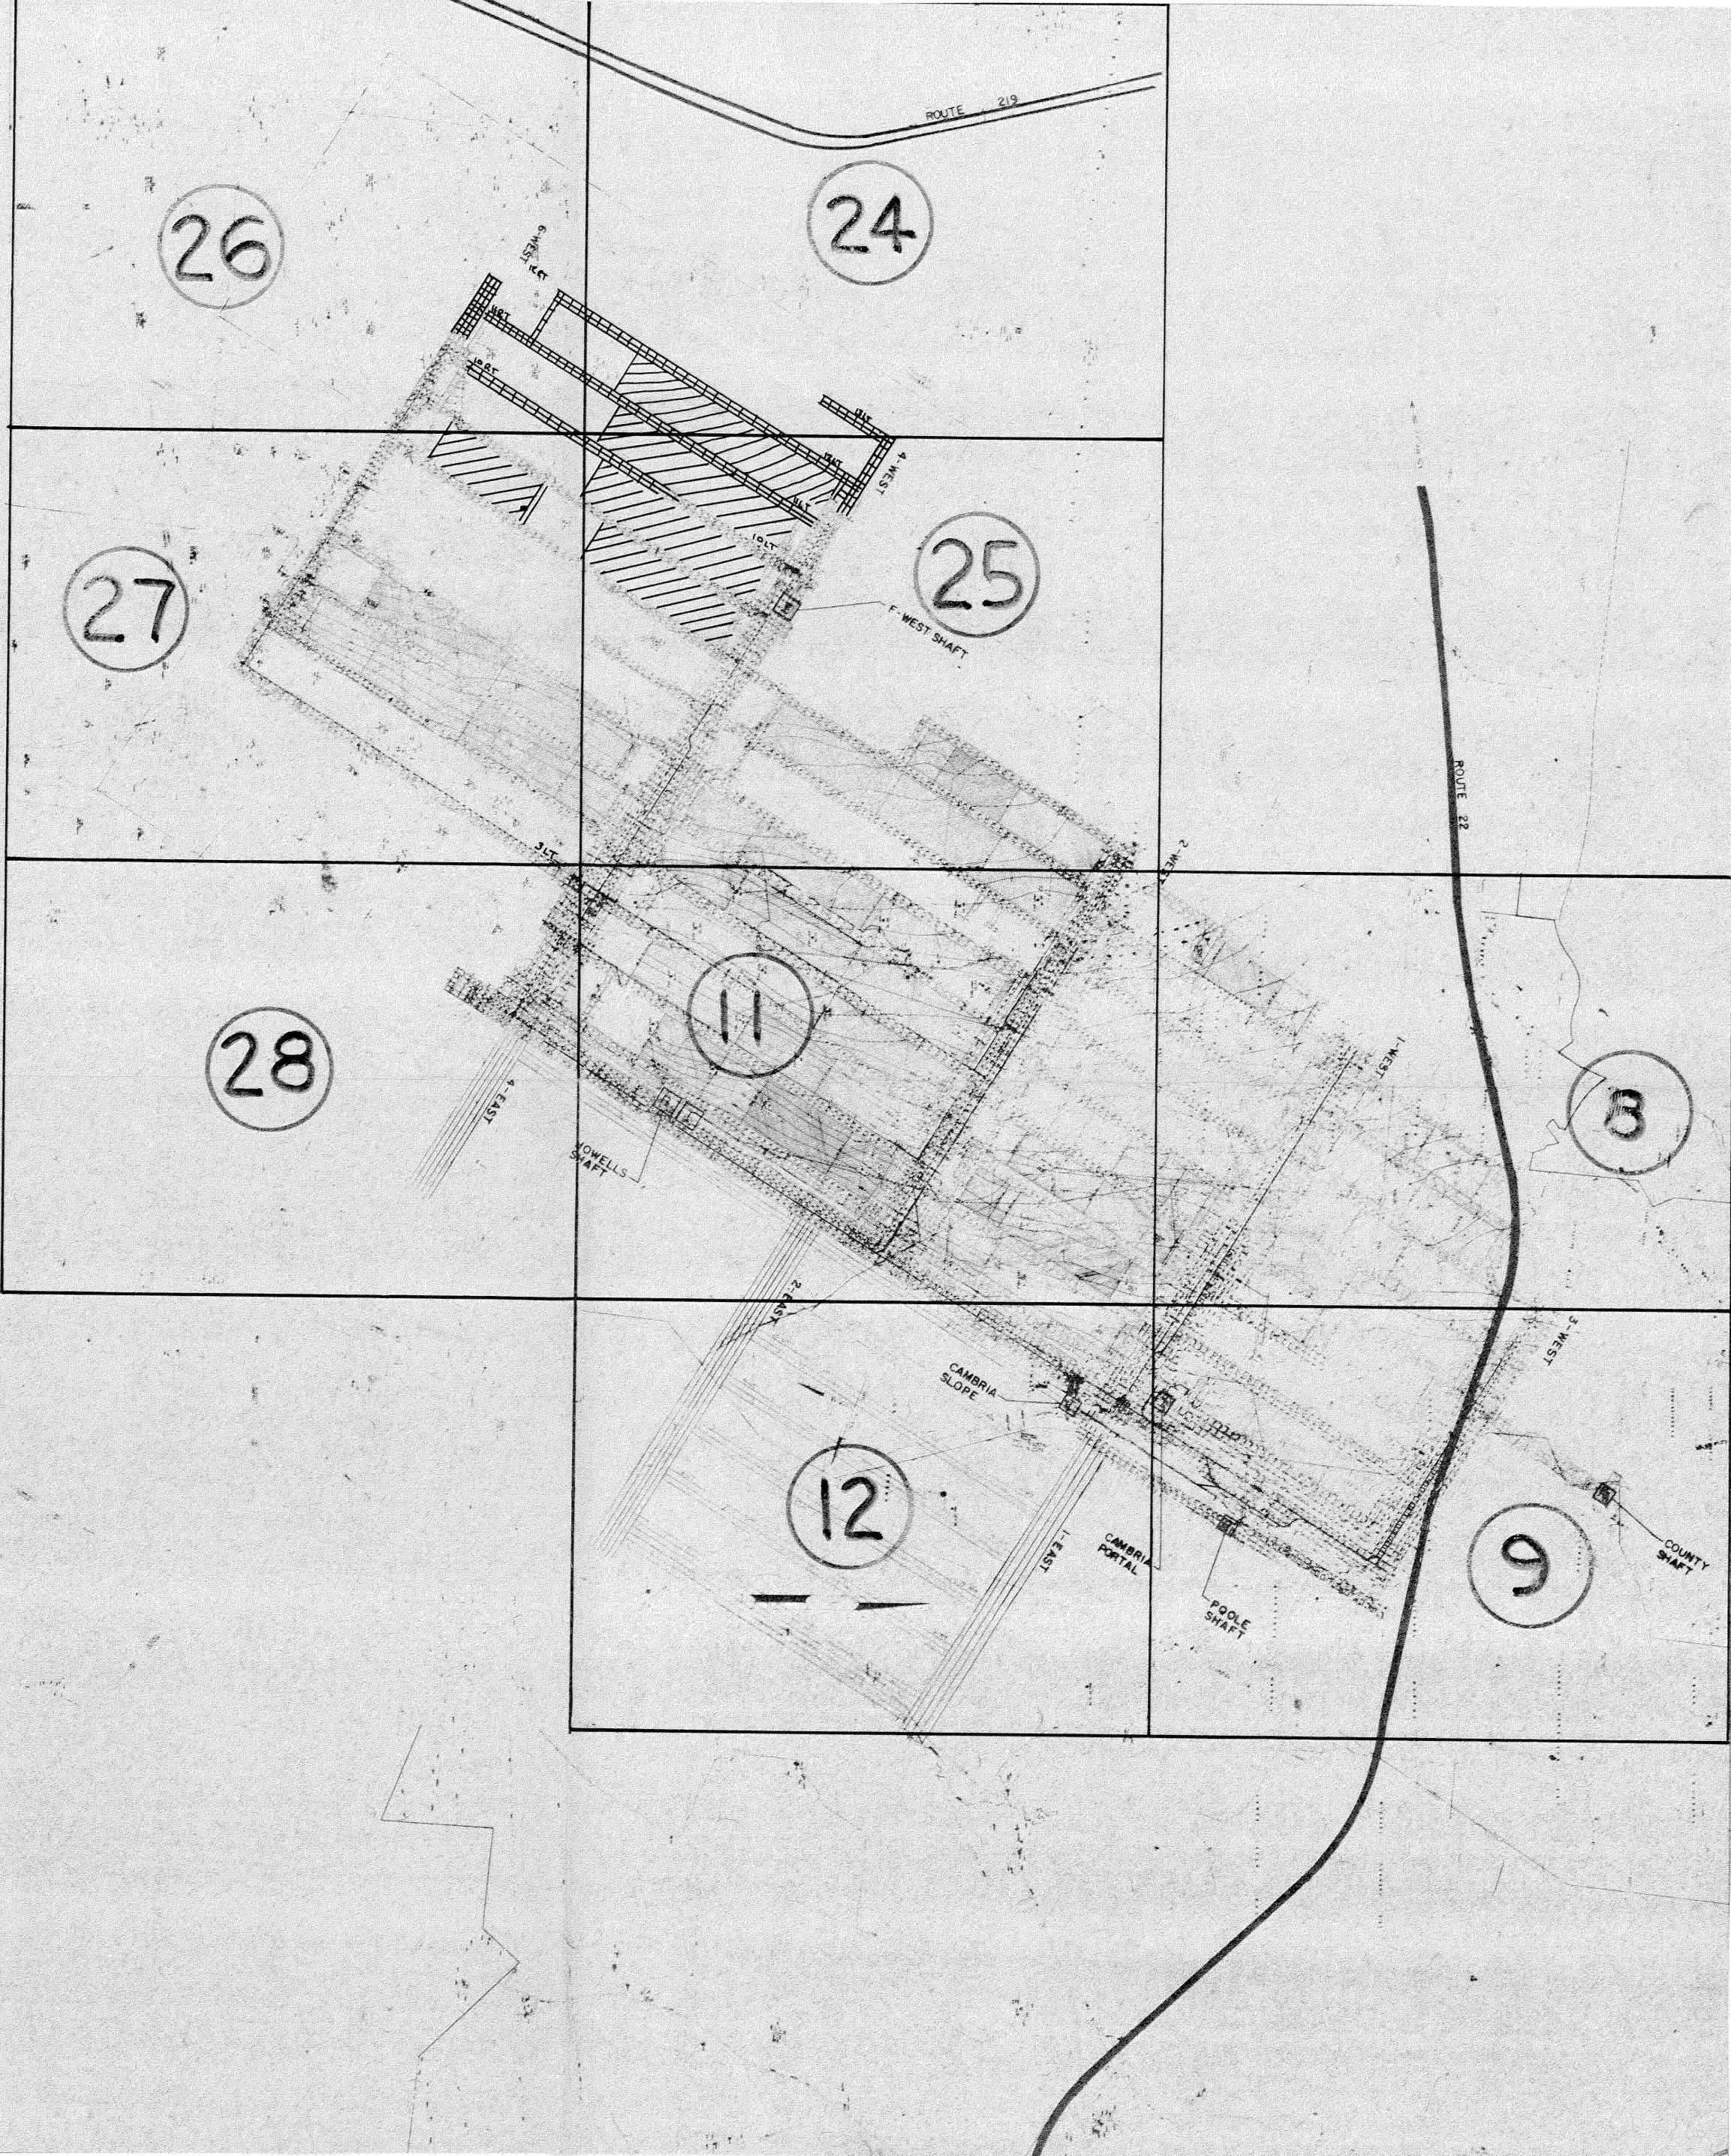

*David E. Horn*

FINAL

1" = 200' KEYSHEET

BETHENERGY MINES INC.

EBENSBURG, PA

MINE 33C

UPPER KITTANNING SEAM

SCALE: 1" = 200' DATE: 6-15-92

REV: 9-2-94 BEM