


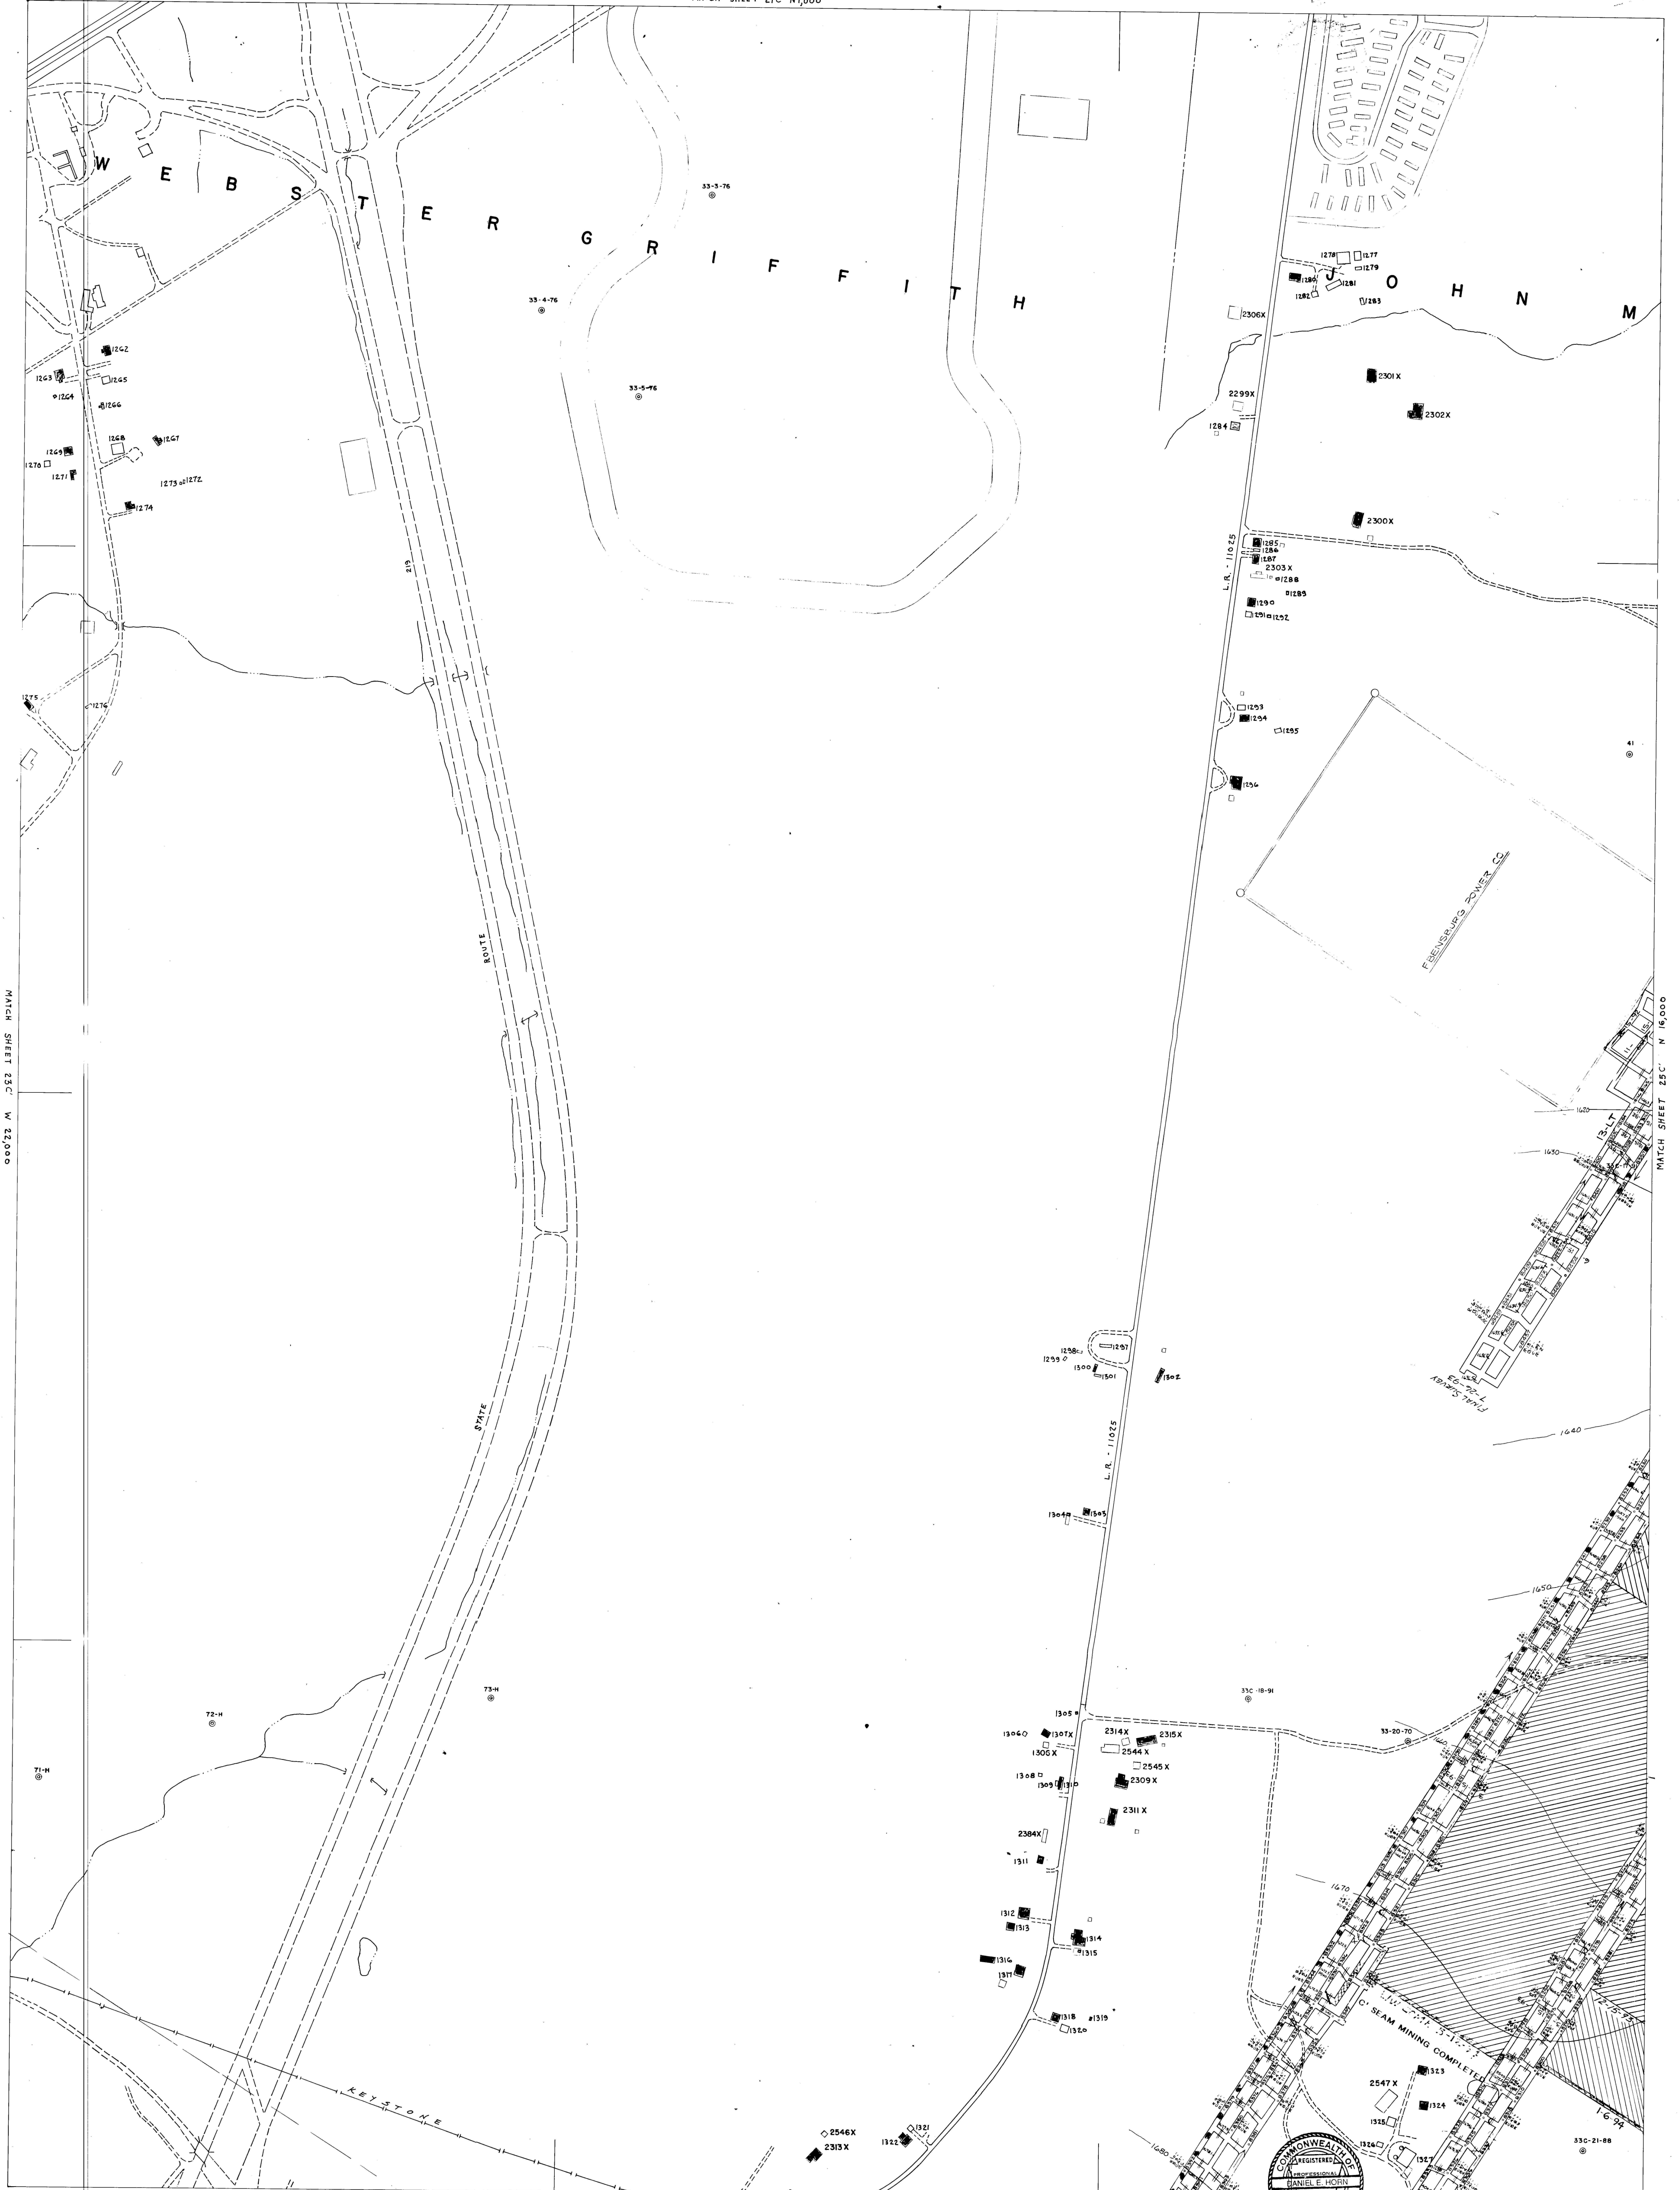


MATCH SHEET 23C W 22,000

MATCH SHEET 25C N 16,000

MATCH SHEET 26C

7,000

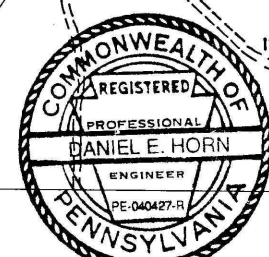

MINE 33-C 24-C
FINAL