27C'

MATCH SHEET 25C' S 7,000

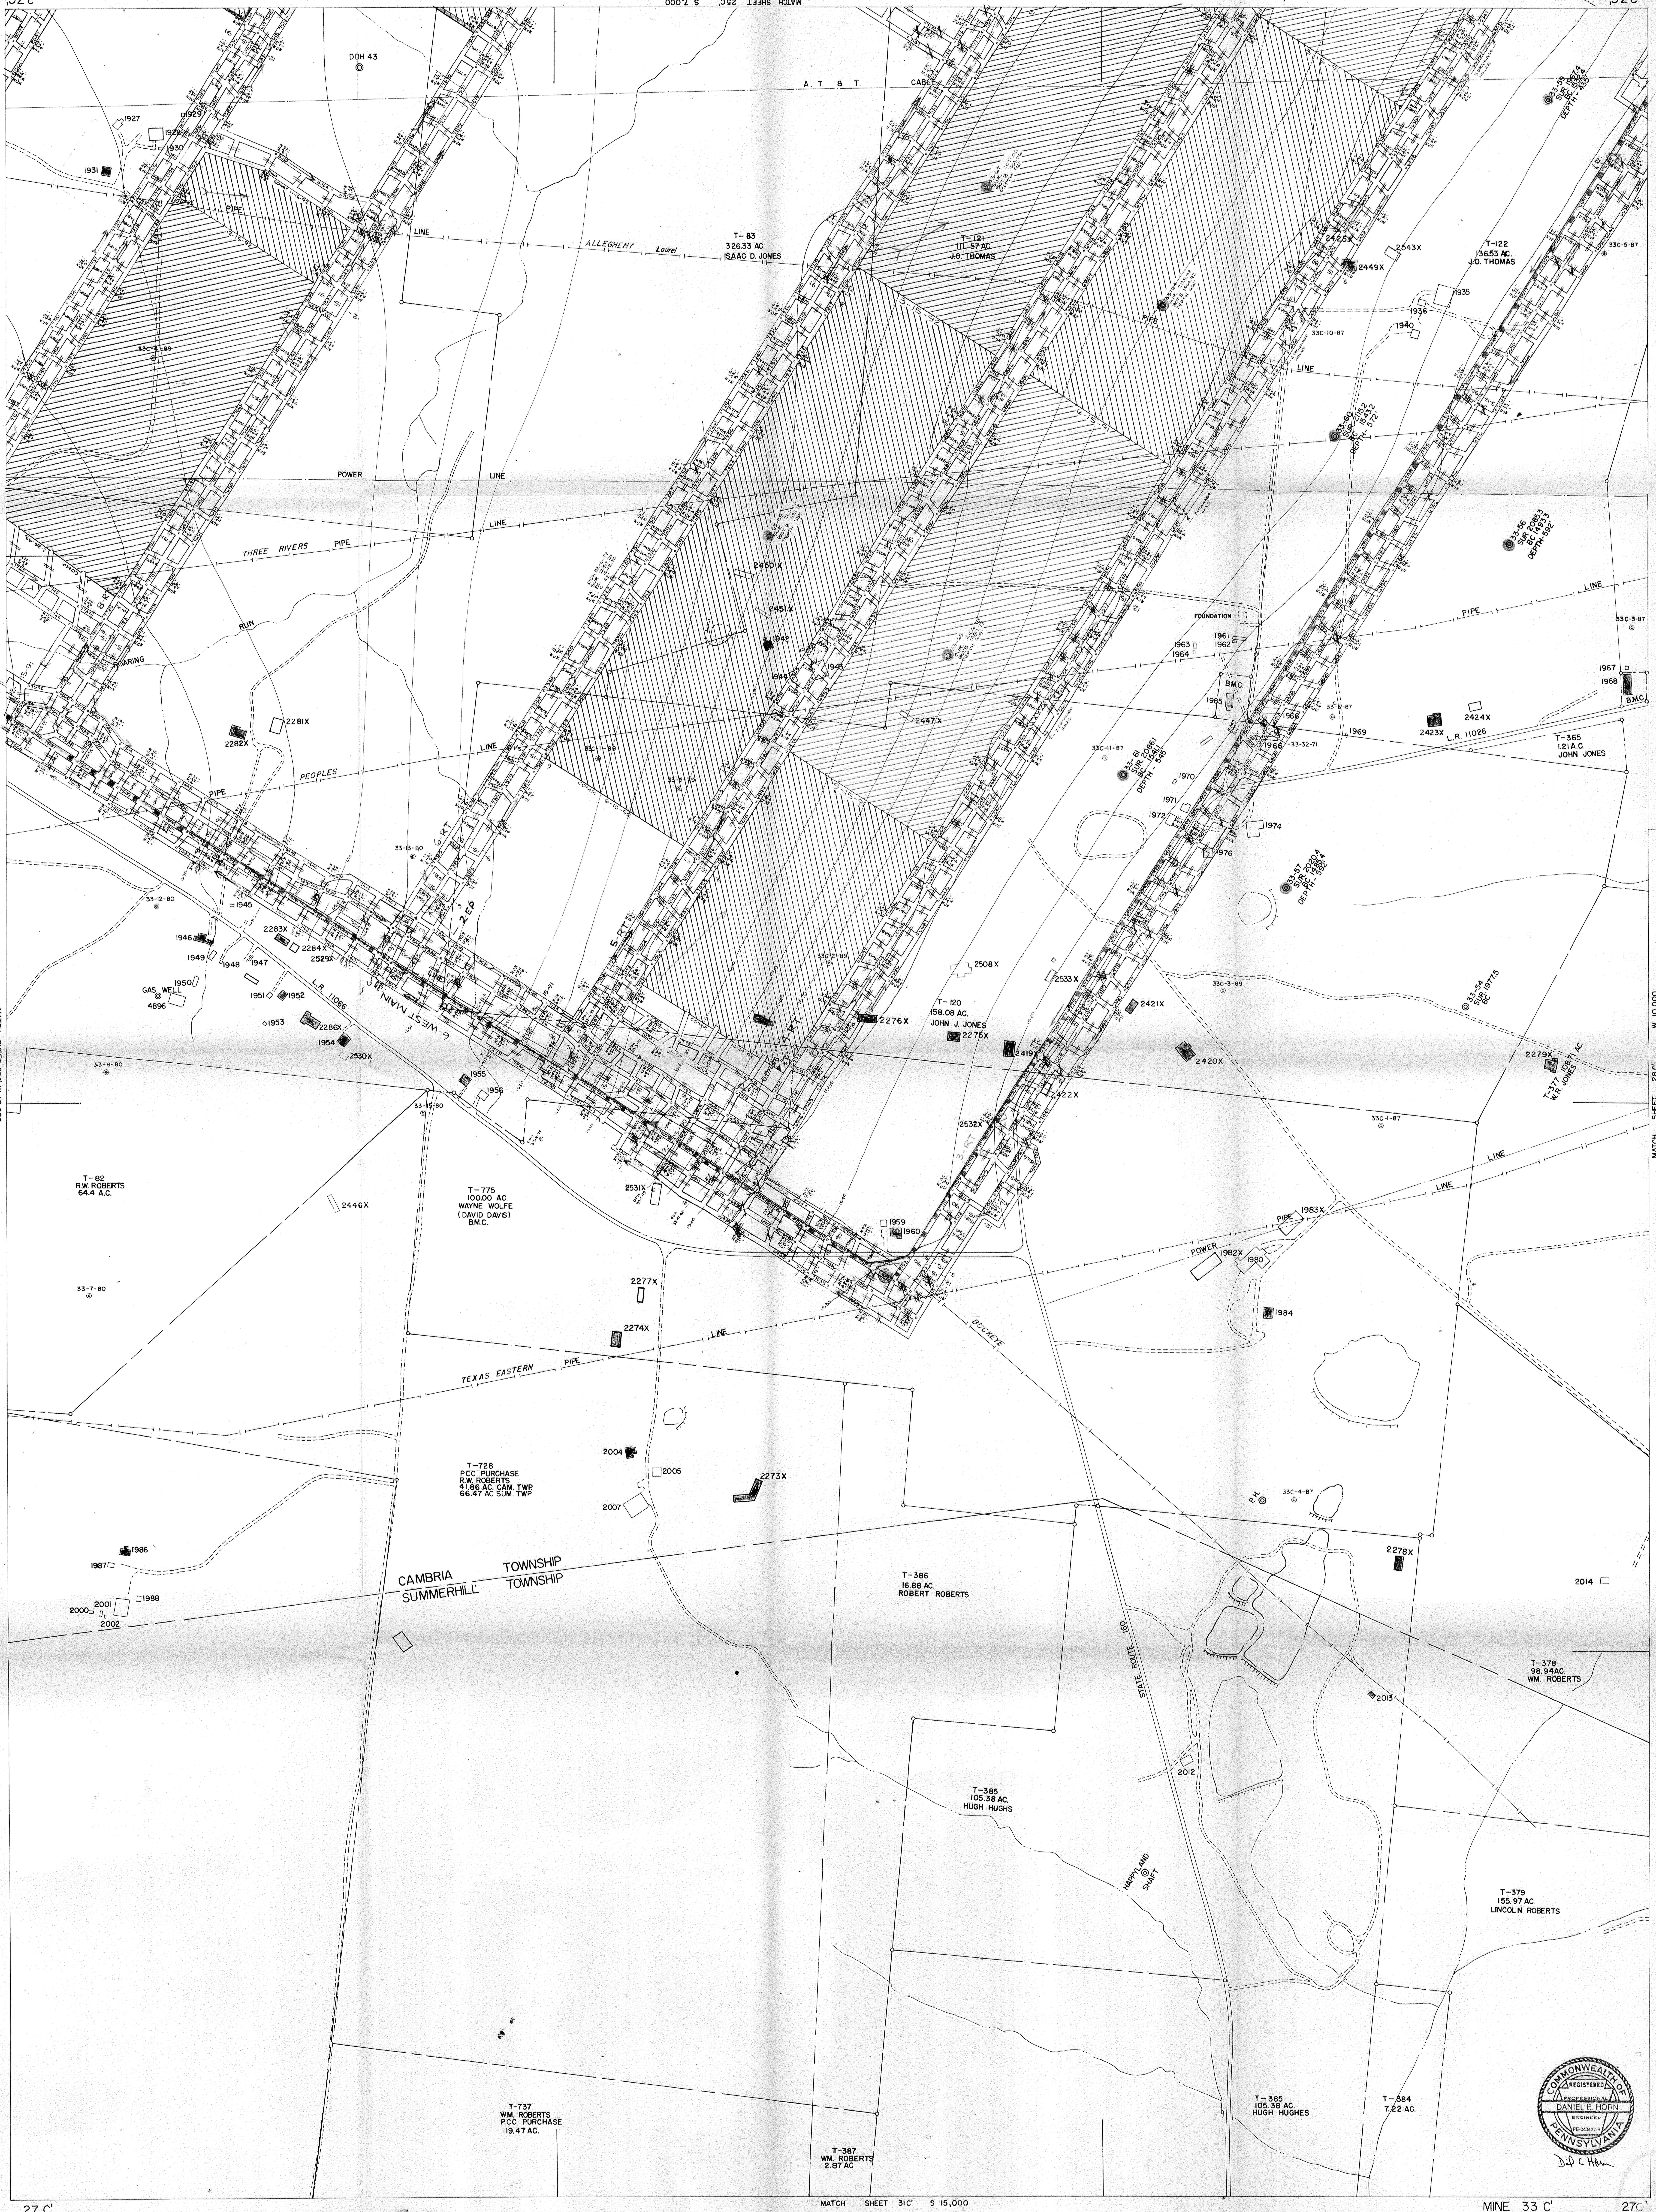

DDH 43
A. T. & T. CABLE
1927
1928
1929
1930
1931
PIPE
LINE
ALLEGHENY Laurel
T-83
326.33 AC.
ISAAC D. JONES
T-121
111.57 AC.
J.O. THOMAS
T-122
136.53 AC.
J.O. THOMAS
33-59
SUR. 1967.4
BC 1532.4
DEPTH - 435'
2425X
2449X
2543X
1935
1936
1940
33C-10-87
33C-5-87
33C-4-89
POWER LINE
LINE
THREE RIVERS PIPE
RUN
ROARING
33-60
SUR. 2115.2
BC 1543.2
DEPTH - 572
33-56
SUR. 2085.3
BC 1493.3
DEPTH - 592'
2450 X
2451 X
1942
1943
1944
FOUNDATION
1961
1962
1963
1964
B.M.C.
1965
1966
33-32-71
1967
1968
B.M.C.
33-6-87
1969
2423X
2424X
L.R. 11026
T-365
1.21 A.C.
JOHN JONES
33C-3-87
2447X
33C-11-87
33-61
SUR. 2086.1
BC 1541.1
DEPTH - 545
1970
1971
1972
1974
1976
33-57
SUR. 2020.4
BC 1485.4
DEPTH - 592'
2281X
2282X
PEOPLES PIPE LINE
33C-1-89
33-5-79
33-13-80
33-12-80
1945
1946
1949
1948
1947
2283X
2284X
2529X
GAS WELL
4896
1950
1951
1952
1953
L.R. 11066
6 WEST MAIN
2286X
1954
2530X
33-8-80
1955
1956
33-15-80
33C-2-89
2508X
2533X
T-120
158.08 AC.
JOHN J. JONES
2275X
2276X
2419X
2421X
2420X
2422X
2532X
33-54
SUR. 1977.5
BC
33C-3-89
2279X
T-377 108.71 AC.
W.R. JONES
33C-1-87
T-82
R.W. ROBERTS
64.4 A.C.
2446X
T-775
100.00 AC.
WAYNE WOLFE
(DAVID DAVIS)
B.M.C.
2531X
1959
1960
33-7-80
2277X
2274X
TEXAS EASTERN PIPE LINE
BUCKEYE
POWER
1982X
1980
1983X
PIPE
LINE
LINE
1984
2004
2005
2007
2273X
T-728
PCC PURCHASE
R.W. ROBERTS
41.86 AC. CAM. TWP.
66.47 AC SUM. TWP.
P.H.
33C-4-87
2278X
2014
1986
1987
1988
2001
2000
2002
CAMBRIA TOWNSHIP
SUMMERHILL TOWNSHIP
T-386
16.88 AC.
ROBERT ROBERTS
STATE ROUTE 160
T-378
98.94 AC.
WM. ROBERTS
2013
2012
T-385
105.38 AC.
HUGH HUGHS
HAPPYLAND SHAFT
T-379
155.97 AC.
LINCOLN ROBERTS
T-737
WM. ROBERTS
PCC PURCHASE
19.47 AC.
T-387
WM. ROBERTS
2.87 AC
T-385
105.38 AC.
HUGH HUGHES
T-384
7.22 AC.
N

MATCH SHEET 26C' W 16,000

MATCH SHEET 28C' W 10,000

MATCH SHEET 31C' S 15,000

27 C'

DANIEL E. HORN
PE-040427-R

D E Horn

MINE 33 C'
REVISED 1-86

27C'

FINAL