


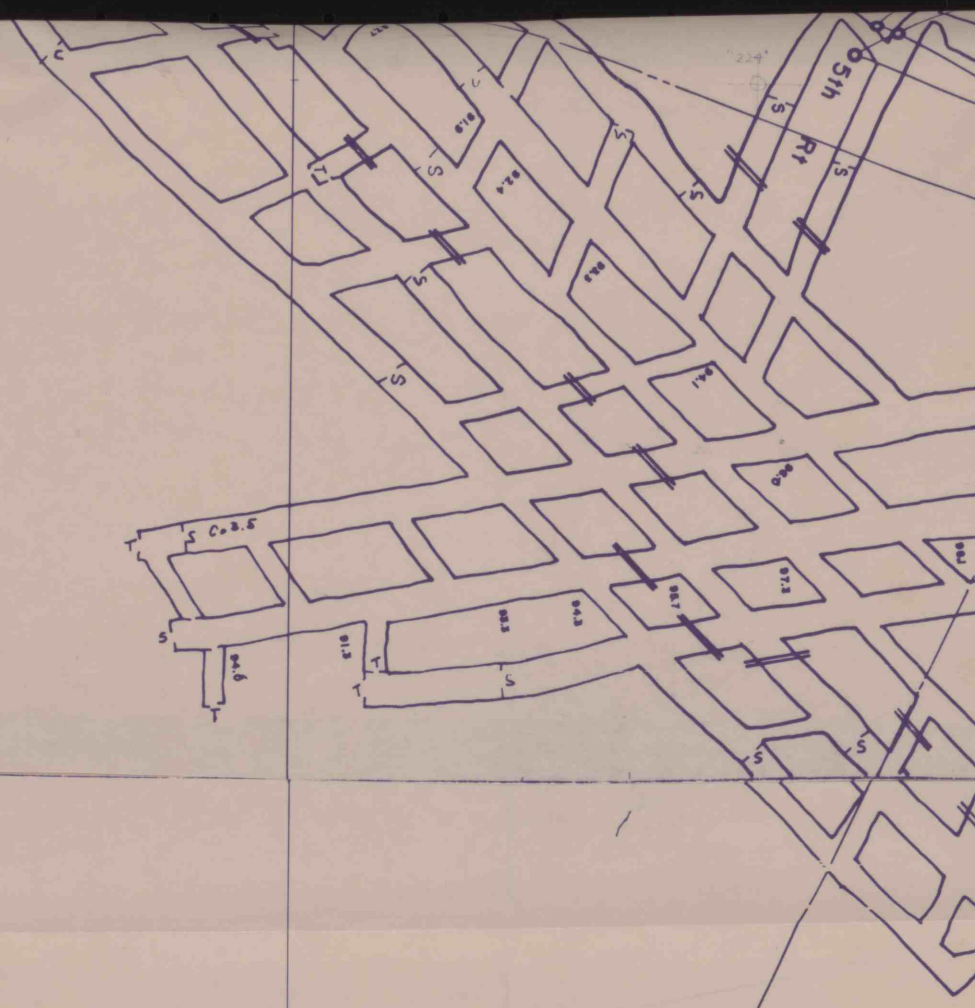

CONEMAUGH
RIVER

RAILROAD


RAILROAD

POWER LINE

POWER LINE

38749416

THE NORTH AMERICAN COAL CO.,
CONEMAUGH DISTRICT
Scale: 1" = 100'
Date of last survey: 12/2/81
Date: 9/20/82

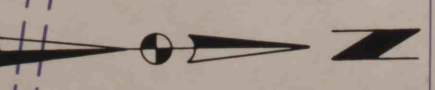

File - Map Publishing