


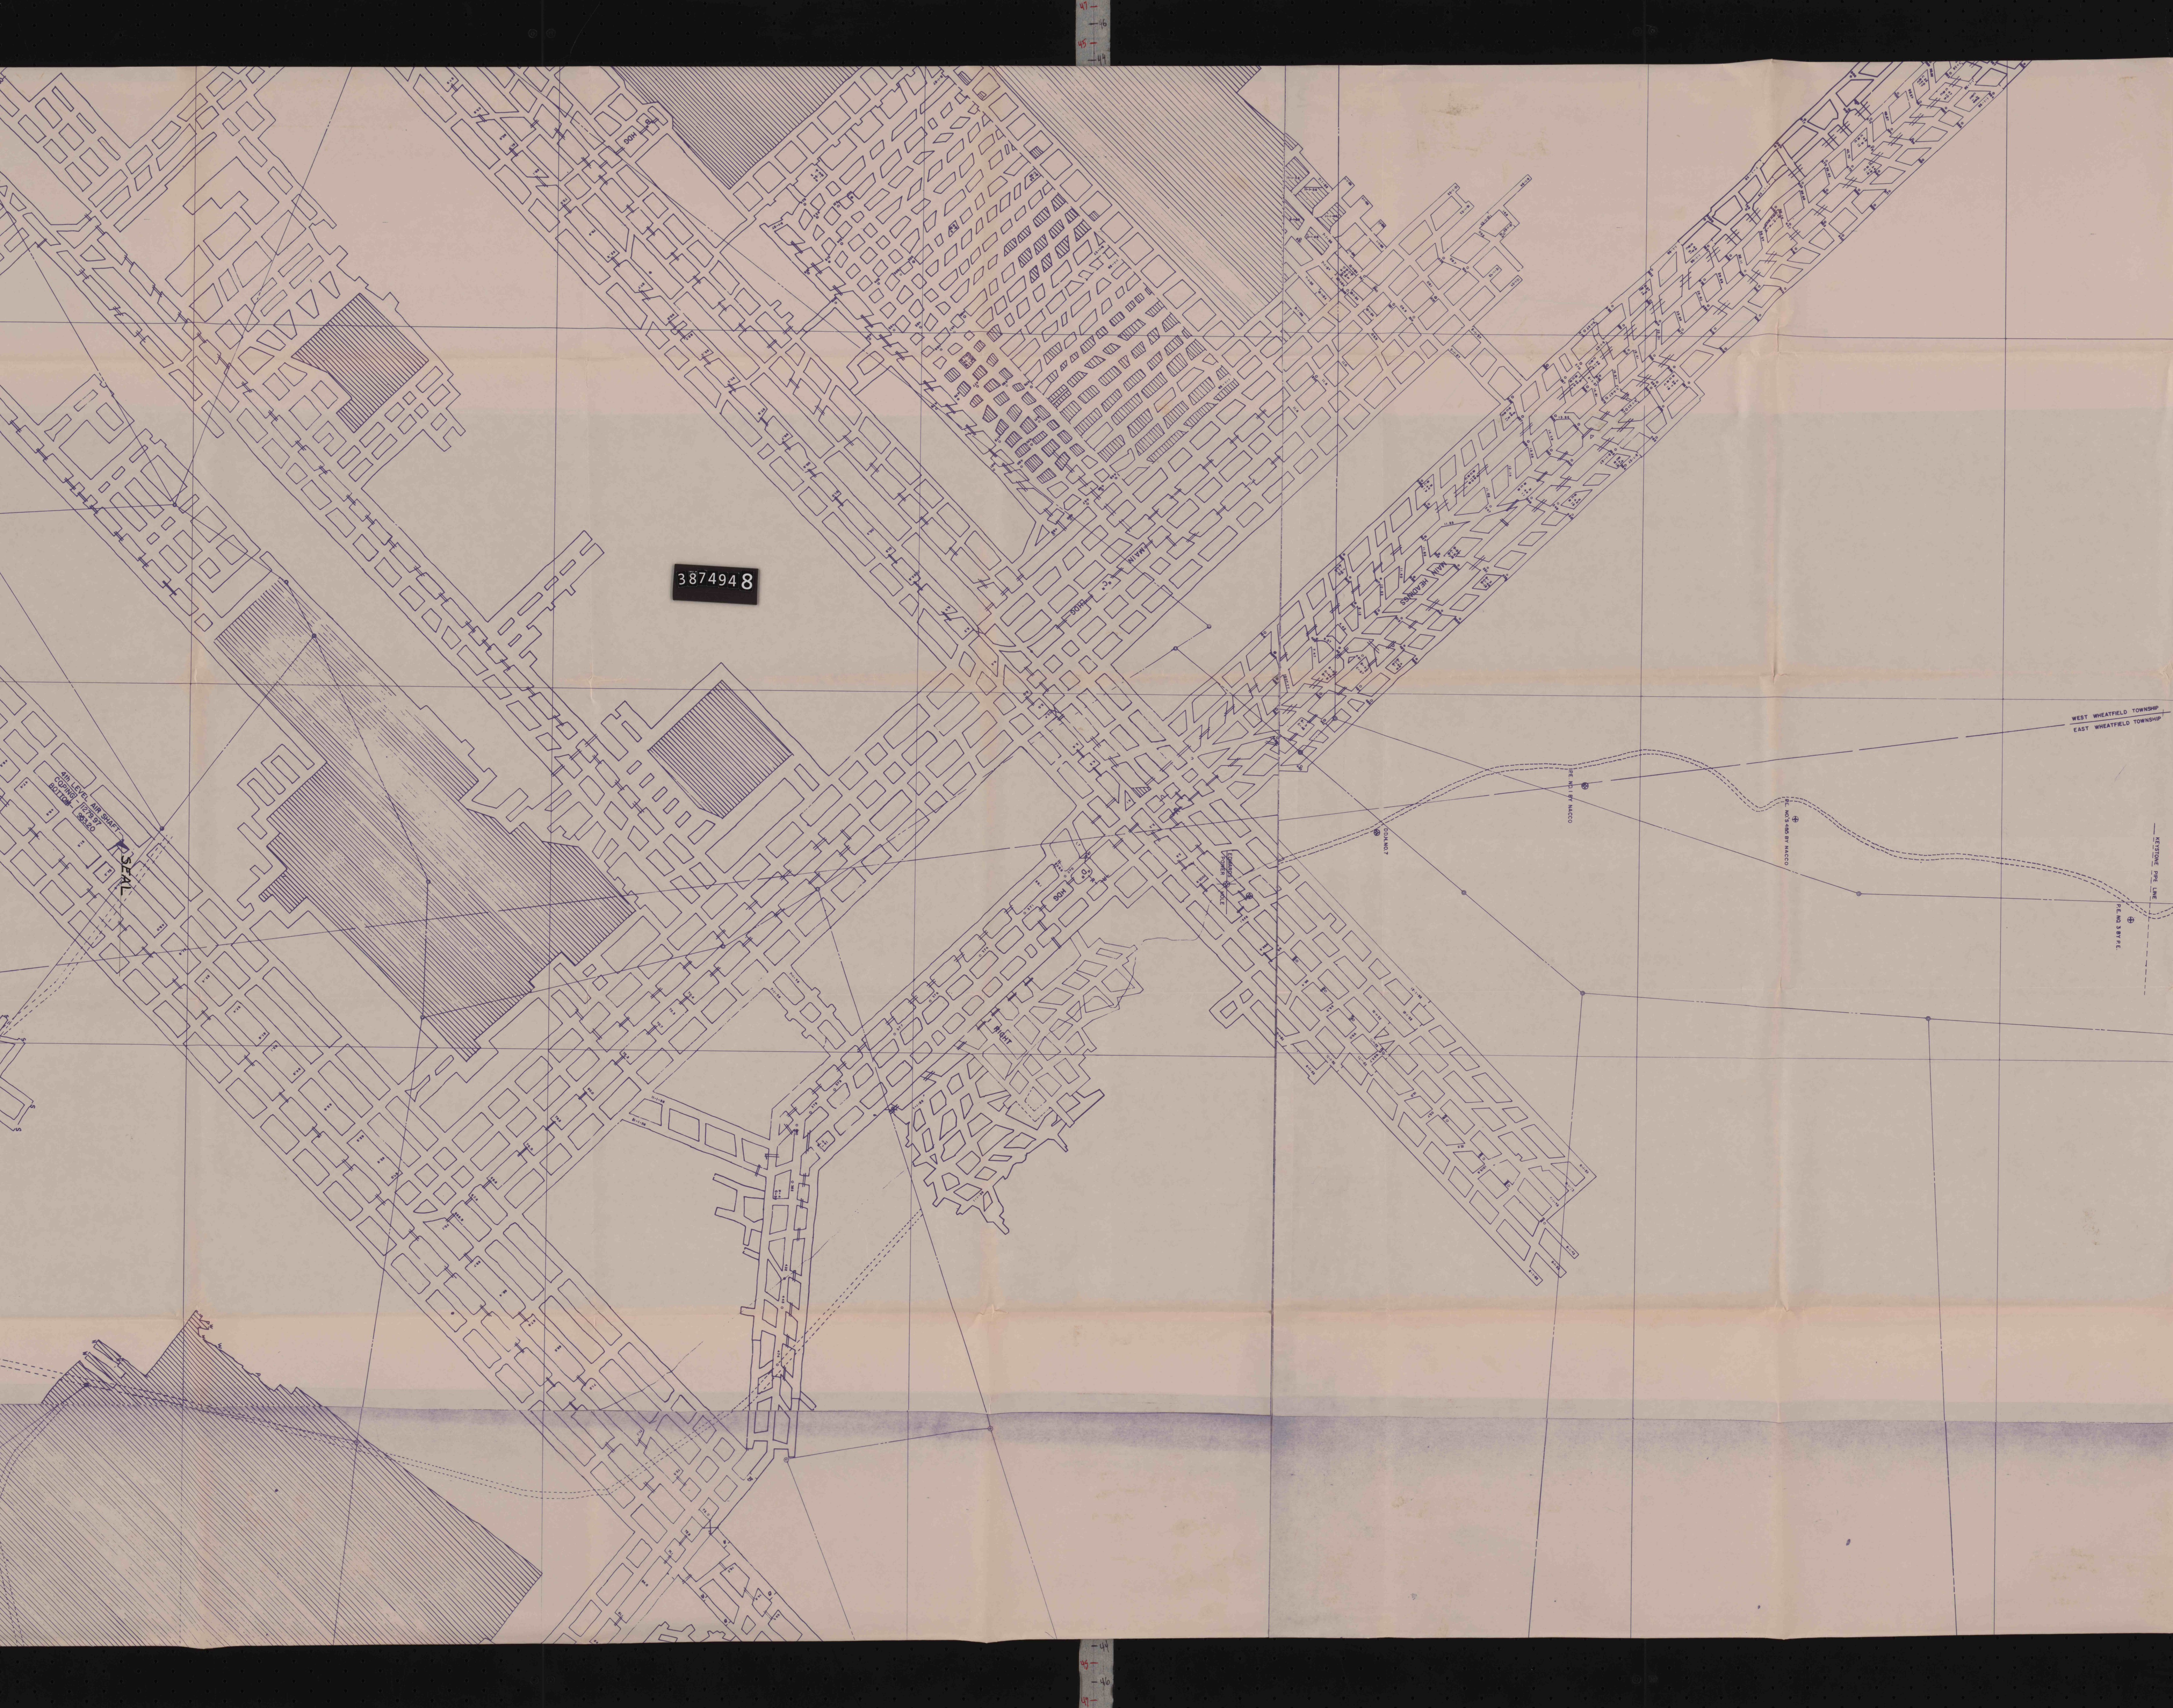

3874948

SEAL

WEST WHEATFIELD TOWNSHIP
EAST WHEATFIELD TOWNSHIP
STONE PINE LINE
P.E. NO. 2 BY P.E.
P.E. NO. 3 BY P.E.
