


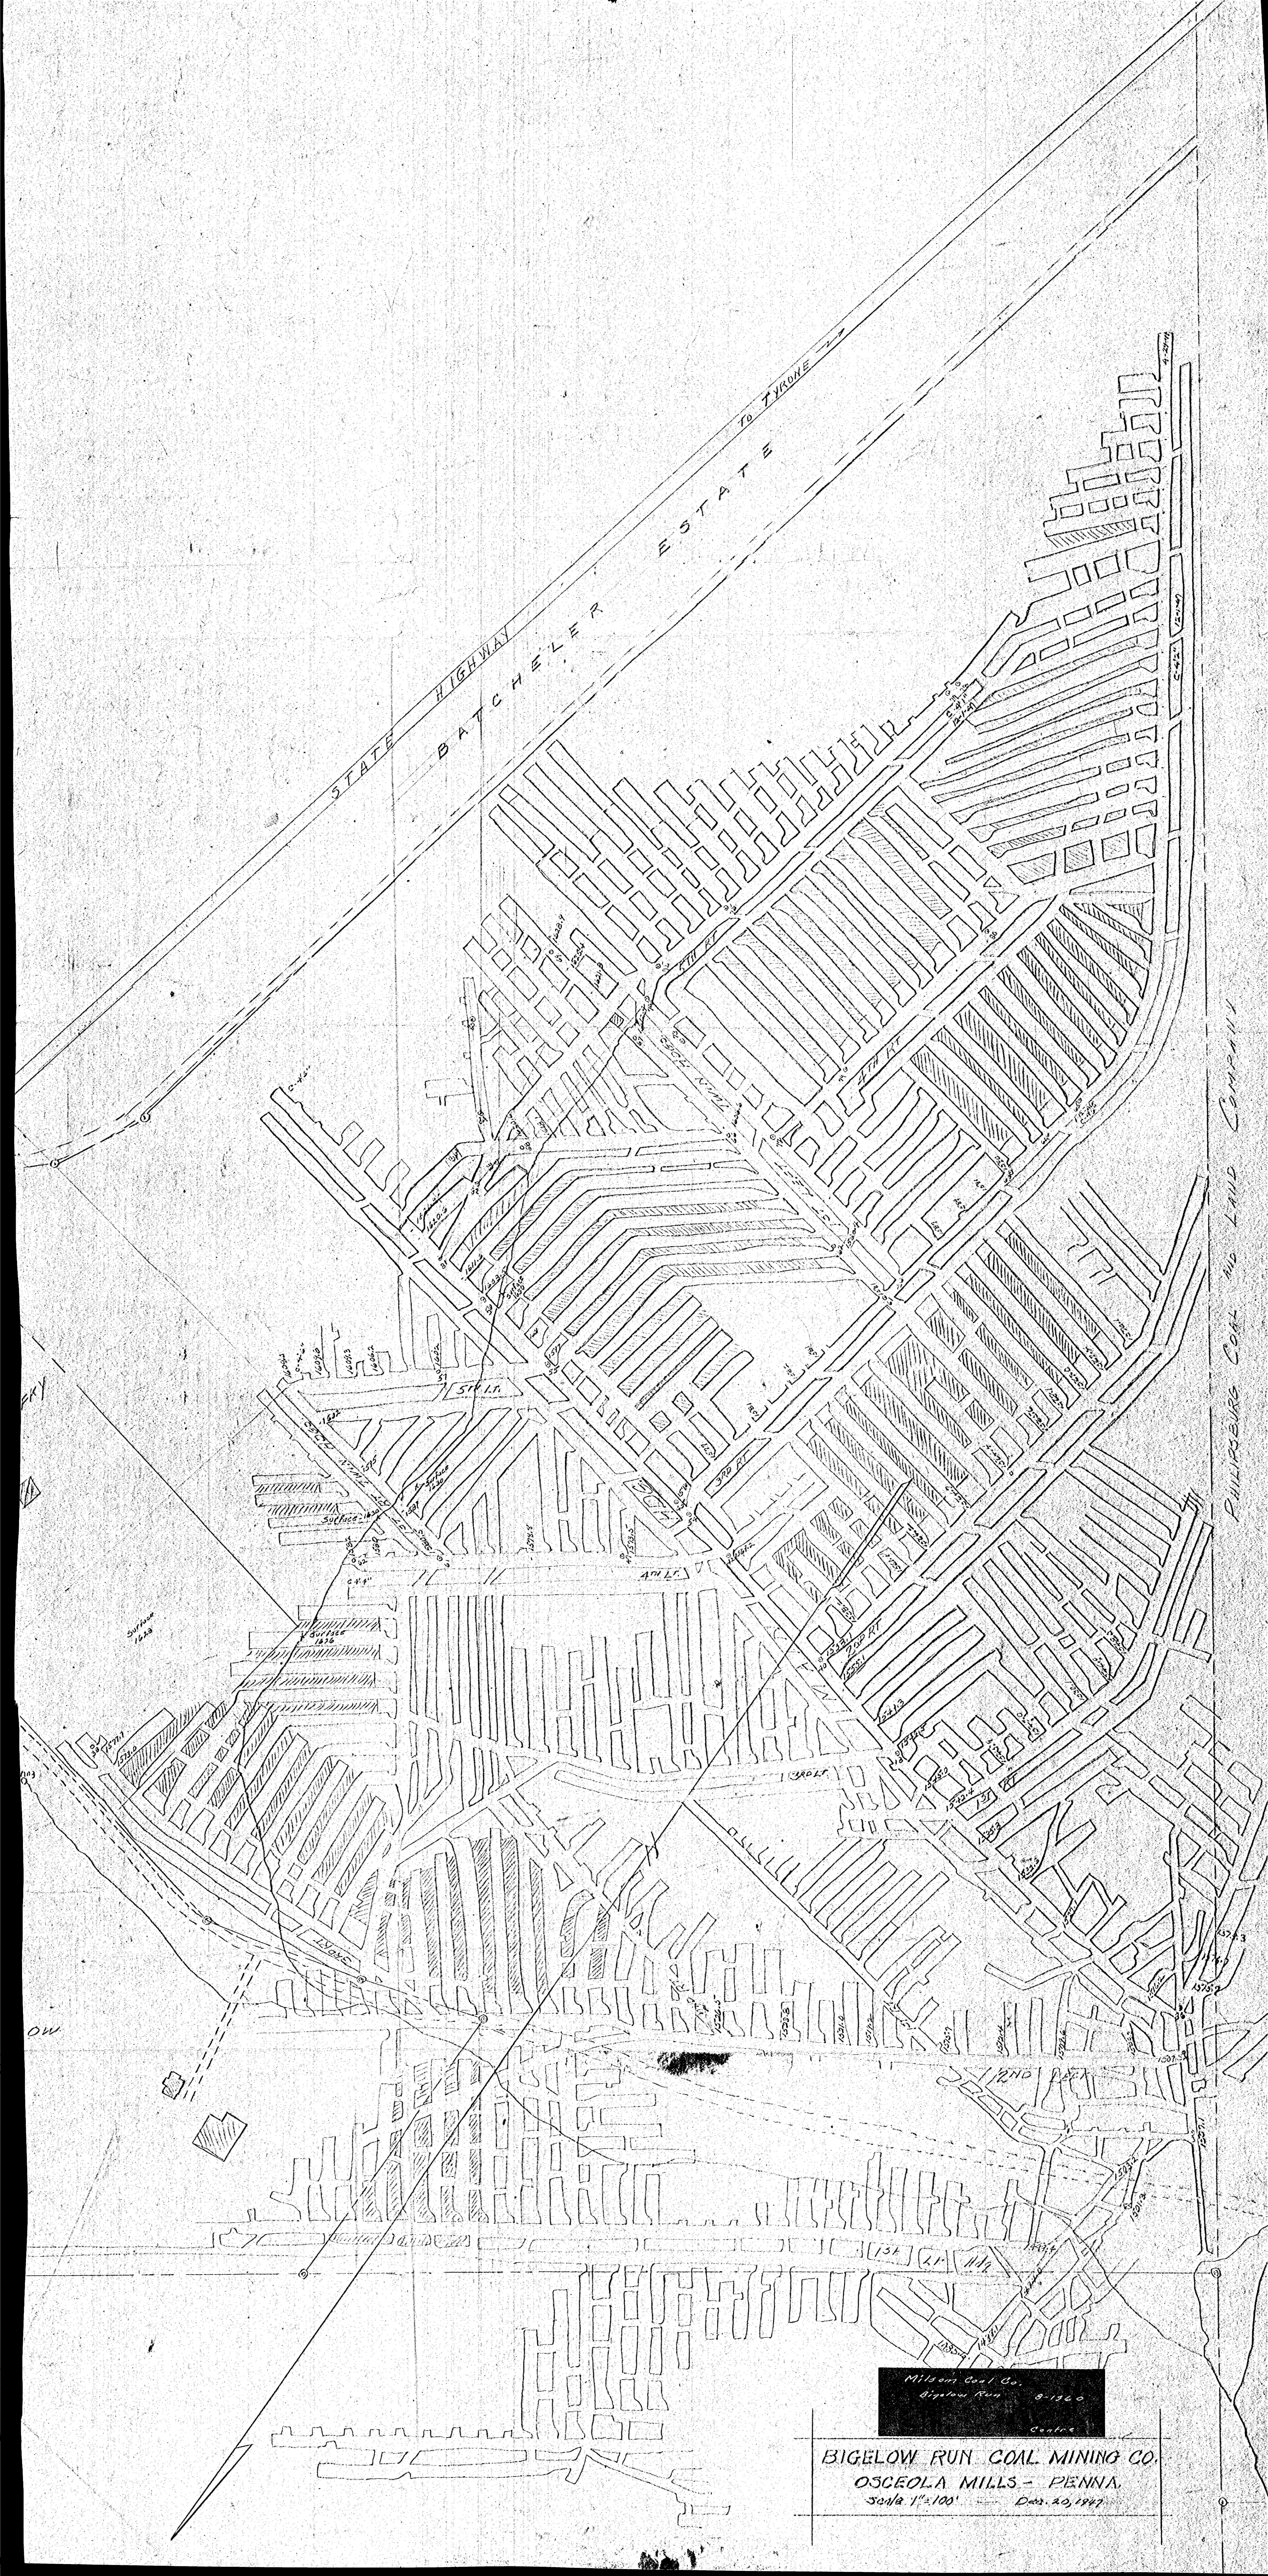

MILSON Coal Co.
Bigelow Run 8-1960
BIGELOW RUN COAL MINING CO.
OSCEOLA MILLS - PENNA.
Scale 1"=100' Date 20, 1947