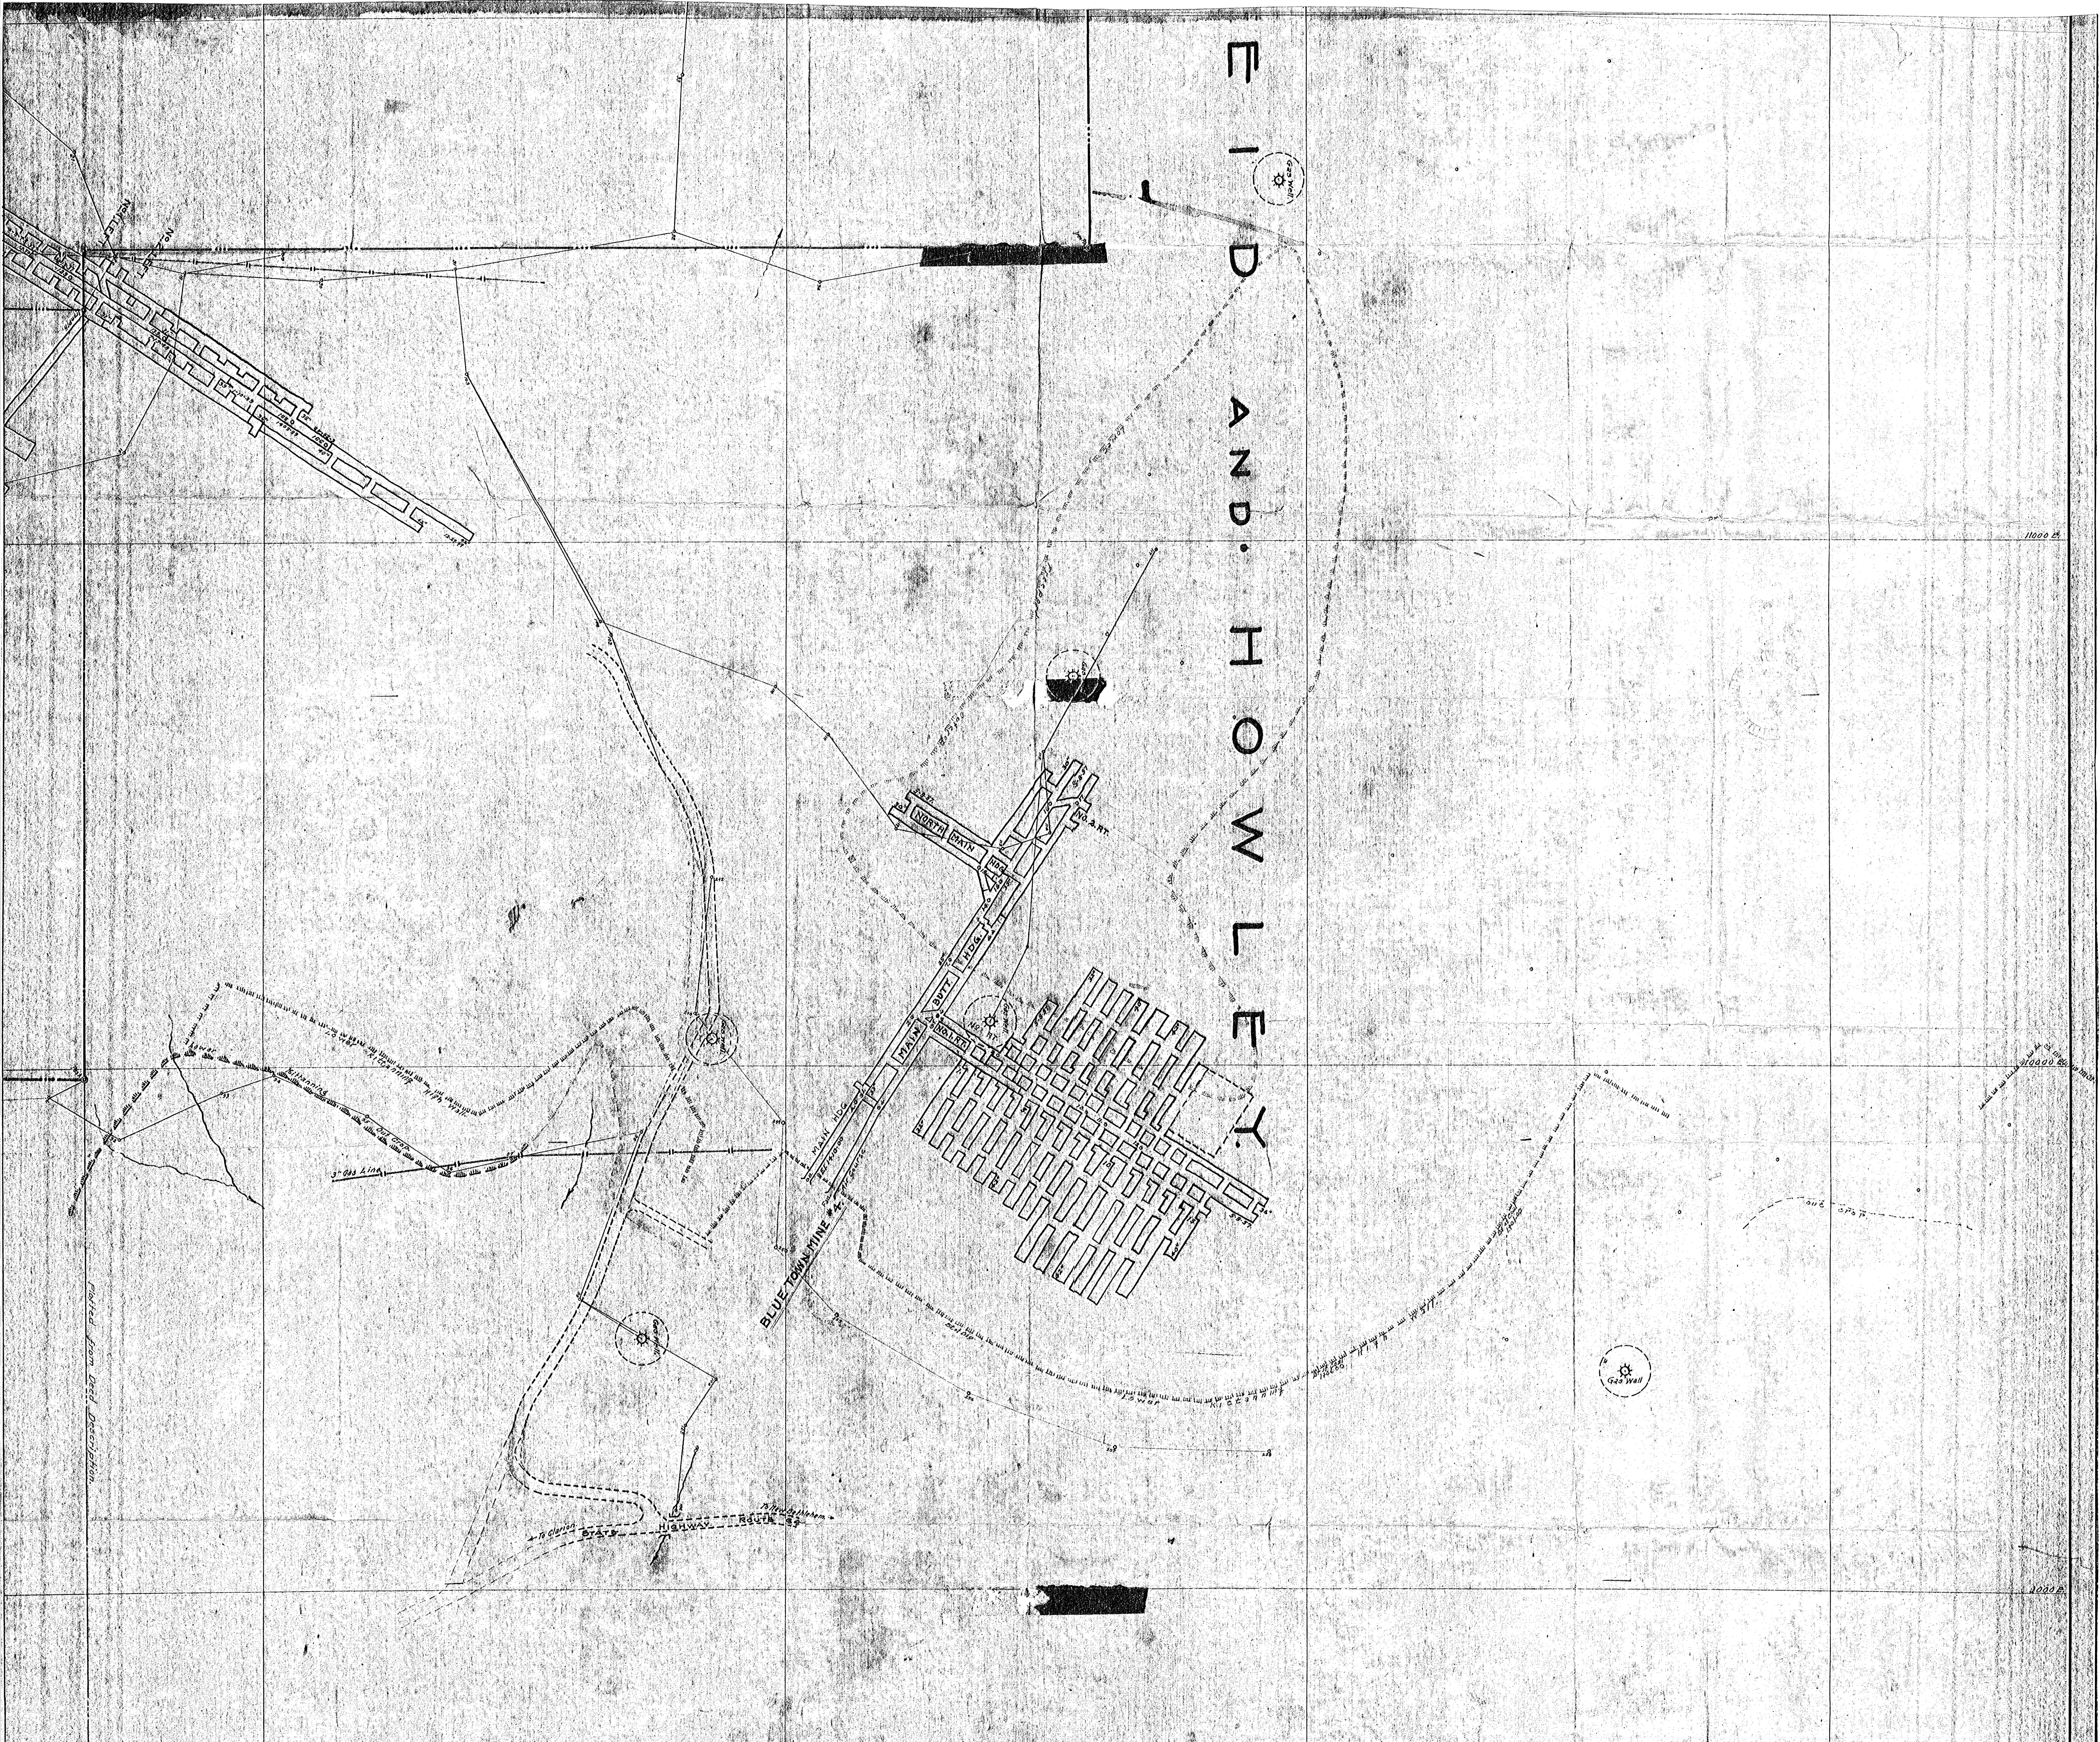
E. I. D. AND HOWLEY.
BLUE TOWN MINE #4.
NORTH MAIN HDG.
MAIN BUTT HDG.
MAIN HDG.
NO. 1 RT.
NO. 2 RT.
Gas Well
3" Gas Line
Lower Kittanning
State Highway Route 28
To Clarion
To New Bethlehem
Plotted from Deed Description
11000 N.
10000 N.
9000 N.

Plotted from Deed Description.

MAYS COAL CO.

BLUETOWN MINE – #4.

REDBANK TWP. CLARION CO.

Survey Date – 5-8-57. Scale 1" = 100' DIST #4

EVANS TRUCKING CO.–OPERATOR – New Bethlehem, Pa.

Feb. 1956. R. L. Pfaff Reg. Eng. East Brady, Pa.

4-1961

[redacted]