STATE GAME LANDS

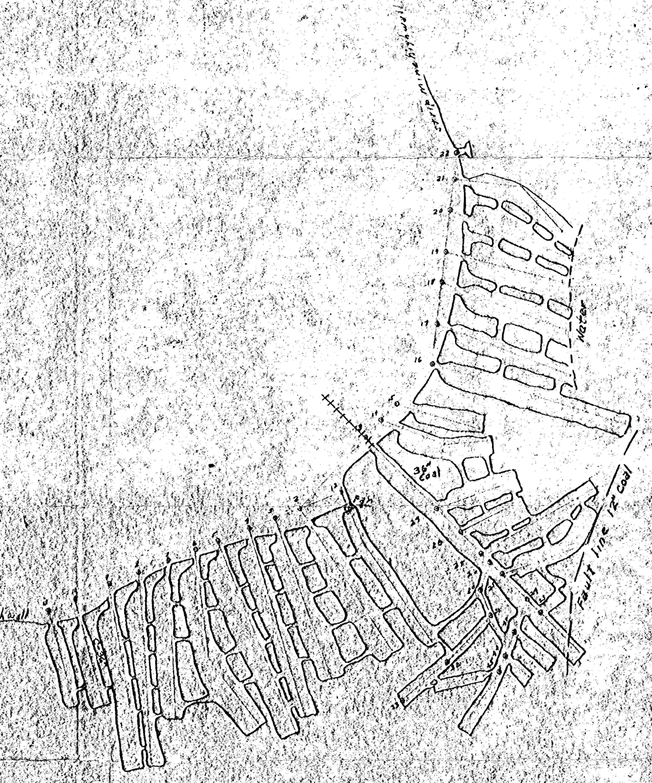

LITKE AND HESS

FISHER WARRANT

Survey Dates
1. 7-9-36
2.

H. AND R. COAL CO.
SNOW SHOE, PA.

Plot of Survey of Deep Mine Operations in A Seam in Snow Shoe Twp. Centre Co. Pa.

SCALE: 1" = 100' | DATE: 7-13-36 | DRAWN BY: J.W.S.

ALLEN G. BUTLER
PROFESSIONAL ENGINEER

NO. 30037