


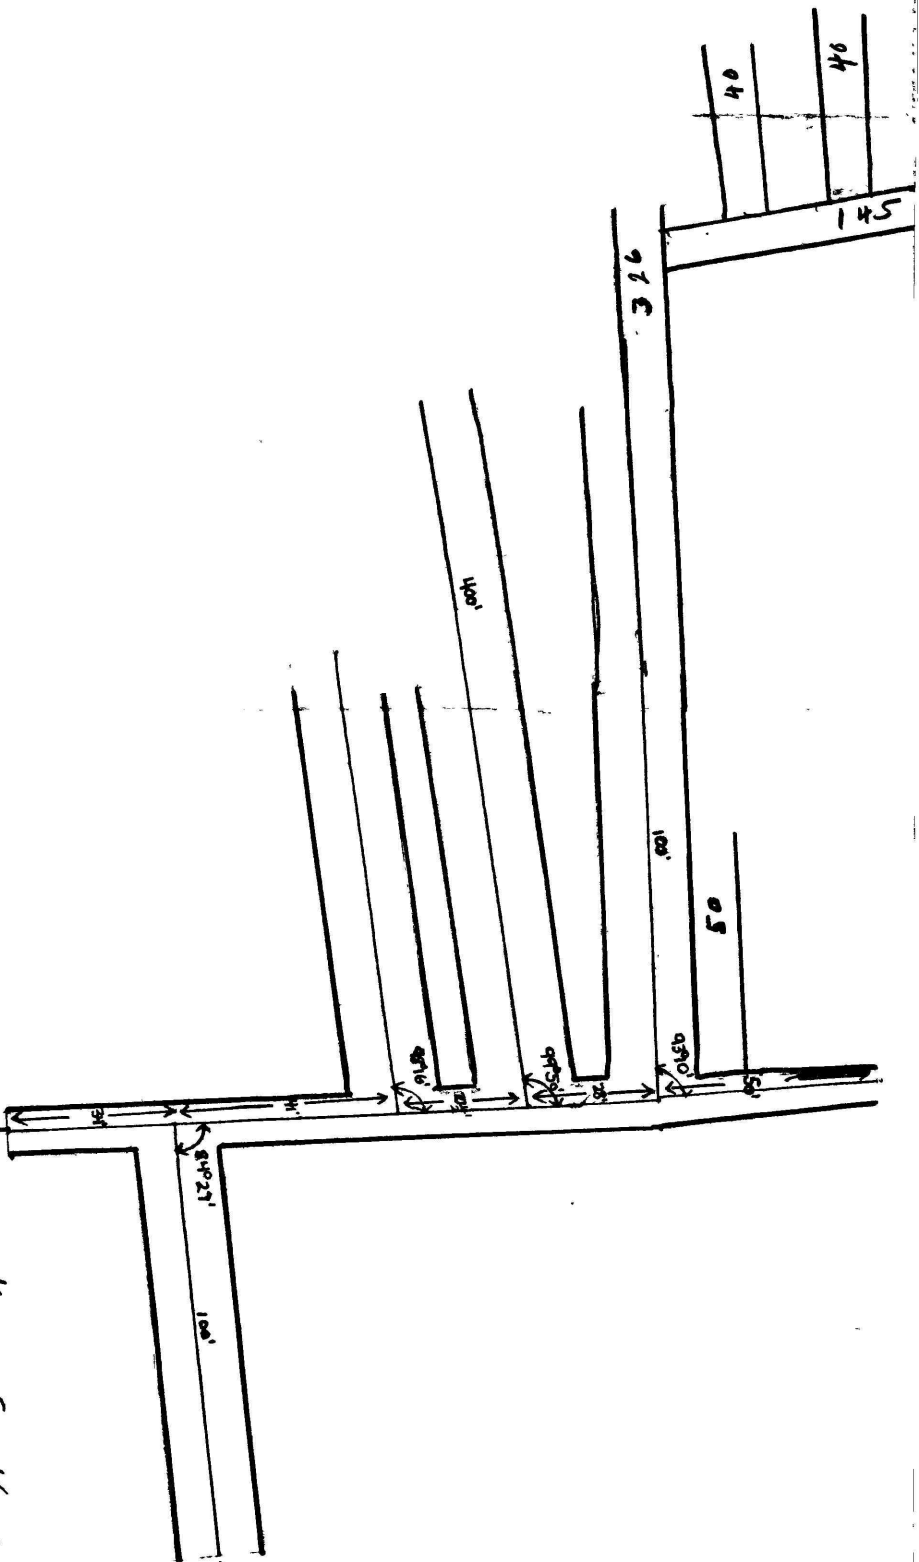

Map of Geo Houderhell Coal Mine
 Located in Curtintwp.
 Centre Co, Pa.

Survey and Map Made by Geo C Painter, June 6, 1955

Scale: 32 ft to 1 in Dist 8