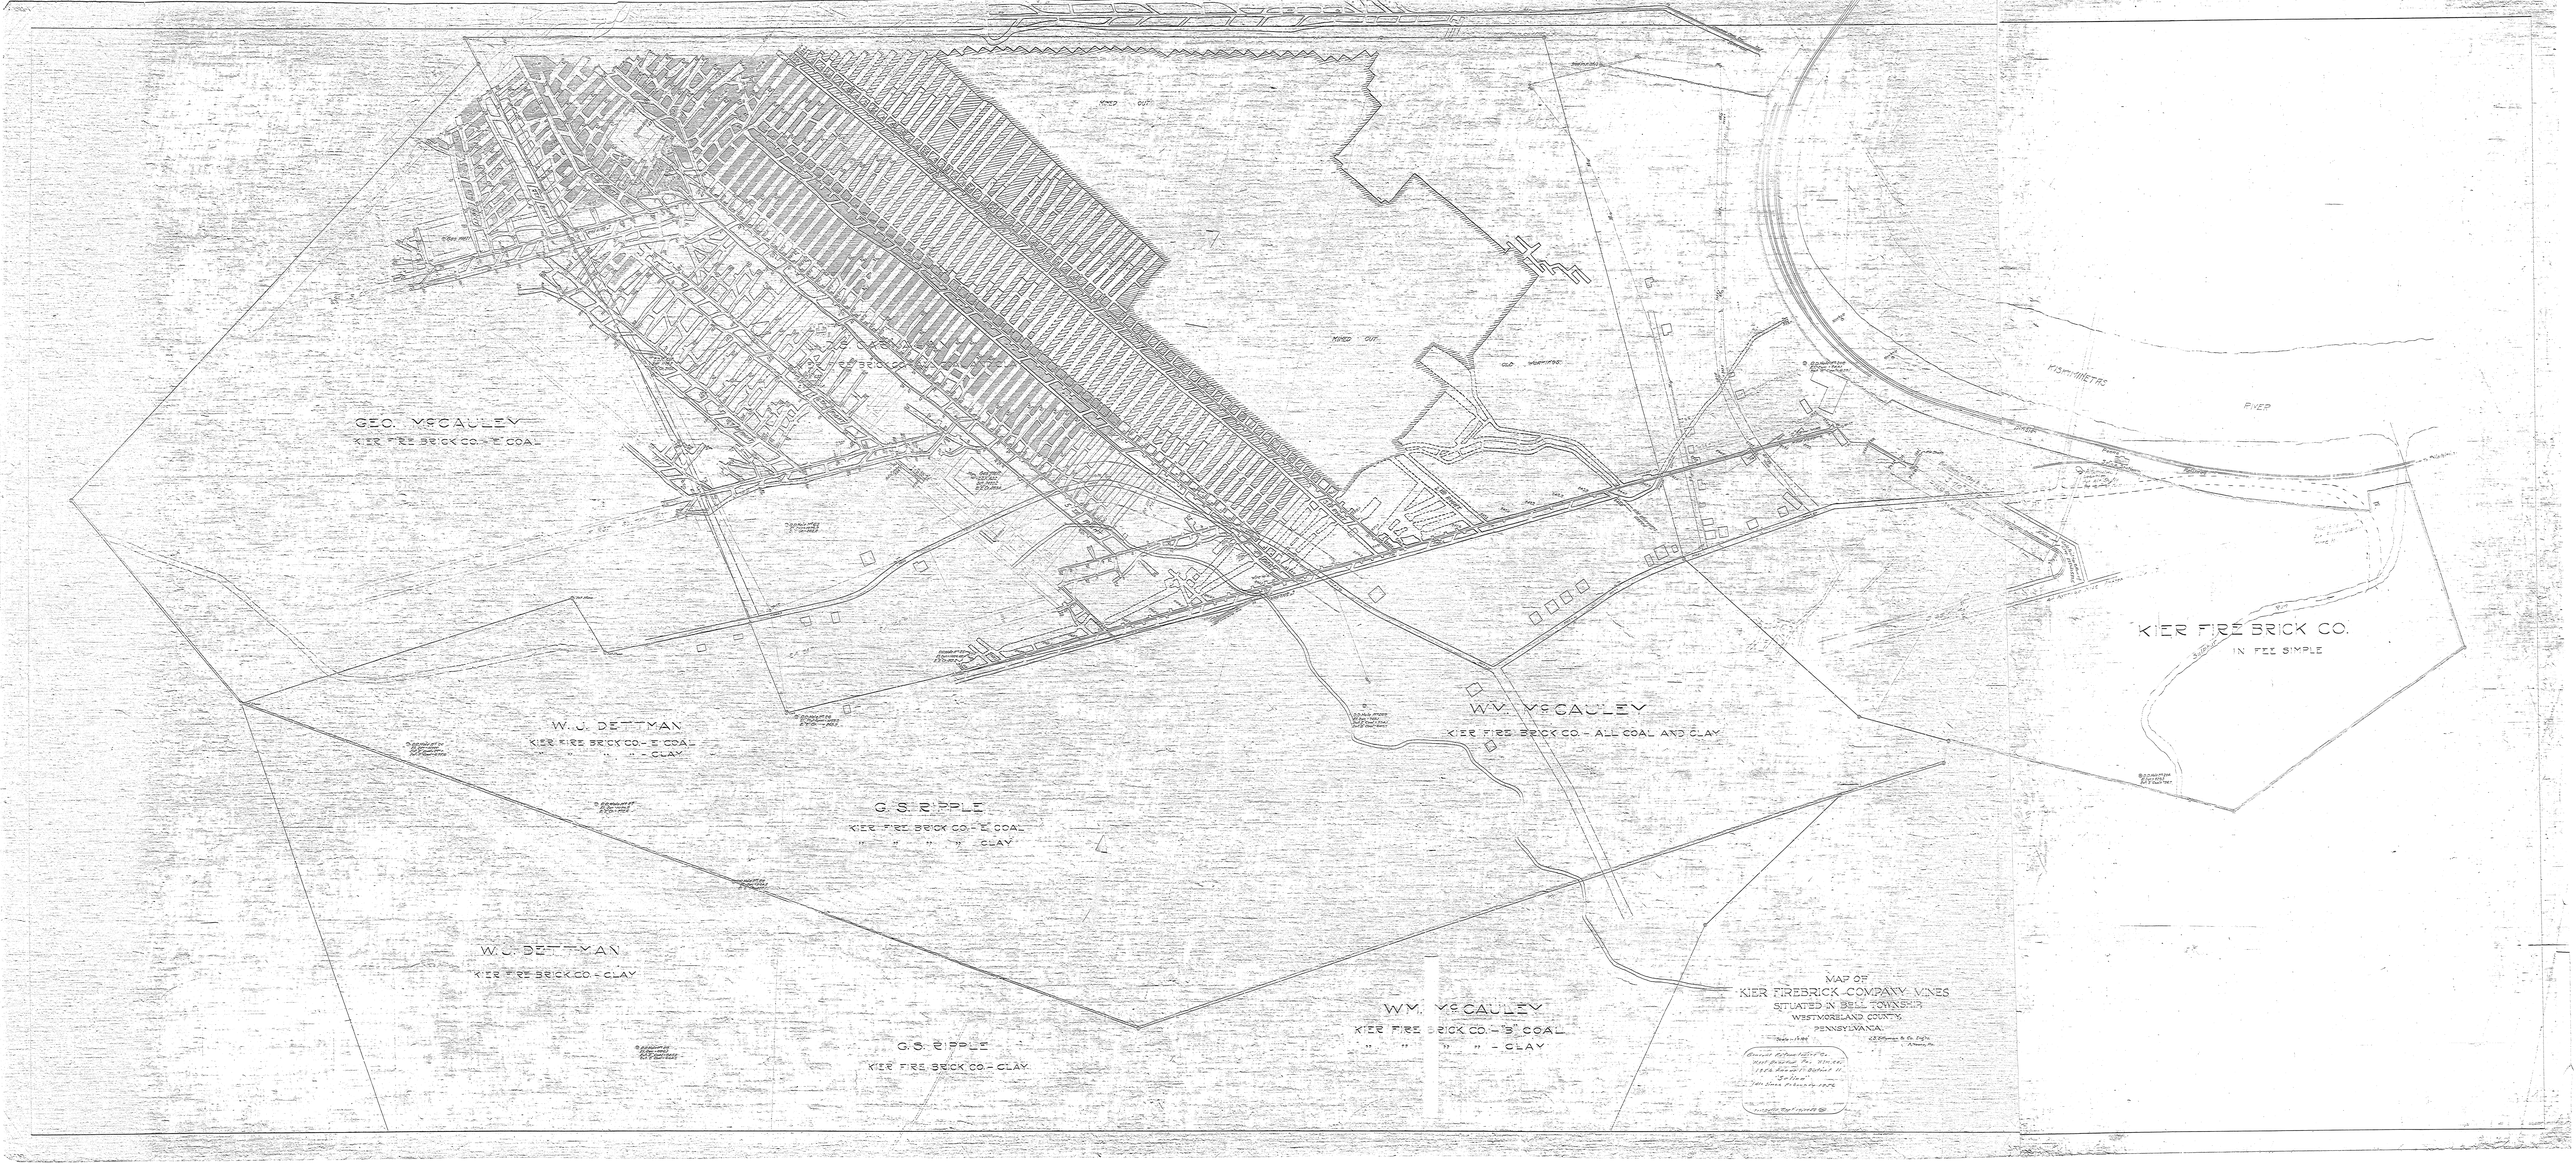
GEO. McCAULEY
KIER FIRE BRICK CO. - E COAL
W. J. DETTMAN
KIER FIRE BRICK CO. - E COAL
" " " - CLAY
G. S. RIPPLE
KIER FIRE BRICK CO. - E COAL
" " " " CLAY
W. J. DETTMAN
KIER FIRE BRICK CO. - CLAY
G. S. RIPPLE
KIER FIRE BRICK CO. - CLAY
WM. McCAULEY
KIER FIRE BRICK CO. - B COAL
" " " " - CLAY
WM. McCAULEY
KIER FIRE BRICK CO. - ALL COAL AND CLAY
KIER FIRE BRICK CO.
IN FEE SIMPLE
MINED OUT
MINED OUT
OLD WORKINGS
RIVER
MAP OF
KIER FIREBRICK COMPANY MINES
SITUATED IN BELL TOWNSHIP
WESTMORELAND COUNTY,
PENNSYLVANIA.