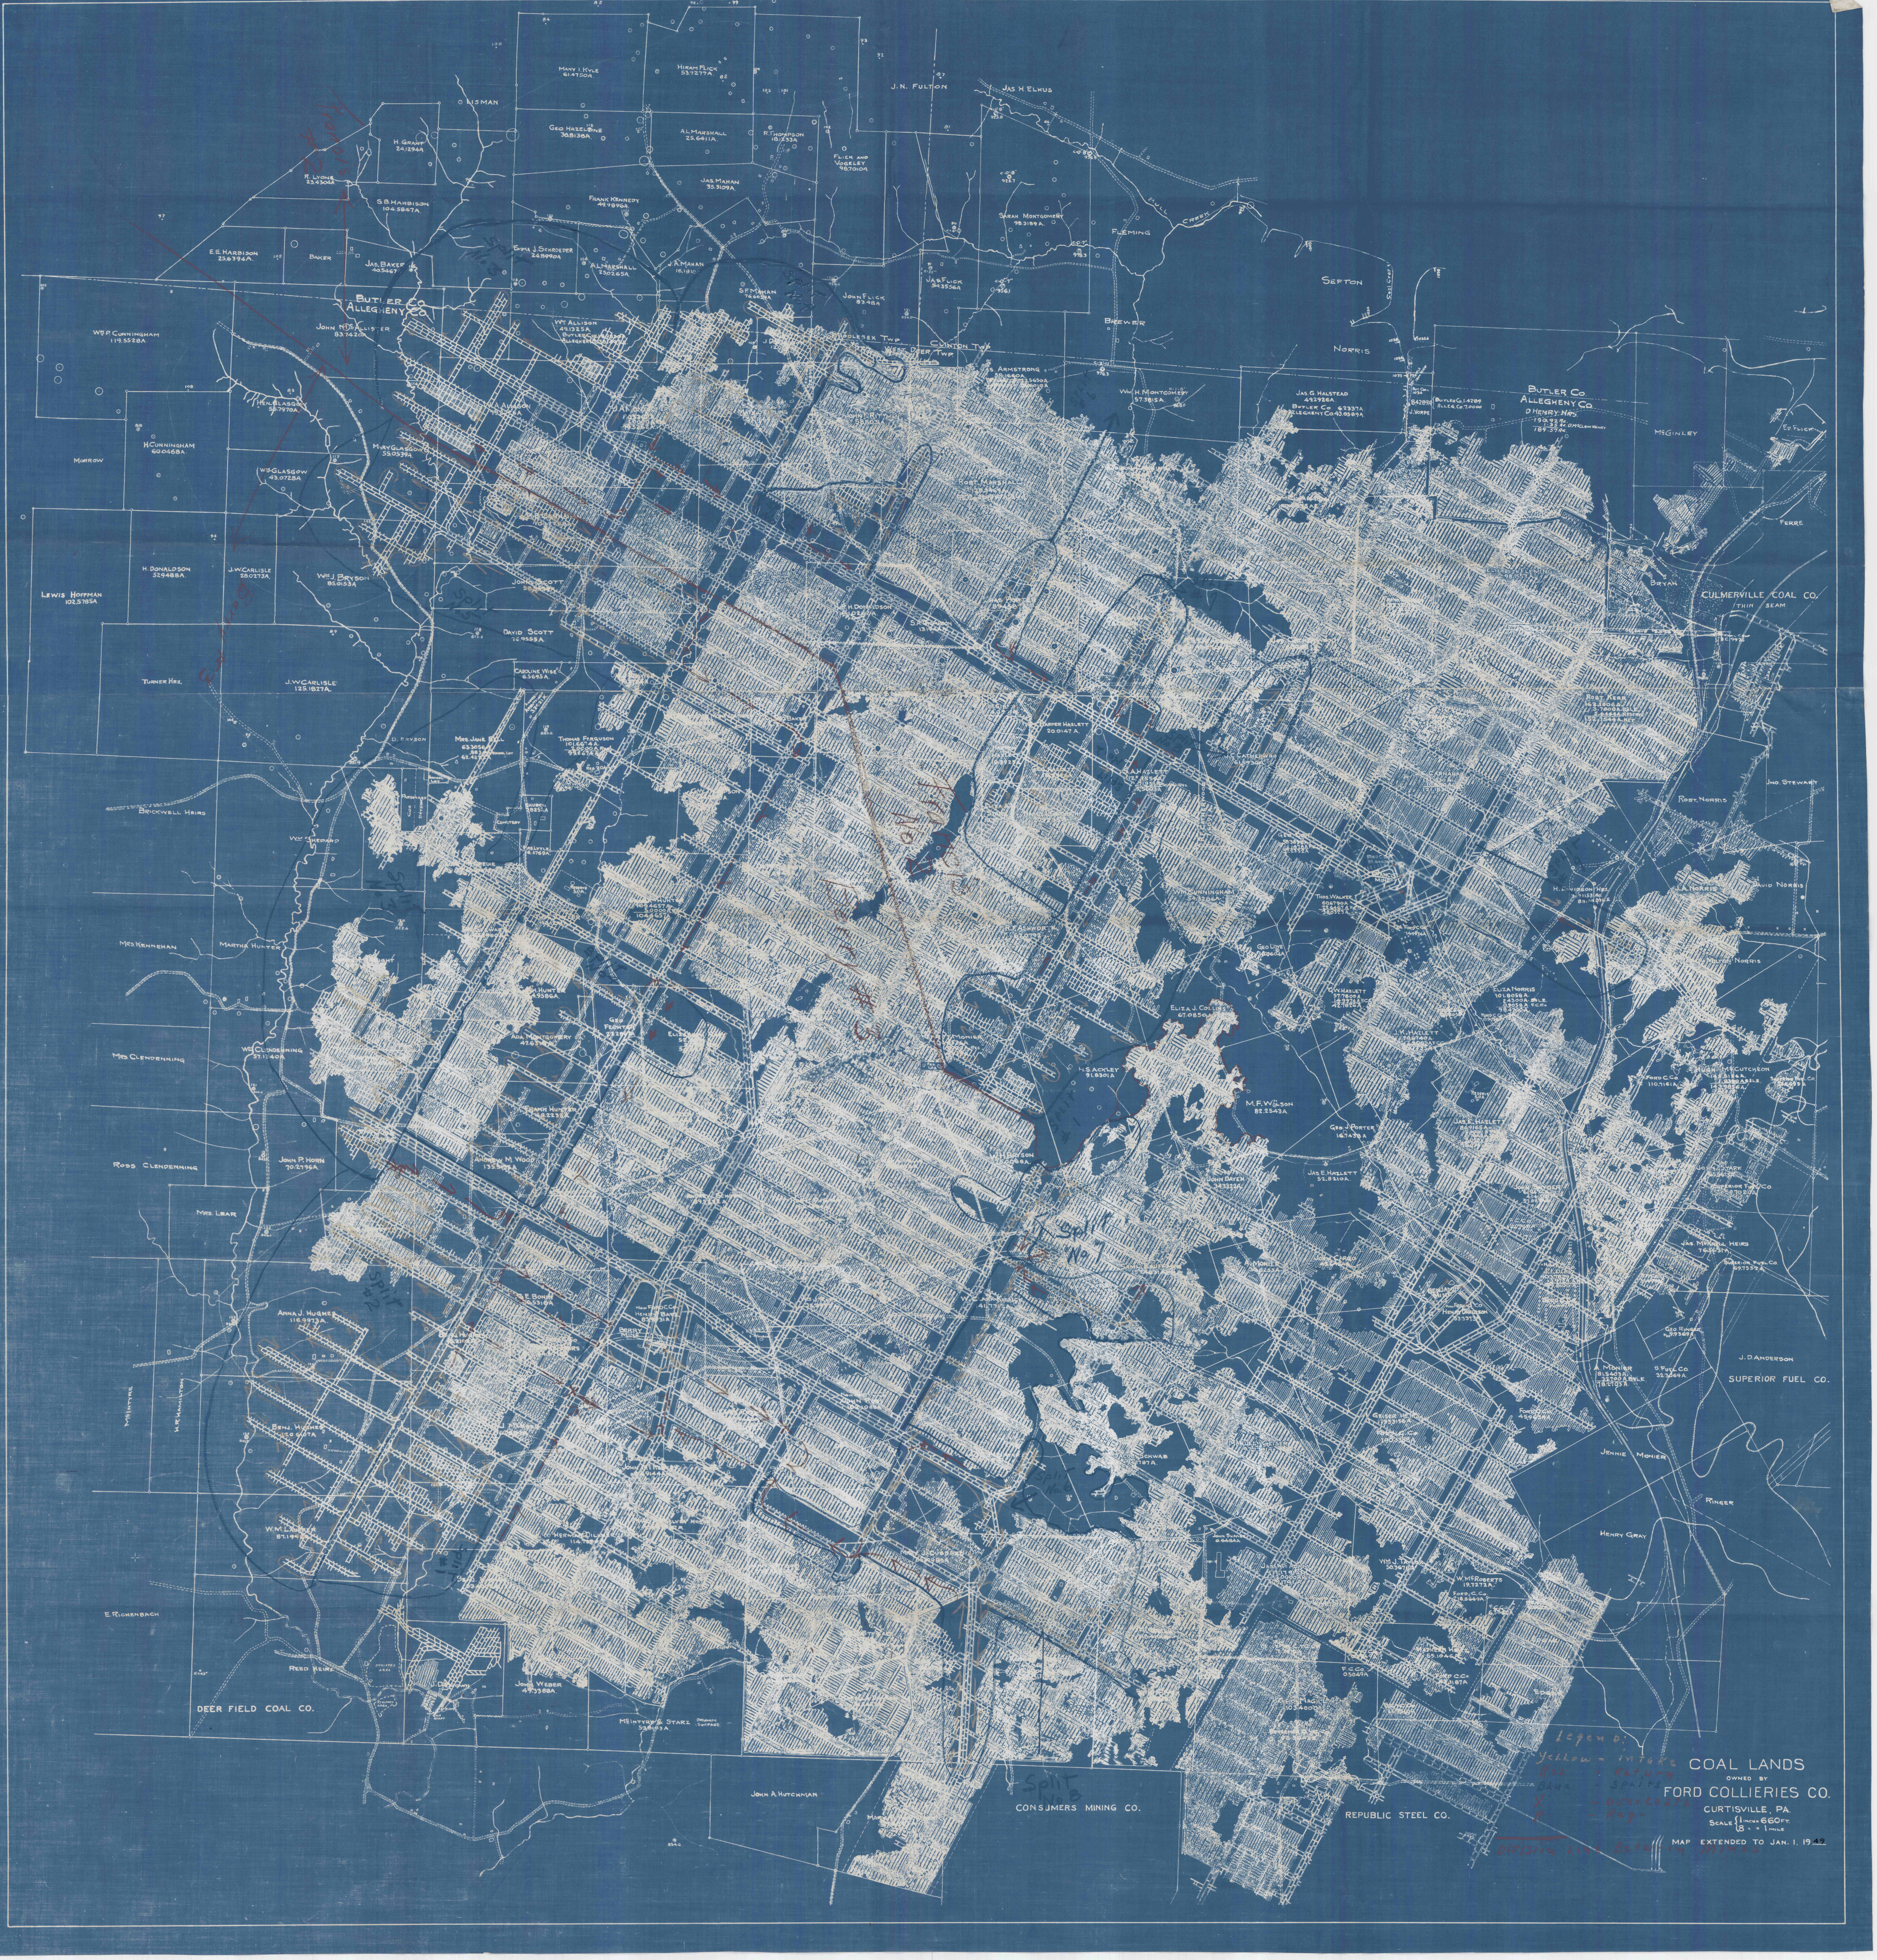

COAL LANDS

OWNED BY

FORD COLLIERIES CO.

CURTISVILLE, PA.

SCALE {1 INCH = 660 FT. 8 " = 1 MILE

MAP EXTENDED TO JAN. 1, 1949

Legend:

Yellow = intake

Red - Return

Blue - Splits

X - overcasts

R - Reg-

Division Line Between Mines

LISMAN
MARY I. KYLE 61.4750A.
HIRAM FLICK 53.7277A.
J.N. FULTON
JAS. H. ELKUS
H. GRANT 24.1294A
GEO. HAZELTINE 38.8138A.
A.L. MARSHALL 25.6411A.
R. THOMPSON 18.1233A.
FLICK AND VOGELEY 98.7010A
R. LYONS 23.4304A.
S.B. HARBISON 104.5847A.
JAS. MAHAN 35.3109A.
FRANK KENNEDY 49.9896A.
SARAH MONTGOMERY 98.3189 A.
FLEMING
BULL CREEK
E.E. HARBISON 25.6394A.
BAKER
JAS. BAKER 40.5467
EMMA J. SCHROEDER 24.8990A
A.L. MARSHALL 25.0265A.
J.A. MAHAN 16.1810
S.F. MAHAN 76.6659A.
JOHN FLICK 83.48A
JAS. FLICK 54.3556A
SEFTON
BREWER
NORRIS
Coal Crop
BUTLER CO.
ALLEGHENY CO.
Wm. P. CUNNINGHAM 119.5528A.
JOHN McALLISTER 83.7420
Wm. ALLISON 49.1325A.
MIDDLESEX TWP.
CLINTON TWP.
WEST DEER TWP.
S. ARMSTRONG 59.1660A.
Wm. H. MONTGOMERY 57.3815A.
JAS. G. HALSTEAD 49.2926A. BUTLER CO. 6.2337A ALLEGHENY CO. 43.0589A.
84289A
J. VORPE
BUTLER CO. 1.4289 ALLEG. CO. 7.0000
D. HENRY HRS. 190.92 AC. 1.35 AC. D. McCLAIN HENRY 189.57 AC.
McGINLEY
ED. FLICK
HEN. GLASGOW 55.7970A.
MARY GLASGOW 55.0539A.
Wm. GLASGOW 43.0728A.
MORROW
H. CUNNINGHAM 60.0468A.
ROBT. MARSHALL
JOHN F. RUTTMAN
FERRE
H. DONALDSON 529488A.
J.W. CARLISLE 28.0273A.
Wm. J. BRYSON 85.0153A
LEWIS HOFFMAN 102.5785A
JOHN SCOTT
J. MARSHALL 154.5775A.
H. DONALDSON
S.A. DONALDSON 13.19
DAVID SCOTT 76.9555A.
ELIZABETH FLEMING 98.1553
BRYAN
CULMERVILLE COAL CO.
THIN SEAM
TURNER HRS.
J.W. CARLISLE 125.1827A.
CAROLINE WISE 6.5695A.
ROBT. KERR
HARPER HAZLETT 20.0147 A.
D. BRYSON
MRS. JANE BELL 63.3056
THOMAS FERGUSON 101.6674A.
BRICKWELL HEIRS
PARSONAGE
SCHOOL LOT
CHURCH
CEMETERY
MRS. LYTLE 6.4769A.
Wm. SHEPARD
JNO. STEWART
ROBT. NORRIS
WM. CUNNINGHAM
THOS. WALKER 60.6790A.
H. DAVIDSON HRS.
J.A. NORRIS
DAVID NORRIS
MILTON NORRIS
MRS. KENNEHAN
MARTHA HUNTER
H. HUNTER 44.9586A.
GEO. LOVE
G.W. HAZLETT 57.7600A.
ELIZA NORRIS 101.8058A.
R.F. ASHWORTH
ADA MONTGOMERY 47.6
ELIZA J. COLLINS 67.0850A.
MRS. CLENDENNING
Wm. CLENDENNING 57.1340A
J.K. HAZLETT
H.S. ACKLEY 91.8301A
M.F. WILSON 82.2543A
FORD C. CO. 110.7161A
HUGH McCUTCHEON
FRANK HUNTER 48.2235A.
GEO. J. PORTER 16.7439A
JAS. E. HAZLETT 86.9165A.
ROSS CLENDENNING
JOHN P. HORN 70.2796A.
ANDREW M. WOOD 135.5
W.H. BRYSON
JOHN DAYEN 34.3322A.
JAS. E. HAZLETT 52.8210A.
JOHN STARK
SUPERIOR FUEL CO. 58.7020A.
MRS. LEAR
JAS. McKRELL HEIRS 7.6.5631A.
SUPERIOR FUEL CO. 69.7552A.
A. MONIER
BERRY MINE
FORD C. CO. HENRY DAVIDSON
GEO. RINGER 9.9369A.
J.D. ANDERSON
A. MONIER 81.5403A. 3.2700A. BBLE. 78.2703A.
S. FUEL CO. 32.3069A.
SUPERIOR FUEL CO.
ANNA J. HUGHES 116.9973A.
S.E. BONN
FORD C. CO. 45.9698A.
McINTYRE
H.R. HAMILTON
BENJ. HUGHES 120.6107A.
JACOB SCHWAB 24.1187A.
JENNIE MONIER
RINGER
W.M. LAUFFER 87.1994
JOHN SHANER 0.6484A.
HENRY GRAY
WM. J. TAYLOR 50.3678A.
W. McROBERTS 19.7272A.
FORD C. CO. 218.8649A.
E. RICHENBACH
STRIPPED AREA
REED HEIRS
JOHN WEBER 49.3388A.
F.C. CO. 0.5049A
FORD C. CO.
GEO. MAGILL 103.4000A.
EDGAR
DEER FIELD COAL CO.
McINTYRE & STARZ DRUMM SURFACE 53.8103A.
JOHN A. HUTCHMAN
CONSUMERS MINING CO.
REPUBLIC STEEL CO.
Split No. 1
Split #1
Split #2
Split No. 3
Split No. 4
Split No. 5
Split No. 6
Split No. 7
Split No. 8
Split #3
Splits #2
Bank #3