


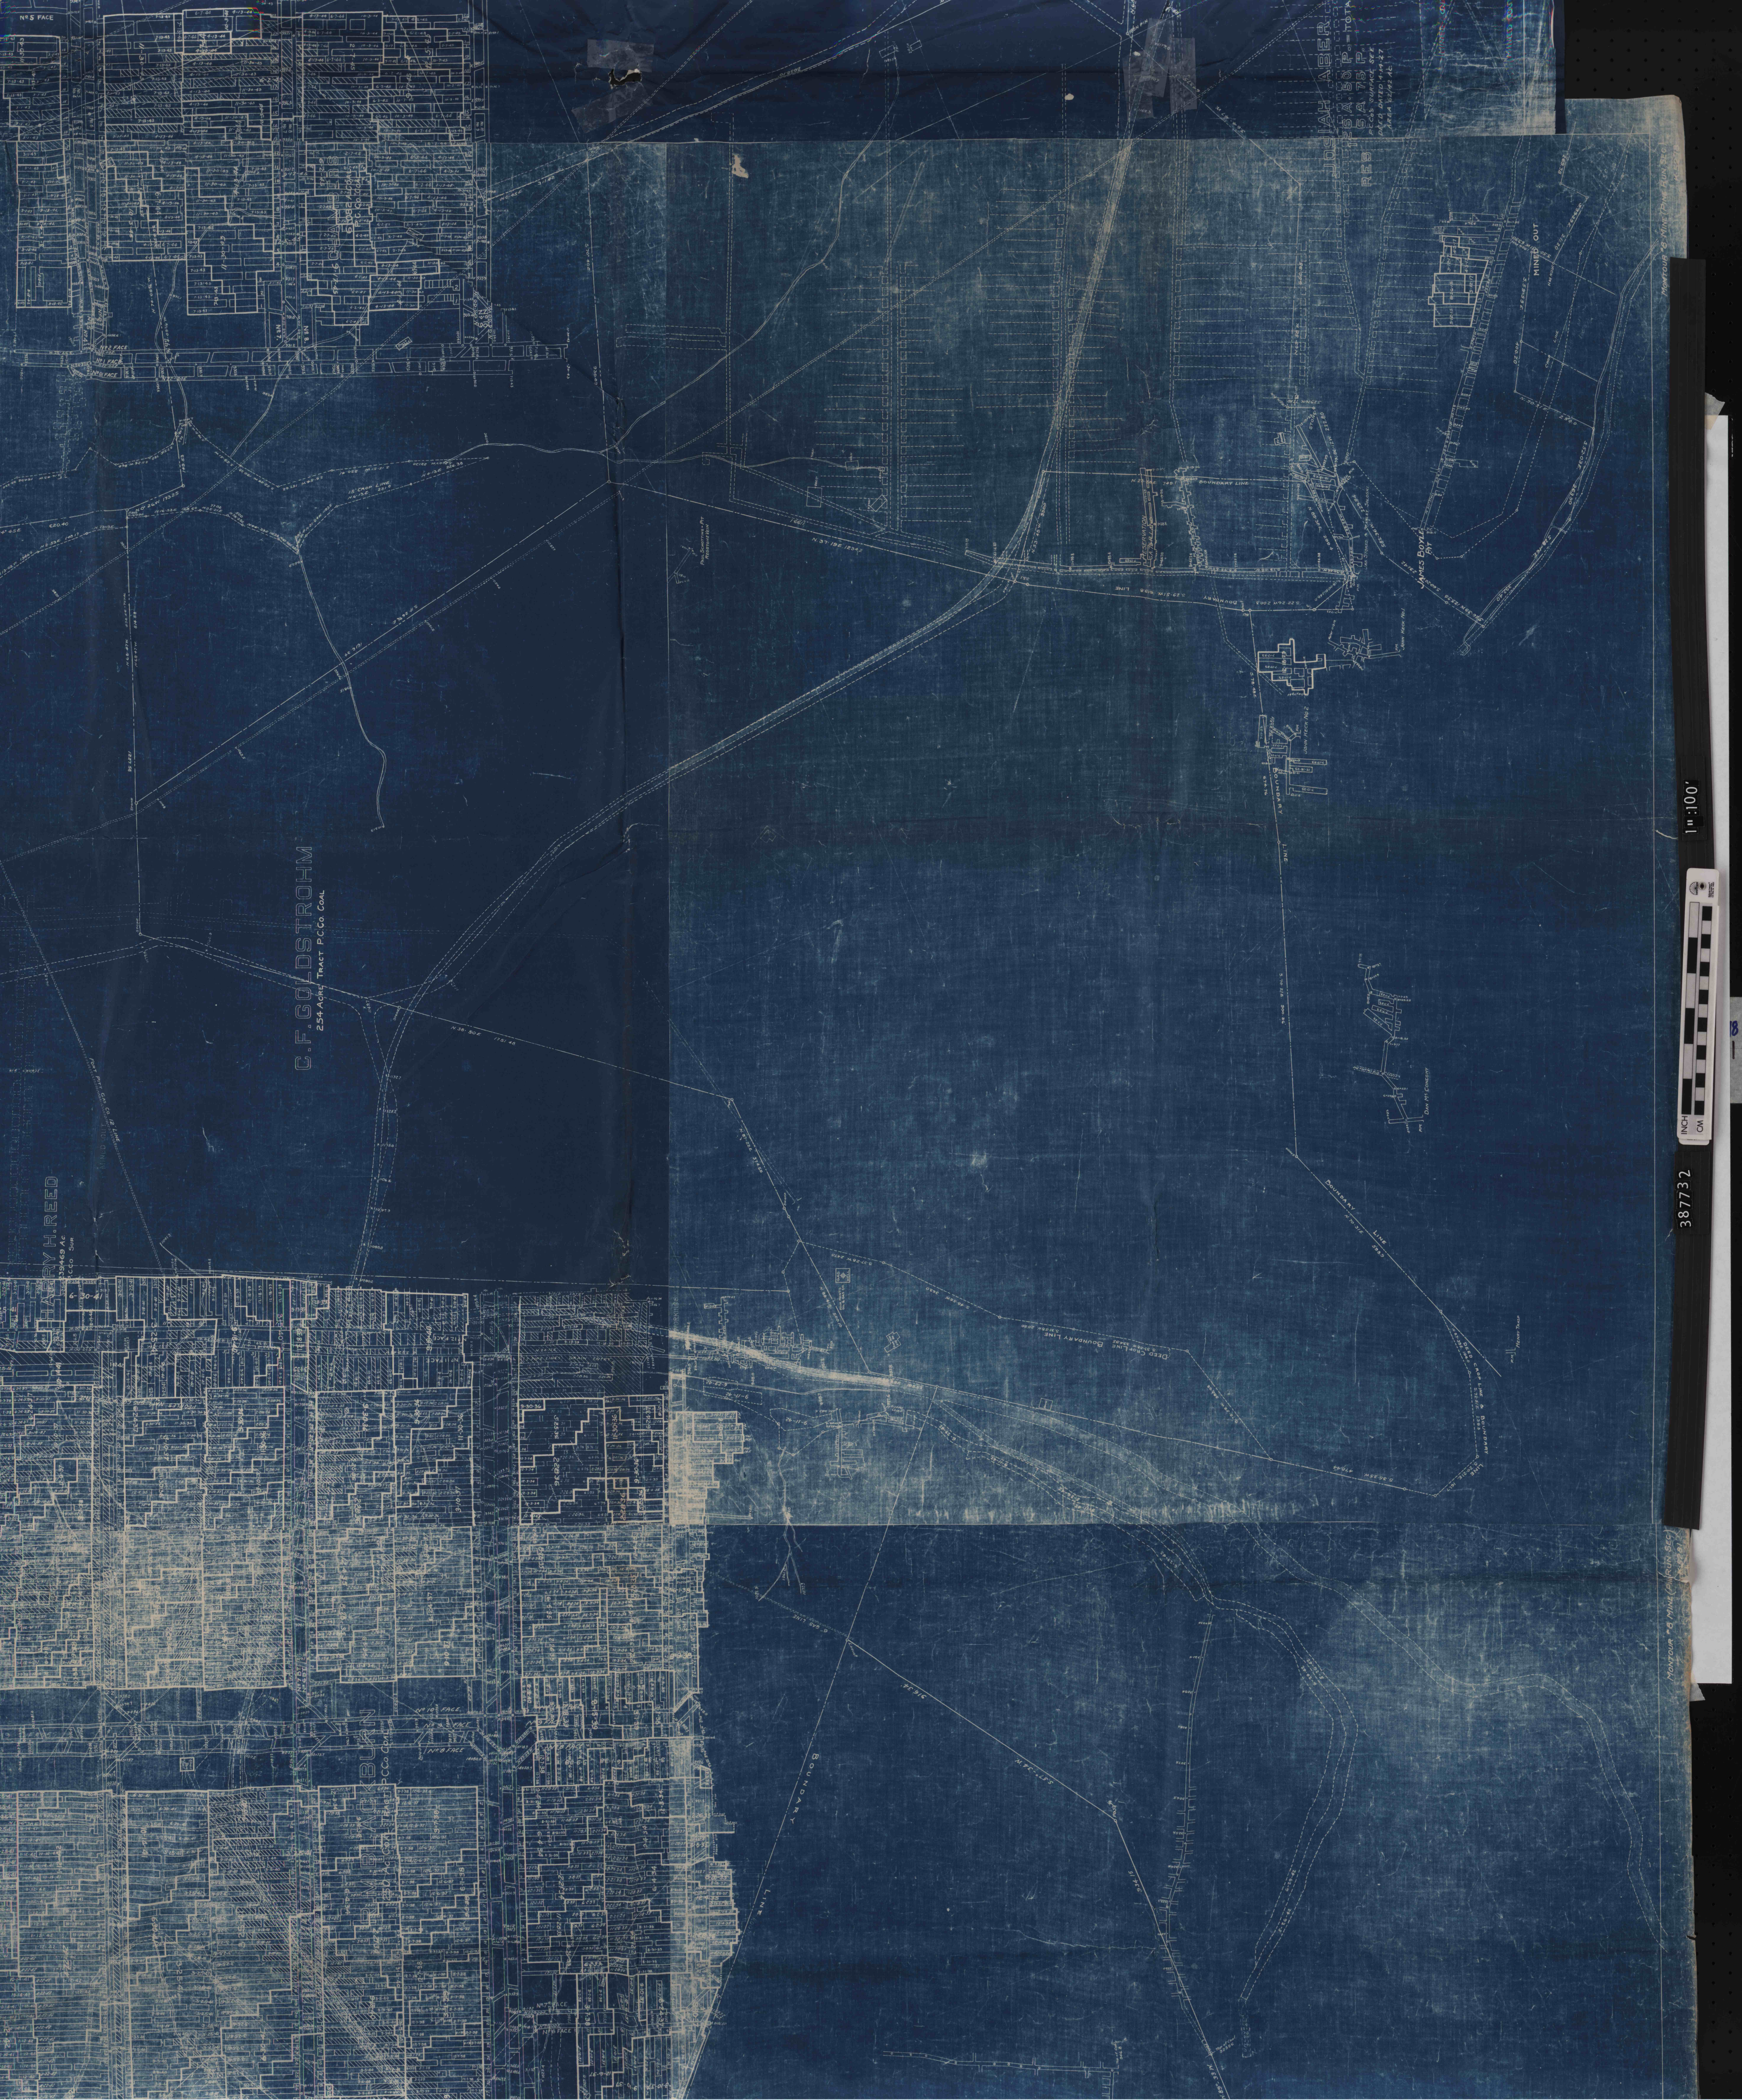

C.F. GOLDSTROHM
254 ACRES, Tract P.C. Co. COAL

HARRY H. REED

JAMES BOYCE
MINED OUT