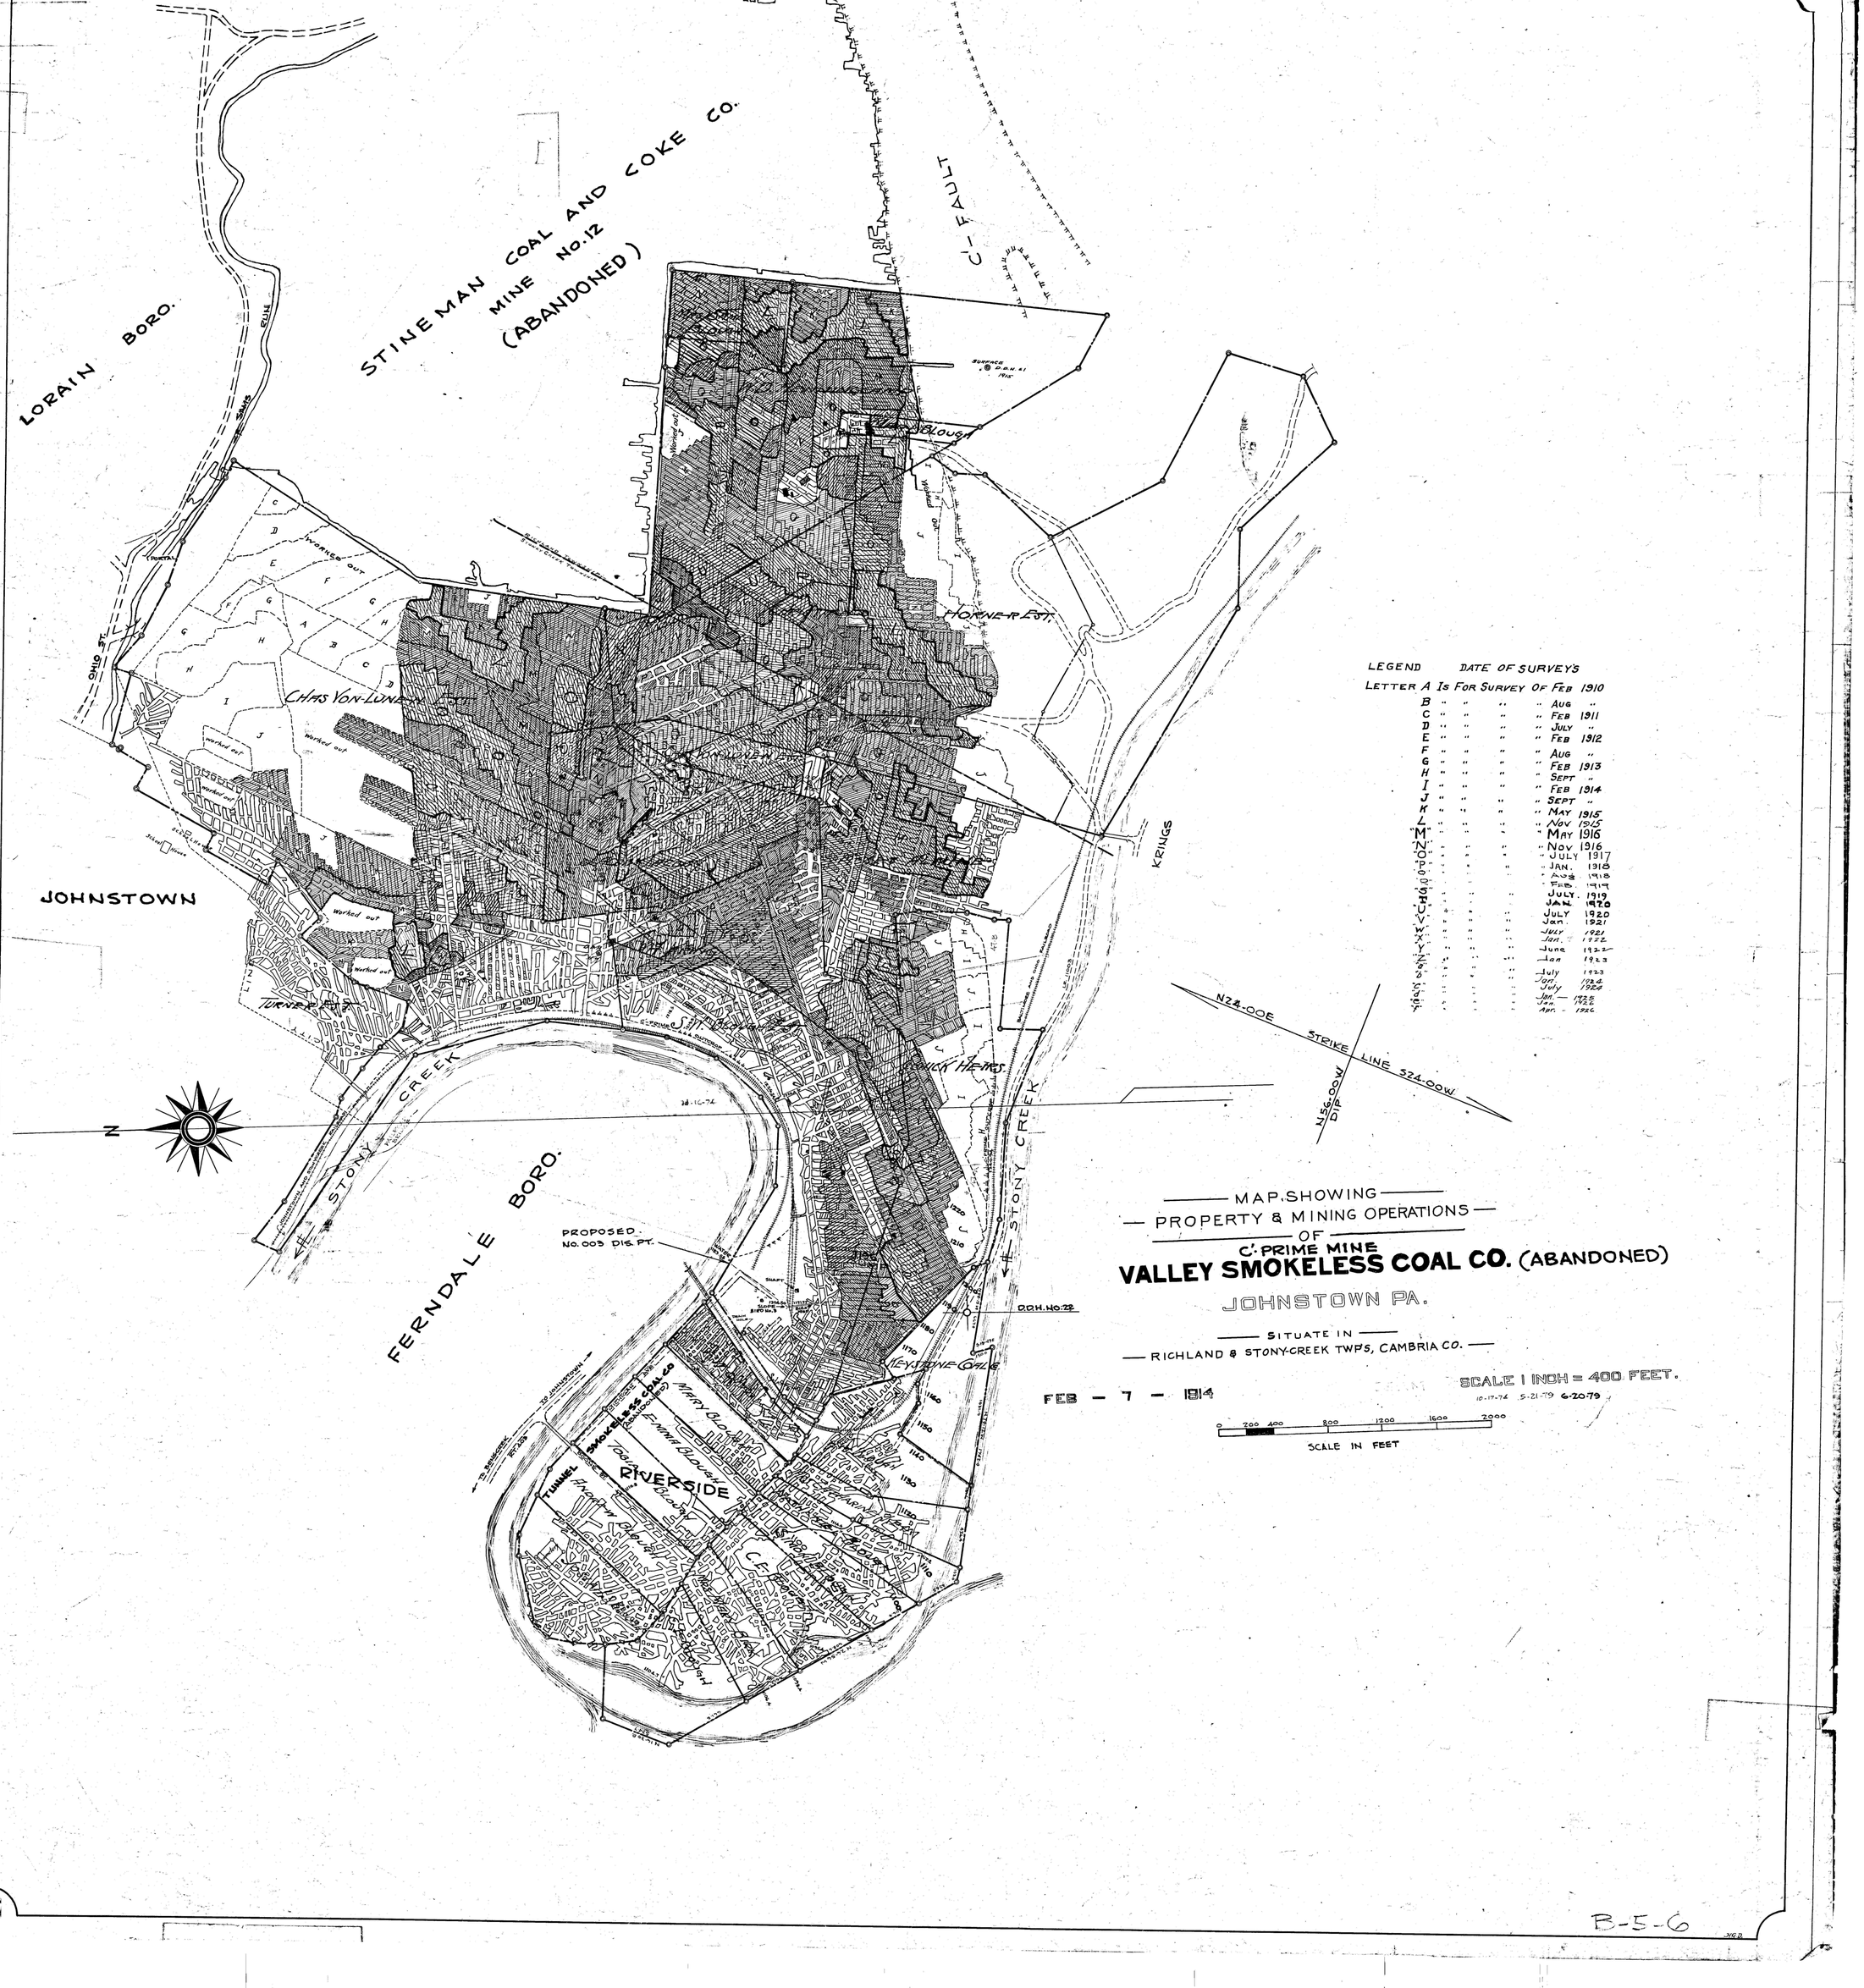
STINEMAN COAL AND COKE CO.
MINE No. 12
(ABANDONED)
LORAIN BORO.
C-FAULT
JOHNSTOWN
FERNDALE BORO.
STONY CREEK
RIVERSIDE
CHAS VON LUNEN
HORNER EST.
KRINGS
N24.00E
STRIKE LINE S24.00W
N56.00W
DIP
PROPOSED
No. 003 DIS. PT.
D.D.H. NO. 22
LEGEND DATE OF SURVEYS
LETTER A IS FOR SURVEY OF FEB 1910
B " " " " AUG "
C " " " " FEB 1911
D " " " " JULY "
E " " " " FEB 1912
F " " " " AUG "
G " " " " FEB 1913
H " " " " SEPT "
I " " " " FEB 1914
J " " " " SEPT "
K " " " " MAY 1915
L " " " " NOV 1915
M " " " " MAY 1916
N " " " " NOV 1916
O " " " " JULY 1917
P " " " " JAN. 1918
Q " " " " AUG 1918
R " " " " FEB. 1919
S " " " " JULY. 1919
T " " " " JAN. 1920
U " " " " JULY 1920
V " " " " JAN 1921
W " " " " JULY 1921
X " " " " JAN. 1922
Y " " " " JUNE 1922
Z " " " " JAN 1923
AA " " " " JULY 1923
BB " " " " OCT. 1924
CC " " " " JULY 1924
DD " " " " JAN. 1925
EE " " " " JAN 1926
APR. 1926
MAP SHOWING
PROPERTY & MINING OPERATIONS
OF
C. PRIME MINE
VALLEY SMOKELESS COAL CO. (ABANDONED)
JOHNSTOWN PA.
SITUATE IN
RICHLAND & STONY-CREEK TWPS, CAMBRIA CO.
FEB - 7 - 1914
SCALE 1 INCH = 400 FEET.
10-17-74 5-21-79 6-20-79
0 200 400 800 1200 1600 2000
SCALE IN FEET
B-5-6