


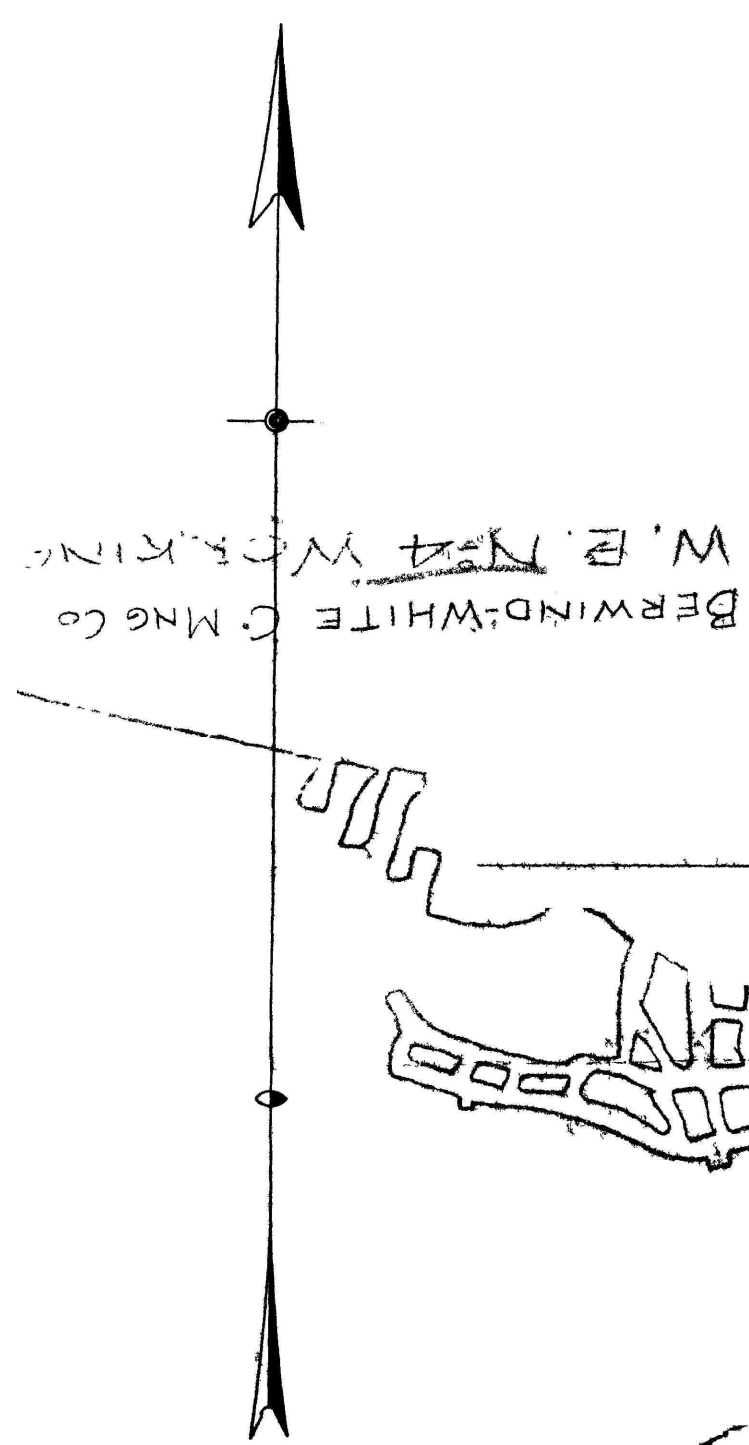

BERWIND-WHITE CO. MNG CO

JOS. B. MEANS
[E. R. CO. ROYALTY]

CHRIST. B. SUTHER

DATE OF LAST SURVEY
Nov. 2, 1918
June 7, 1919
Sept. 9, 1919
May 1, 1920
July 6, 1923
June 24, 1925
Dec. 12, 1925
Sept. 11, 1926
Mar. 30, 1927
July 3, 1929
Jan. 7, 1930
Dec. 22, 1930
Nov. 23, 1931

Scale 1"=100'

VALIER, PA.
The H. M. Kanarr Co.
Mining Engineers
Punkstowney, Pa.

BULAH SHAFT COAL CO.

THE VEGA MINE

OF
MINE OF

