


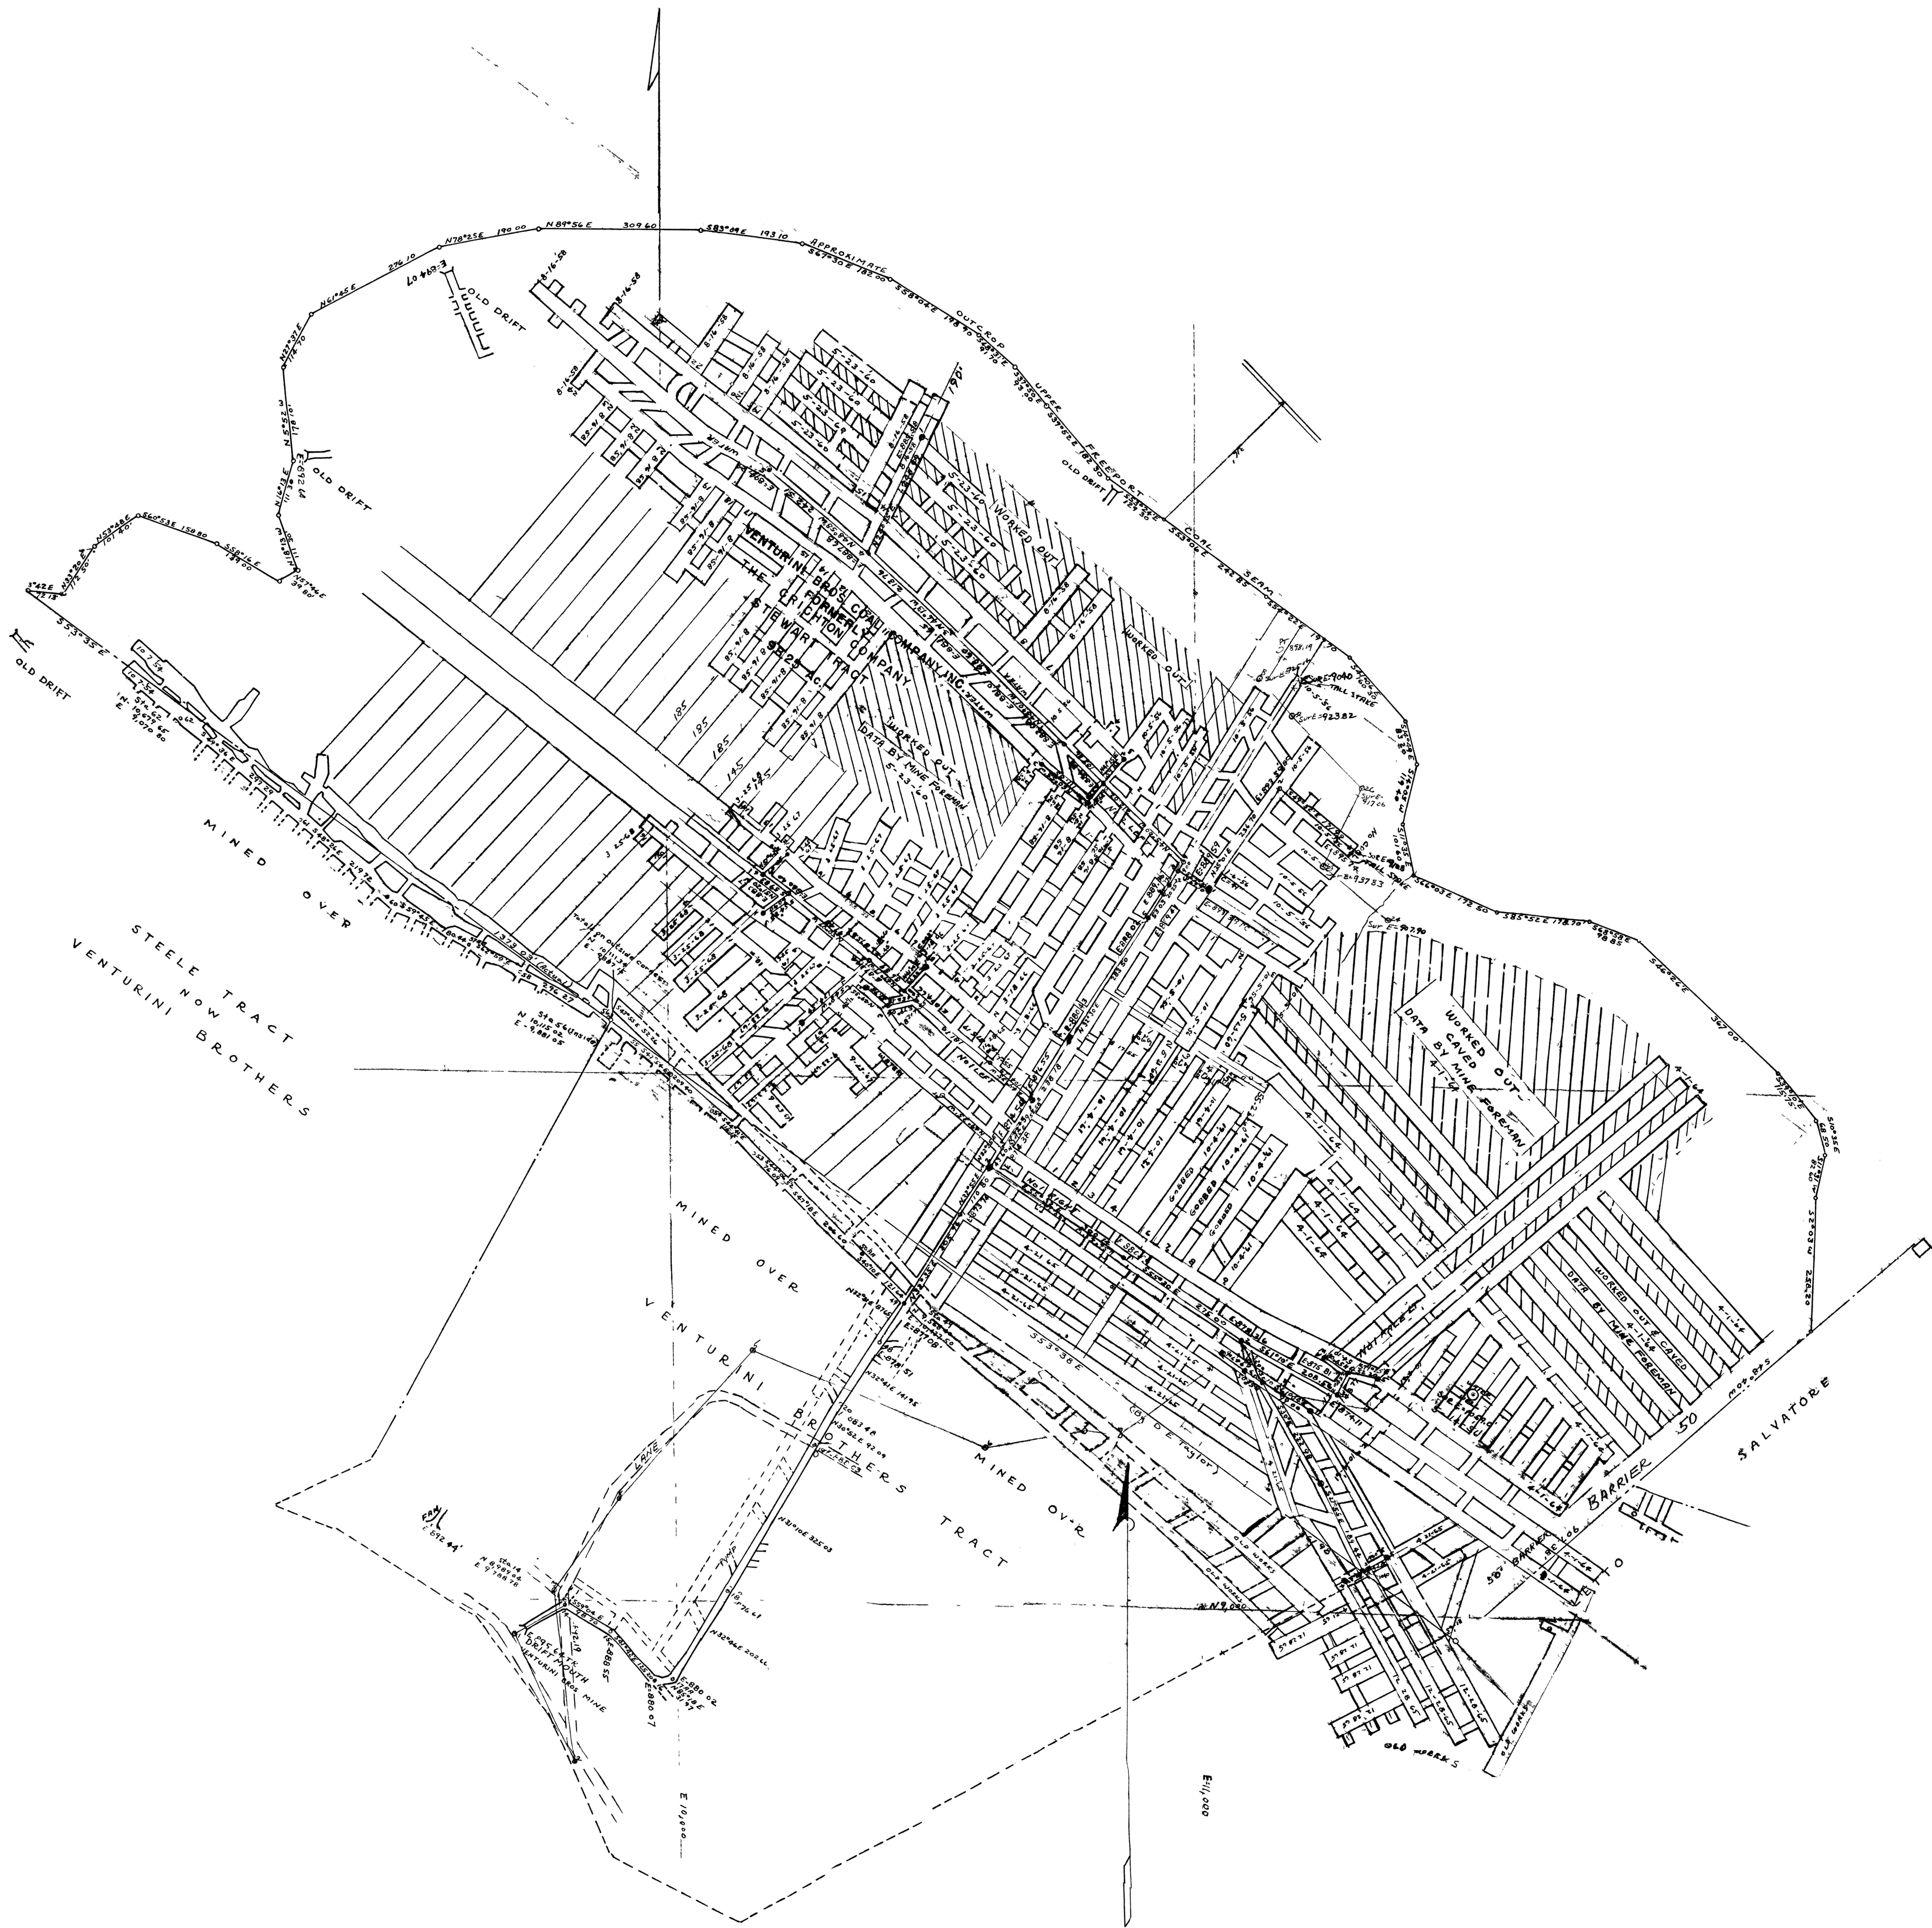

VENTURINI BROTHERS MINE
 IN UPPER FREEPORT SEAM
 ALLEGHENY TWP-WESTMORLAND CO-PA
 SCALE 1 INCH=100 FEET-SEPT 23, 1955
 DATA ON THIS MAP FROM SURVEYS BY THE CRICHTON CO ENGRS
 GEORGE S. BATTON & CO AND D. E. TAYLOR, REG ENGR
 CHARLES S. KLINGENSMITH
 R P S No 2286
 REVISED TO 3-25-62
 by a complete and final map
 Charles S. Klingensmith

LEGEND
 PROPERTY OUTLINE
 SIX MONTH PROJECT
 MINING COMPLETED