

#277
6-11-67

TANDOM COAL COMPANY
BLACK BEAUTY NO. 1 MINE
YOUNG TWP. INDIANA CO., PA.
(PITTSBURGH SEAM)
SURVEYED OCT. 5, 1963 BY H. BASH

SCALE: 1" = 100'

REVISED 7-2-65

9-26-66

9-18-67

12-8-67


4-11-68

10-9-68

Graft Engineering Co.
Blainville, Pa.

Coal Area
Working - Not 6 Months

Mined out
No Dwellings
Date: October 8, 1968 to April 19, 1969

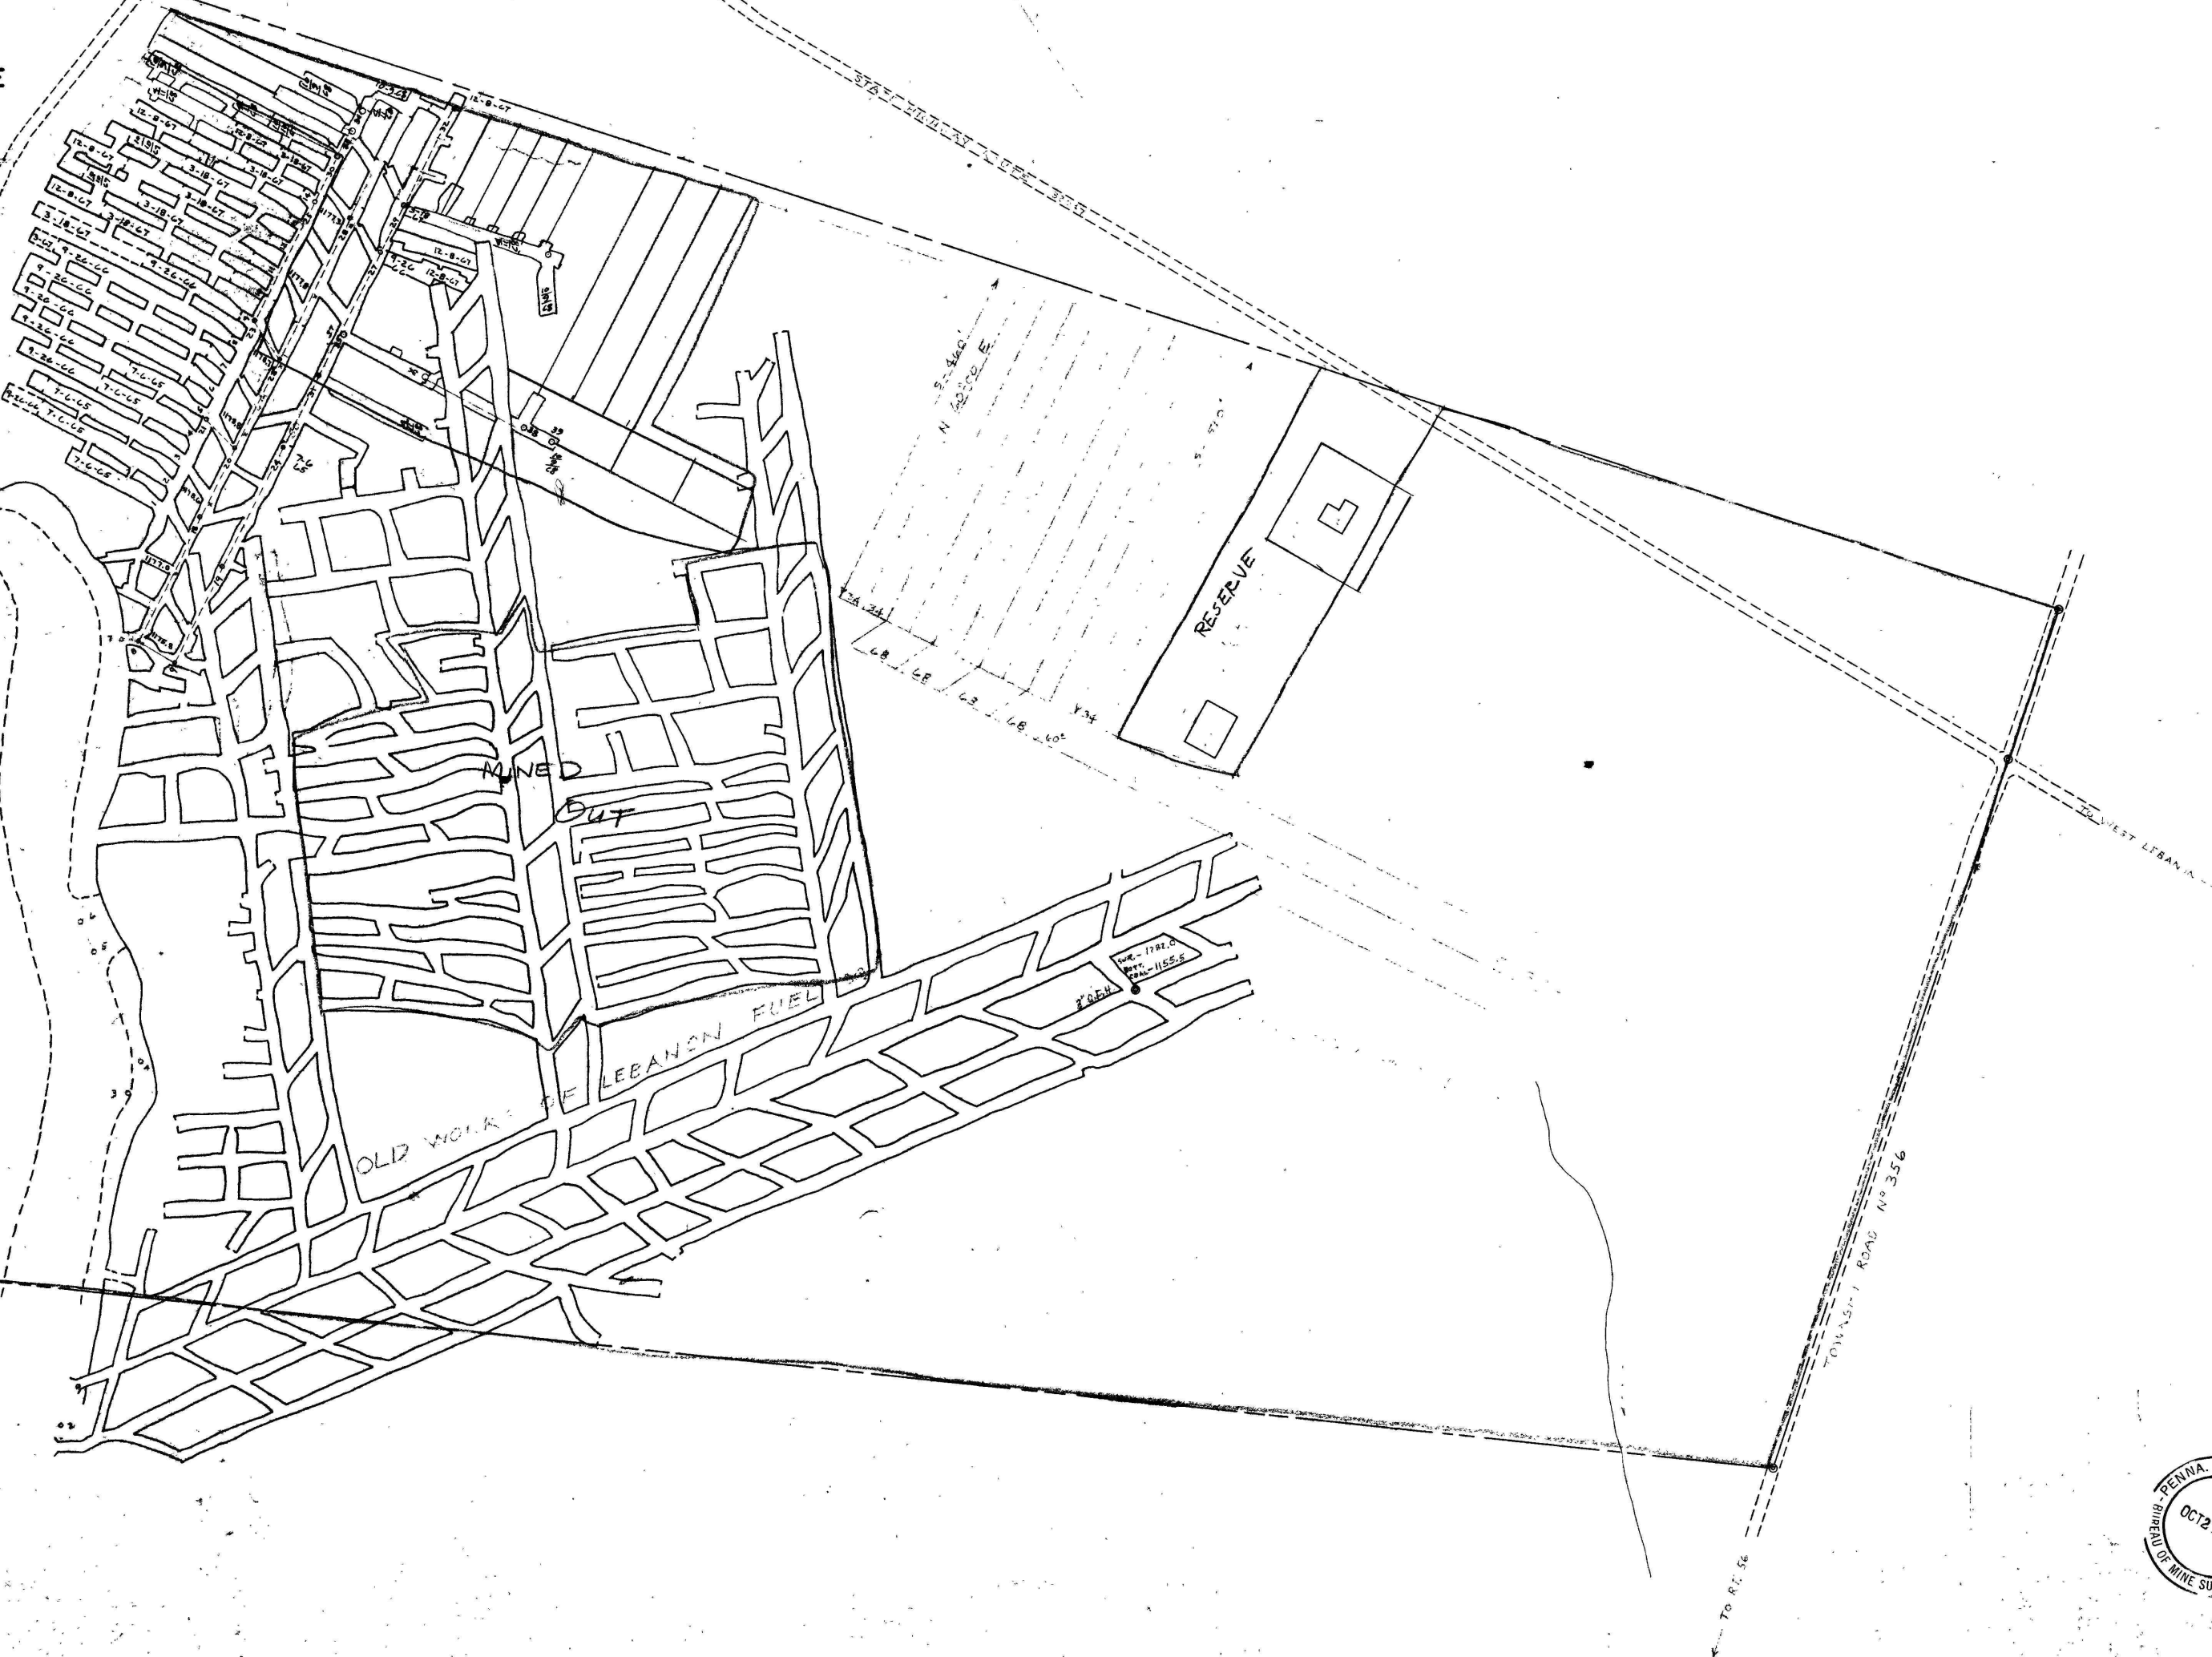

PENNA. DEPT. OF MINES
REC'D
OCT 21 1968
BUREAU OF MINE SUBSIDENCE