


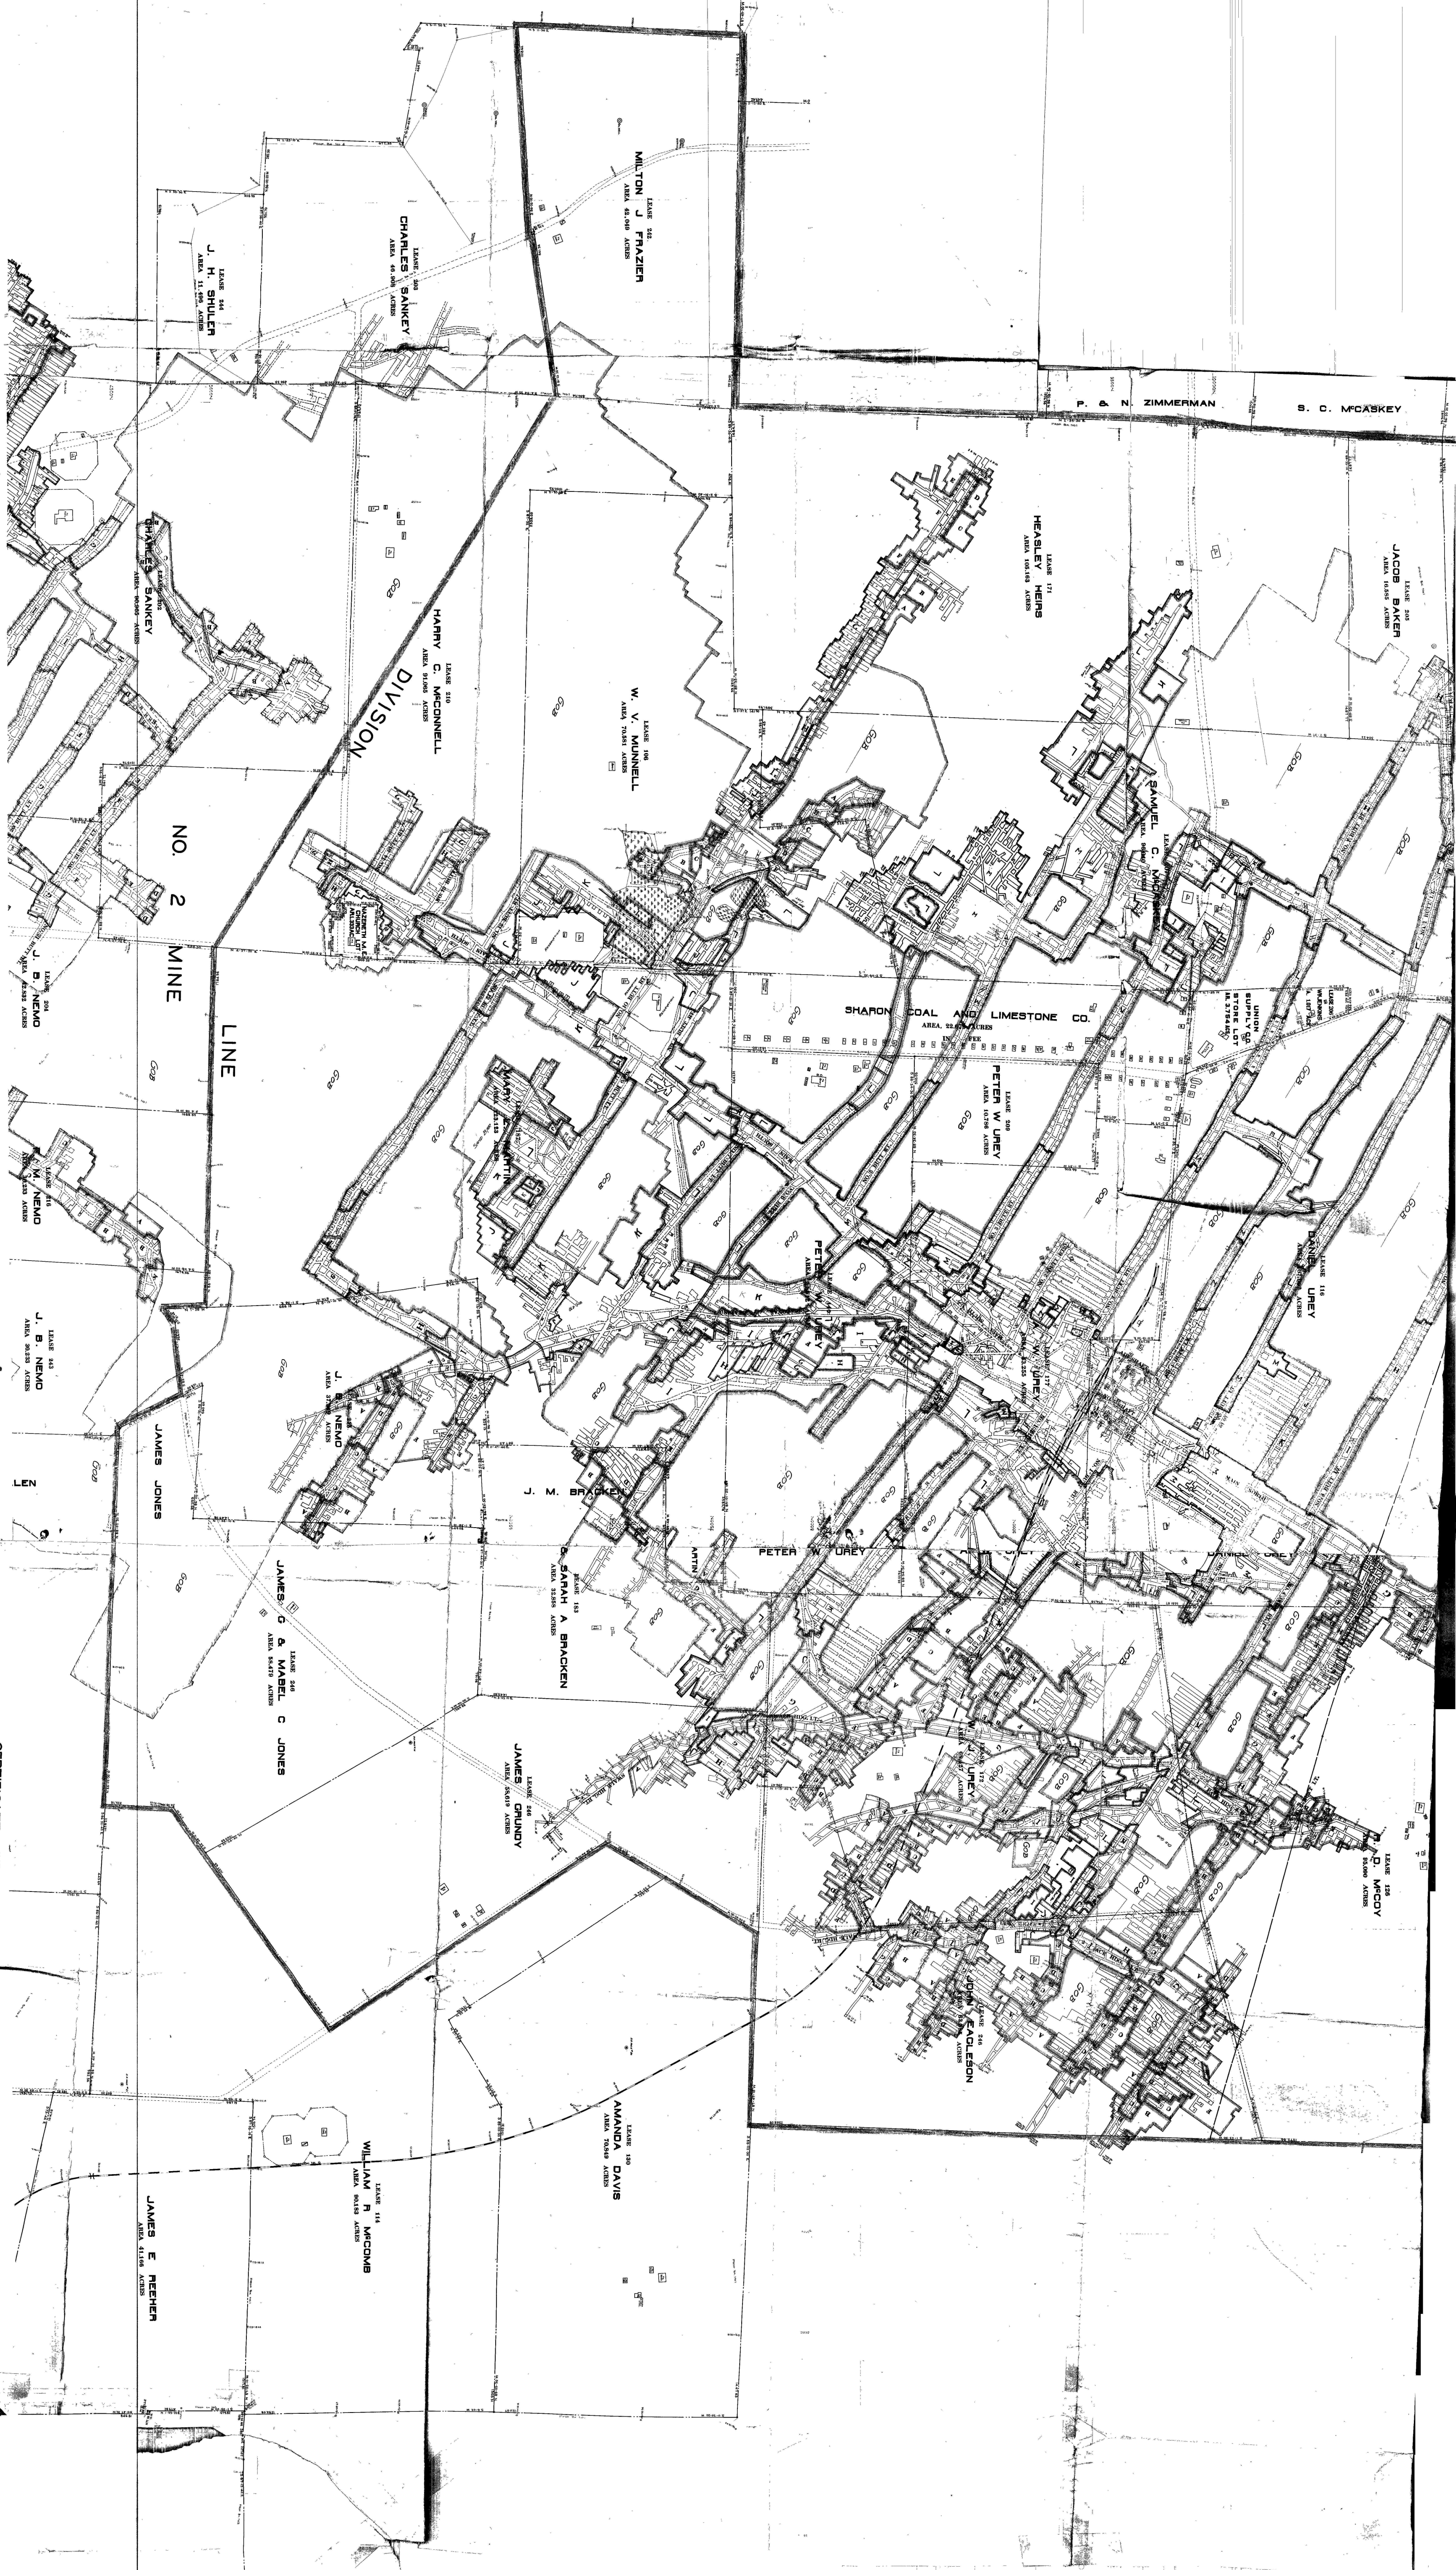

CERTIFICATE OF ENGINEER

I, the undersigned, hereby certify that this print is a true copy of Sharon No. 2 Mine and the information thereon is correct to the best of my knowledge.

Signed: *[Signature]* Chief Engineer
April 20, 1930