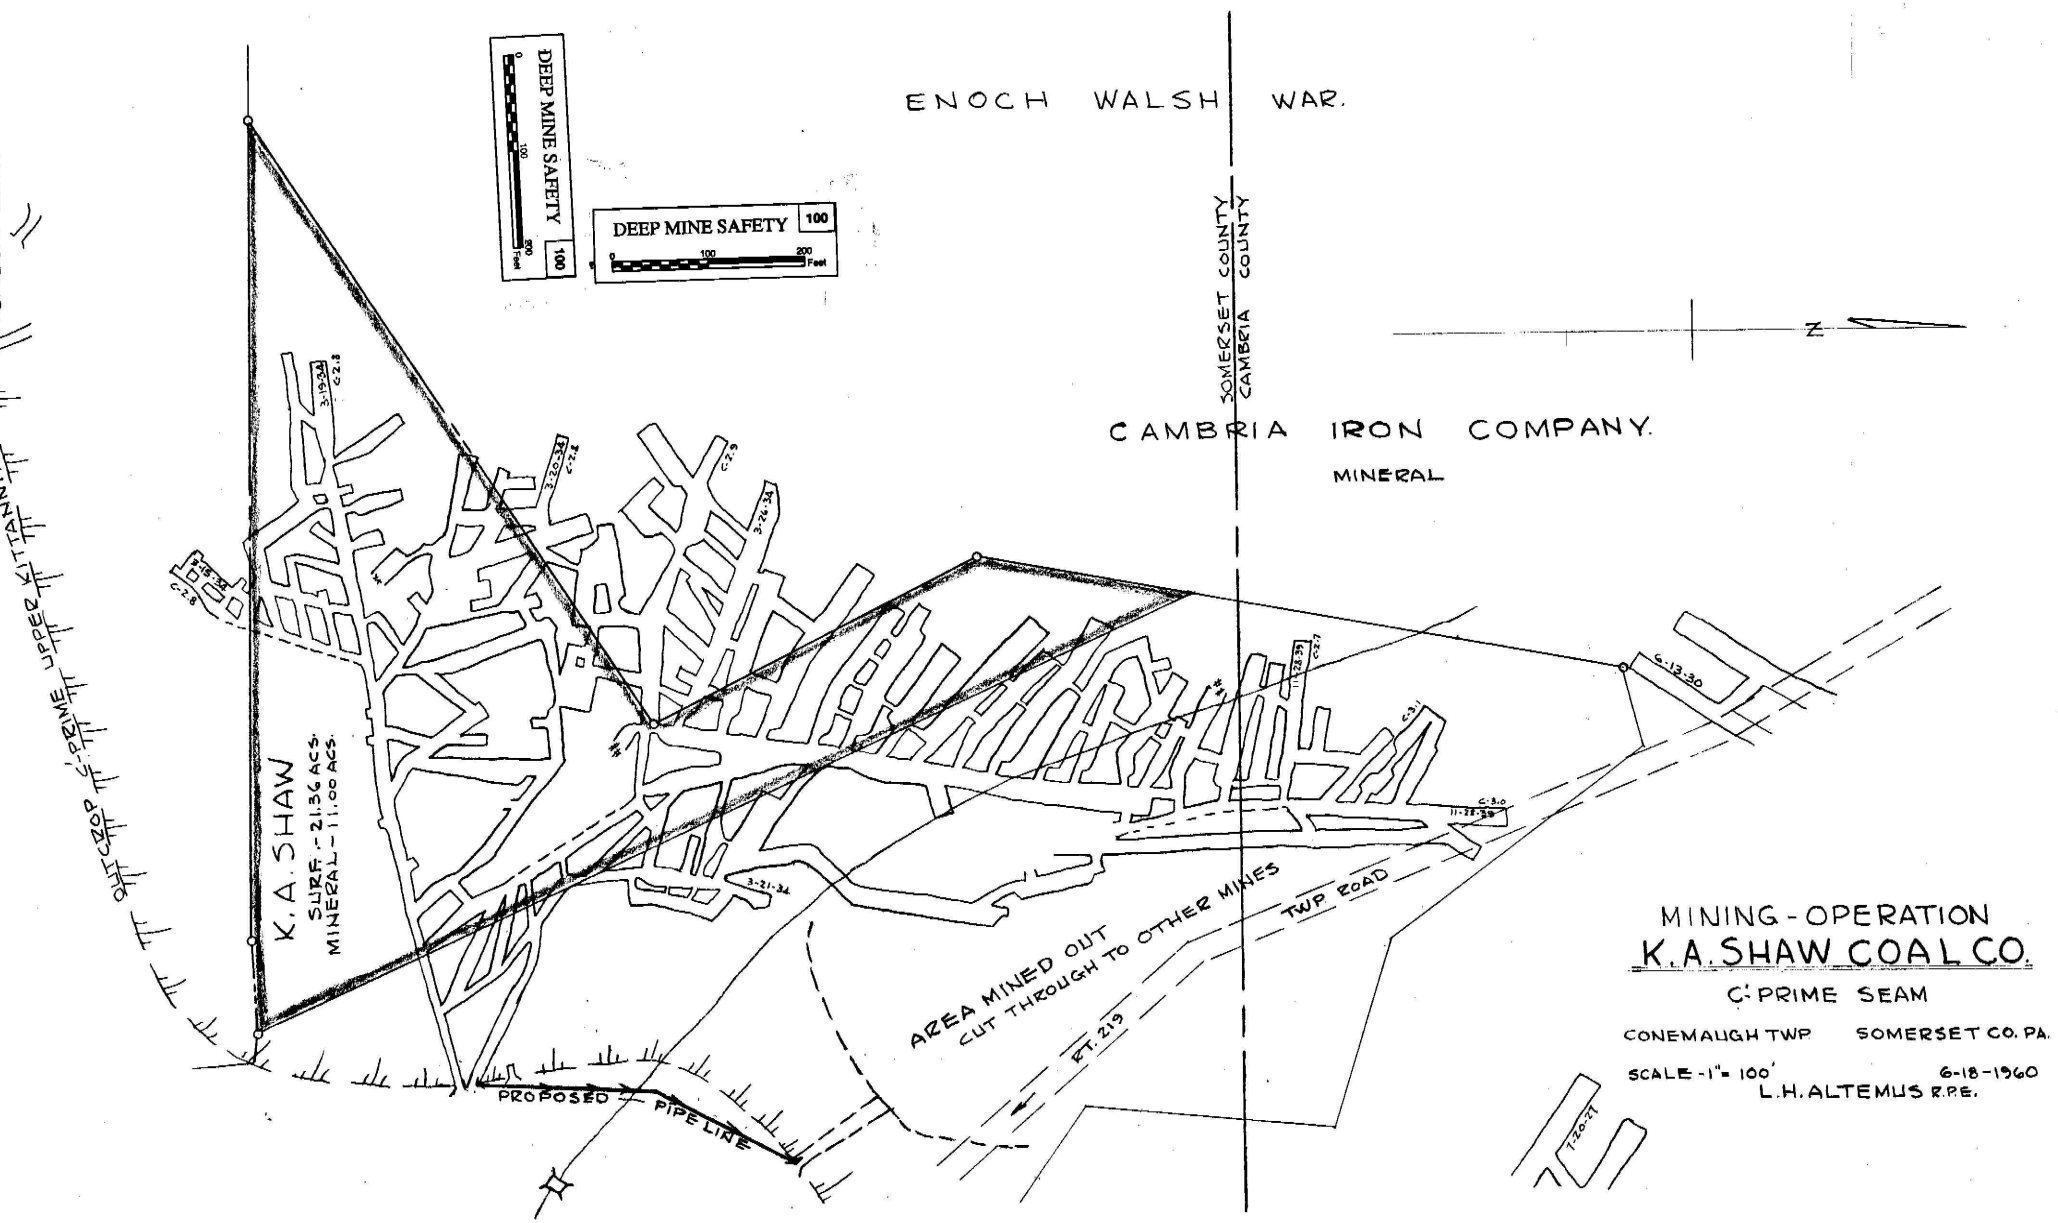
ENOCH WALSH WAR.
CAMBRIA IRON COMPANY.
MINERAL
SOMERSET COUNTY
CAMBRIA COUNTY
DEEP MINE SAFETY 100
DEEP MINE SAFETY 100
0 100 200 Feet
N
CABLE MINE
OUTCROP C-PRIME UPPER KITTANNING SEAM
K.A. SHAW
SURF. - 21.36 ACS.
MINERAL - 11.00 ACS.
3-19-34
C-2.8
3-20-34
C-2.4
C-2.9
3-26-34
C-2.8
11-28-33
C-2.7
C-3.1
C-3.0
11-28-33
6-13-30
3-21-34
AREA MINED OUT
CUT THROUGH TO OTHER MINES
TWP ROAD
FT. 219
PROPOSED PIPE LINE
7-20-21
MINING - OPERATION
K.A. SHAW COAL CO.
C-PRIME SEAM
CONEMAUGH TWP SOMERSET CO. PA.
SCALE - 1" = 100'
6-18-1960
L.H. ALTEMUS R.P.E.

MAB-202