

6-11-99
C.C.

BLACK BEAUTY No. 1 MINE

SITUATED IN
YOUNG TWP., INDIANA CO., PA.

OPERATED BY
WALTER HIEKARSKI - WATERMAN, PA.

SURVEYED - 1ST 5, 1968 BY H.P.A.

SCALE: 1" = 100'

REVISED 7-2-67
9-26-66
3-18-67



- Coal Area
- Workings - Next 6 Months
- Mined out
- No Drawings
- Date Oct. 10, 1967 to April 12, 1968



To 4th

OLD WORKS OF LEBANON FUEL CO.

RESERVE

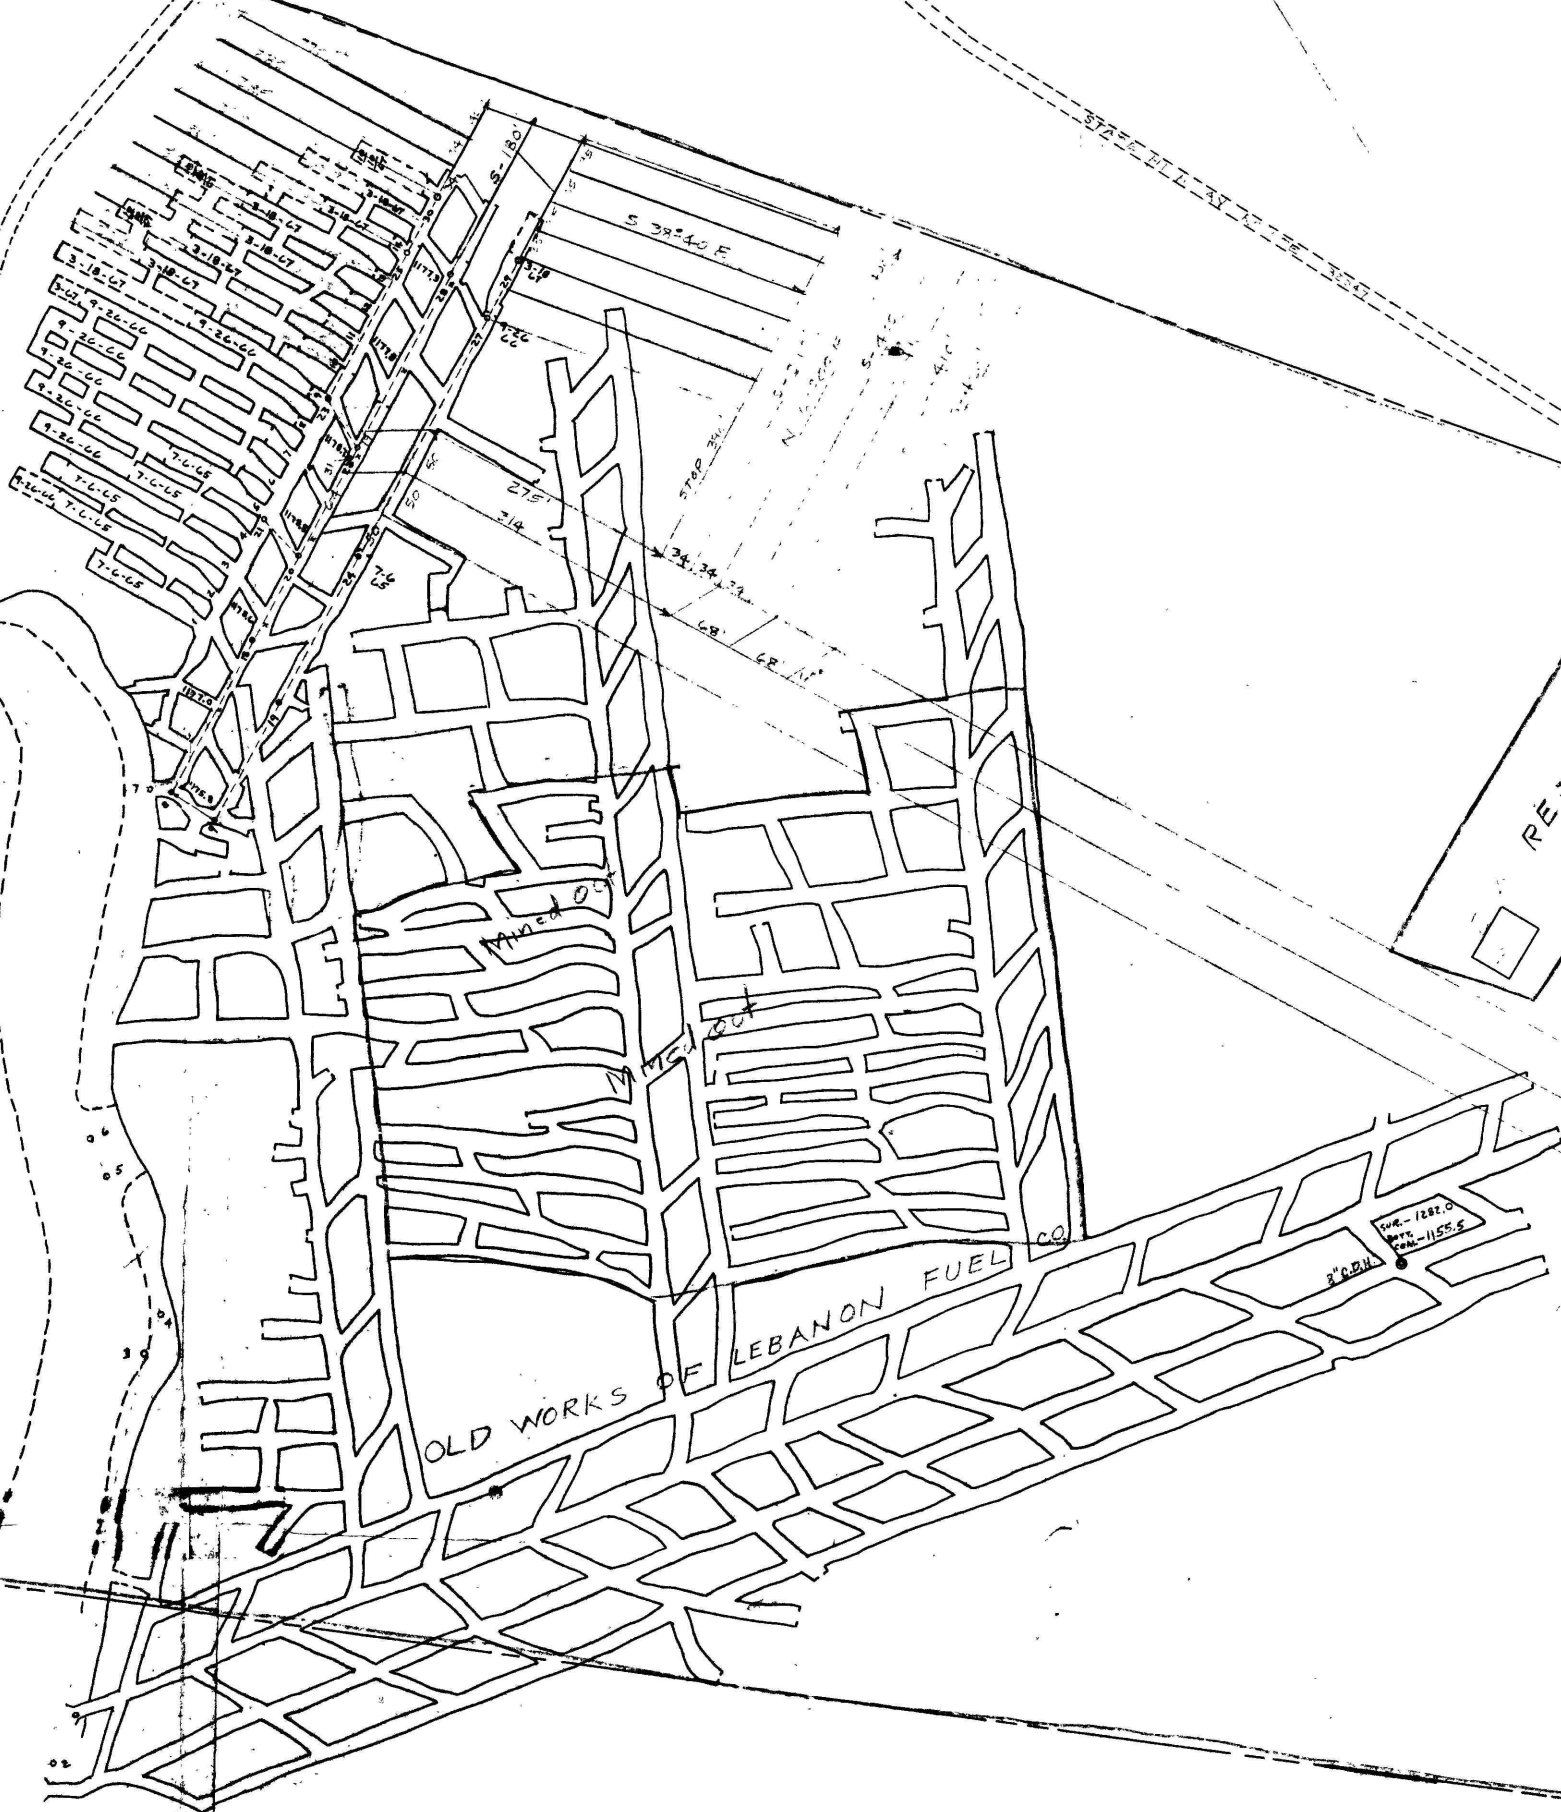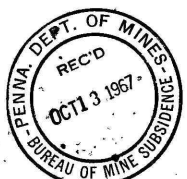

TOWNSHIP ROAD No. 356

To RT. 56