


Matthew Shedeck's
Mine Near
Karthaus Pa

scale = 1" = 100 ft
I M Kelley

Property of
Mosquito Creek Coal Co.

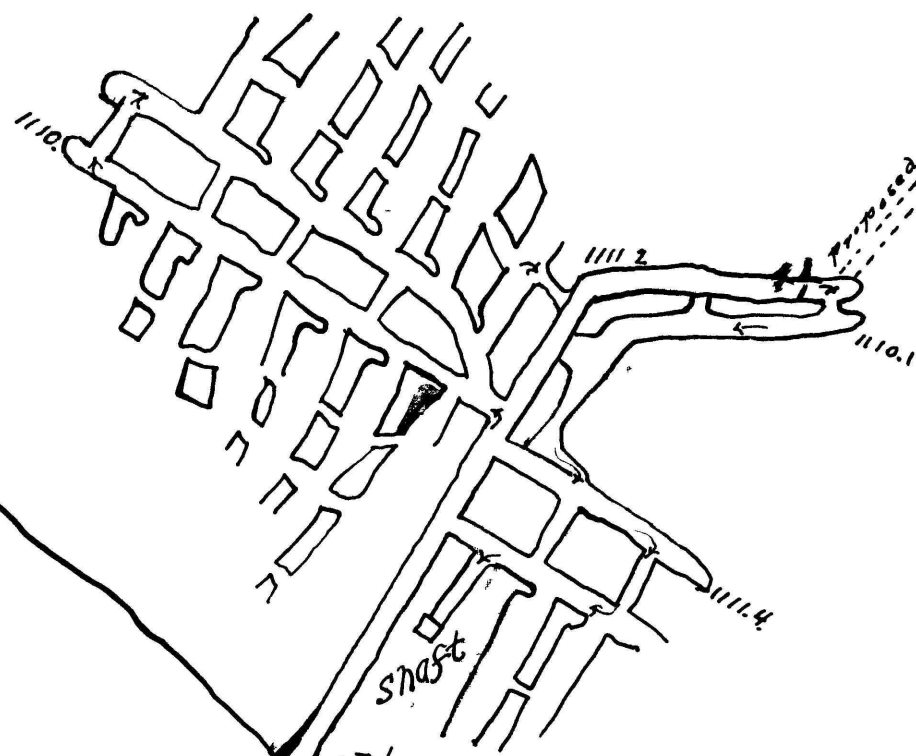

Surveyed 5/5/06

SS

1112.1 No 7 Mosquito Creek
out crop