


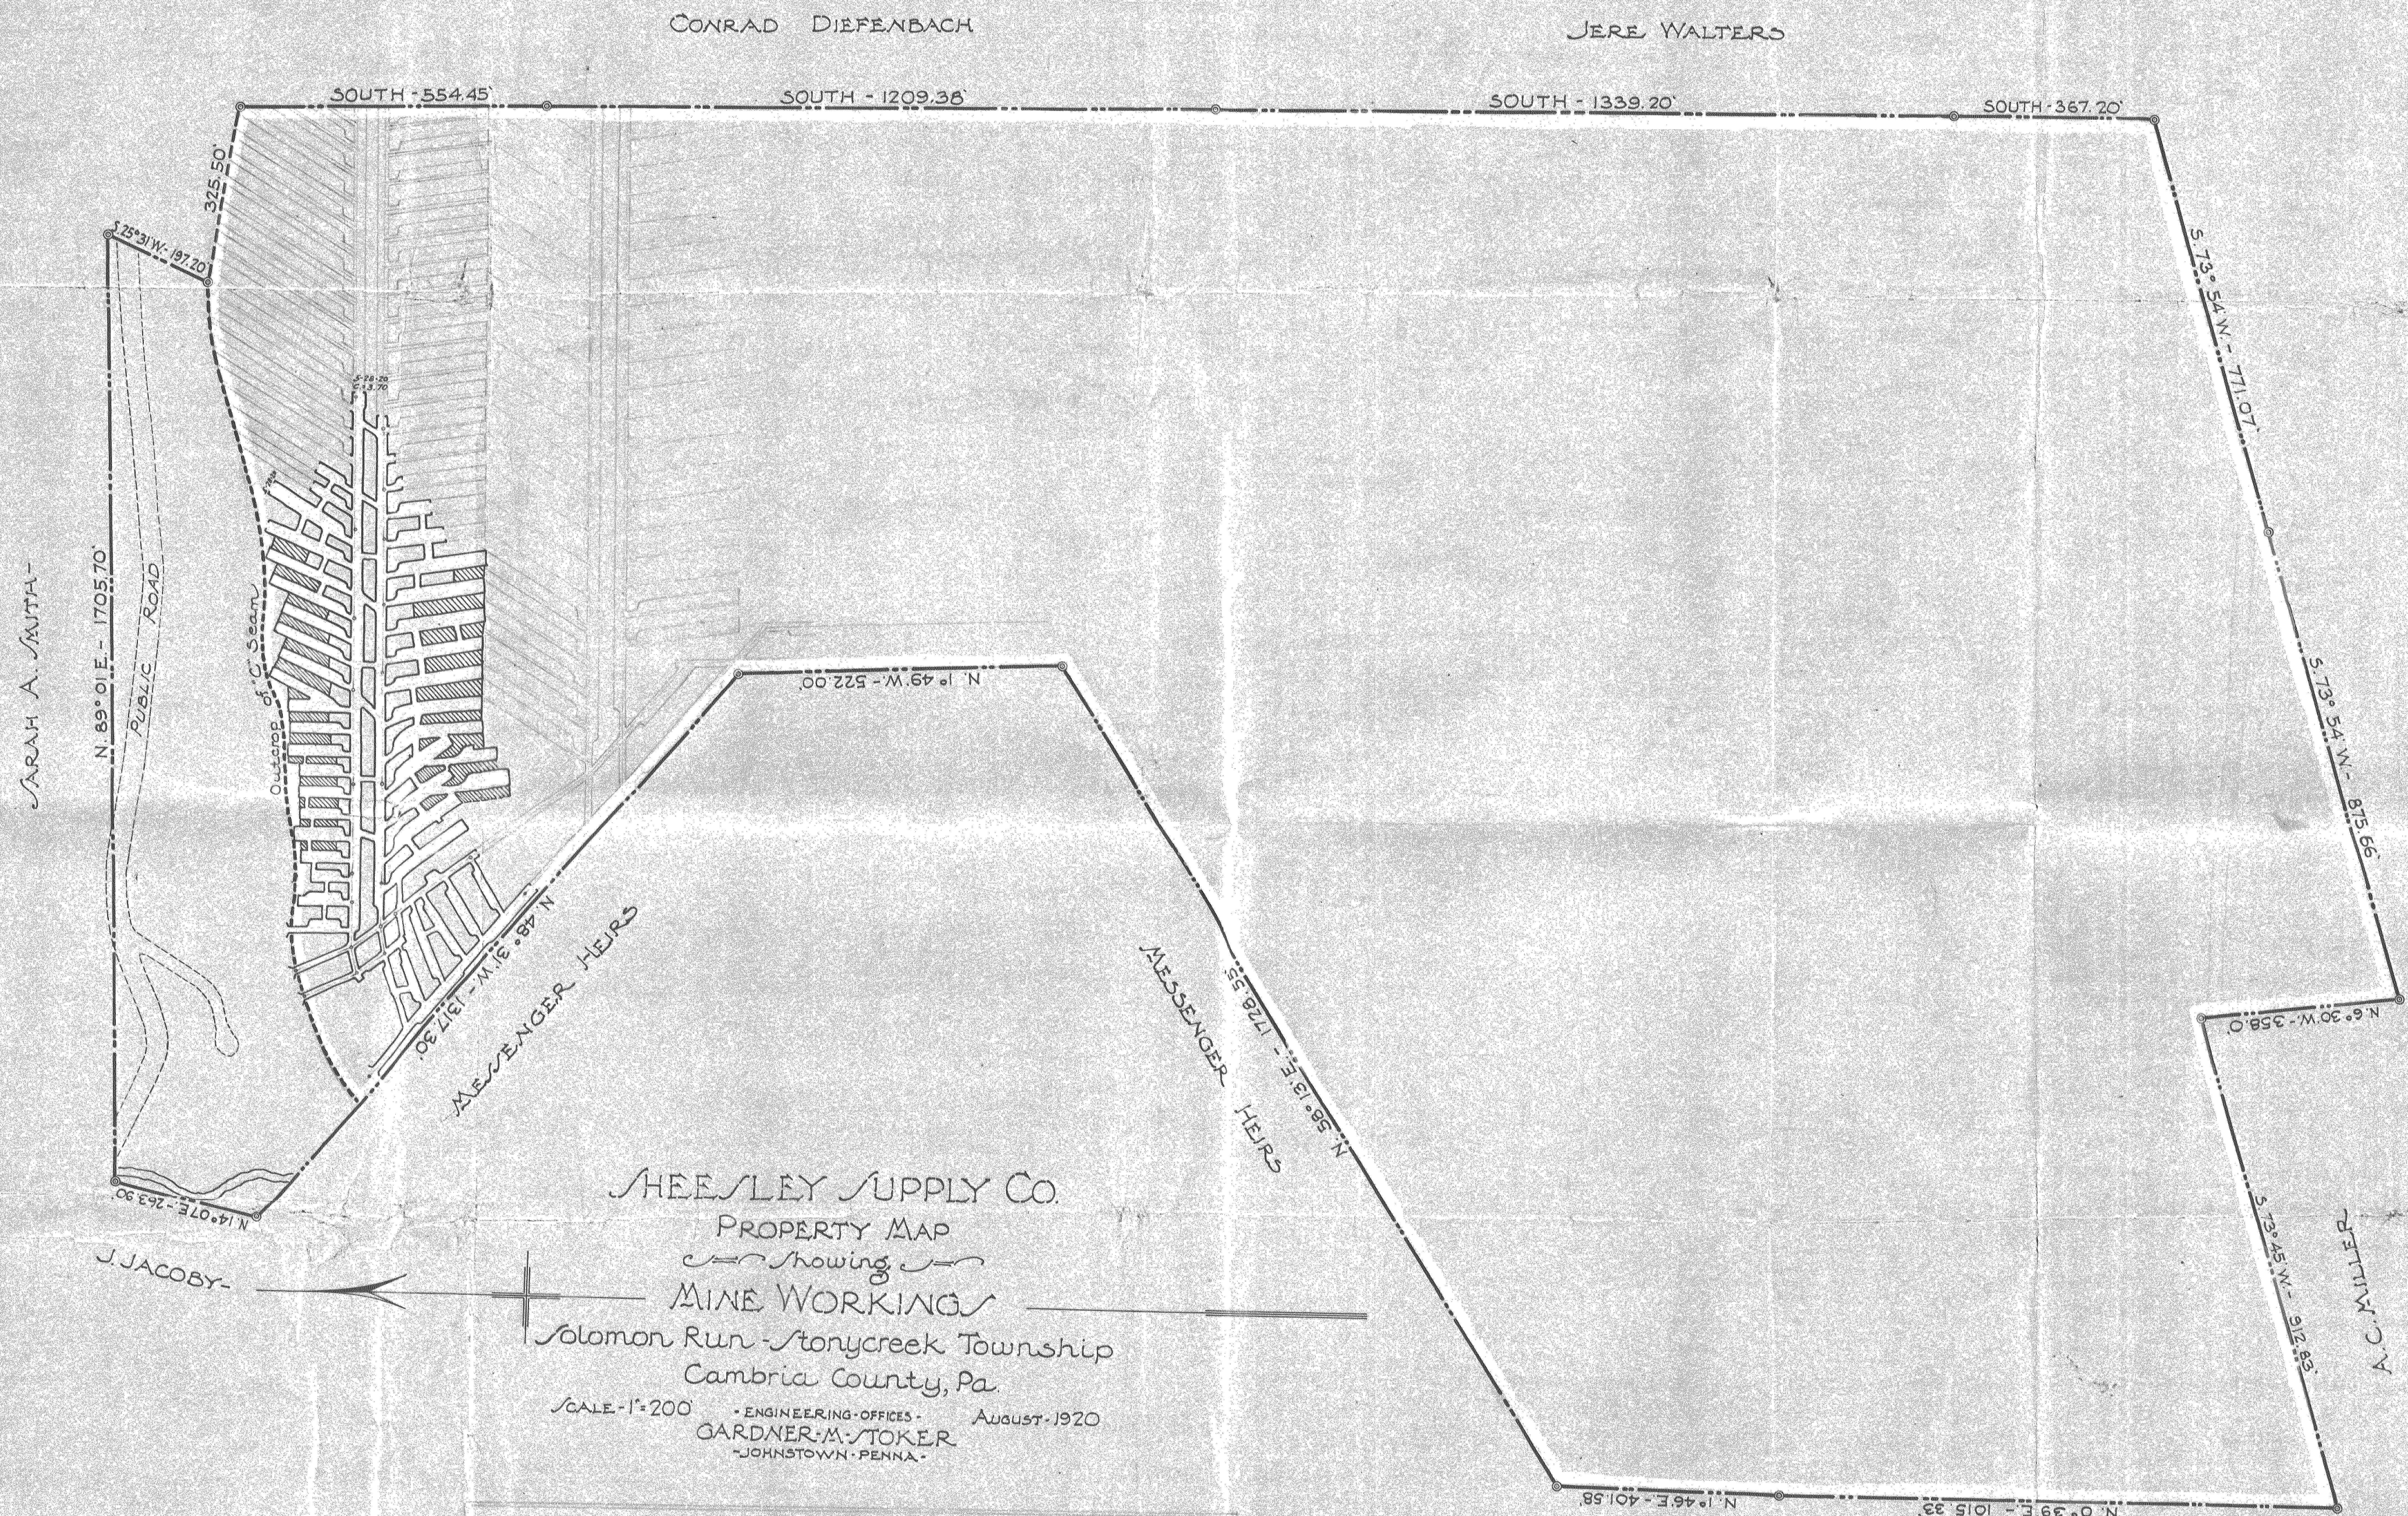

SHEESLEY SUPPLY CO.
 PROPERTY MAP
 Showing
 MINE WORKINGS
 Solomon Run - Stonycreek Township
 Cambria County, Pa.
 SCALE - 1" = 200' • ENGINEERING OFFICES • AUGUST - 1920
 GARDNER & STOKER
 JOHNSTOWN - PENNA.

LEGEND	
Total Area of C Seam Coal = 154,463 Ac. ±	
Area Mined to May 28th, 1920 = 3,500 Ac. ±	
Area of C Seam Coal Remaining = 148,963 Ac. ±	
Average Thickness of C Seam Coal in Jams = 3' - 6"	