


SARAH A. SMITH-

N. 89° 01' E. - 1705.70'

PUBLIC ROAD

J. JACOBY-

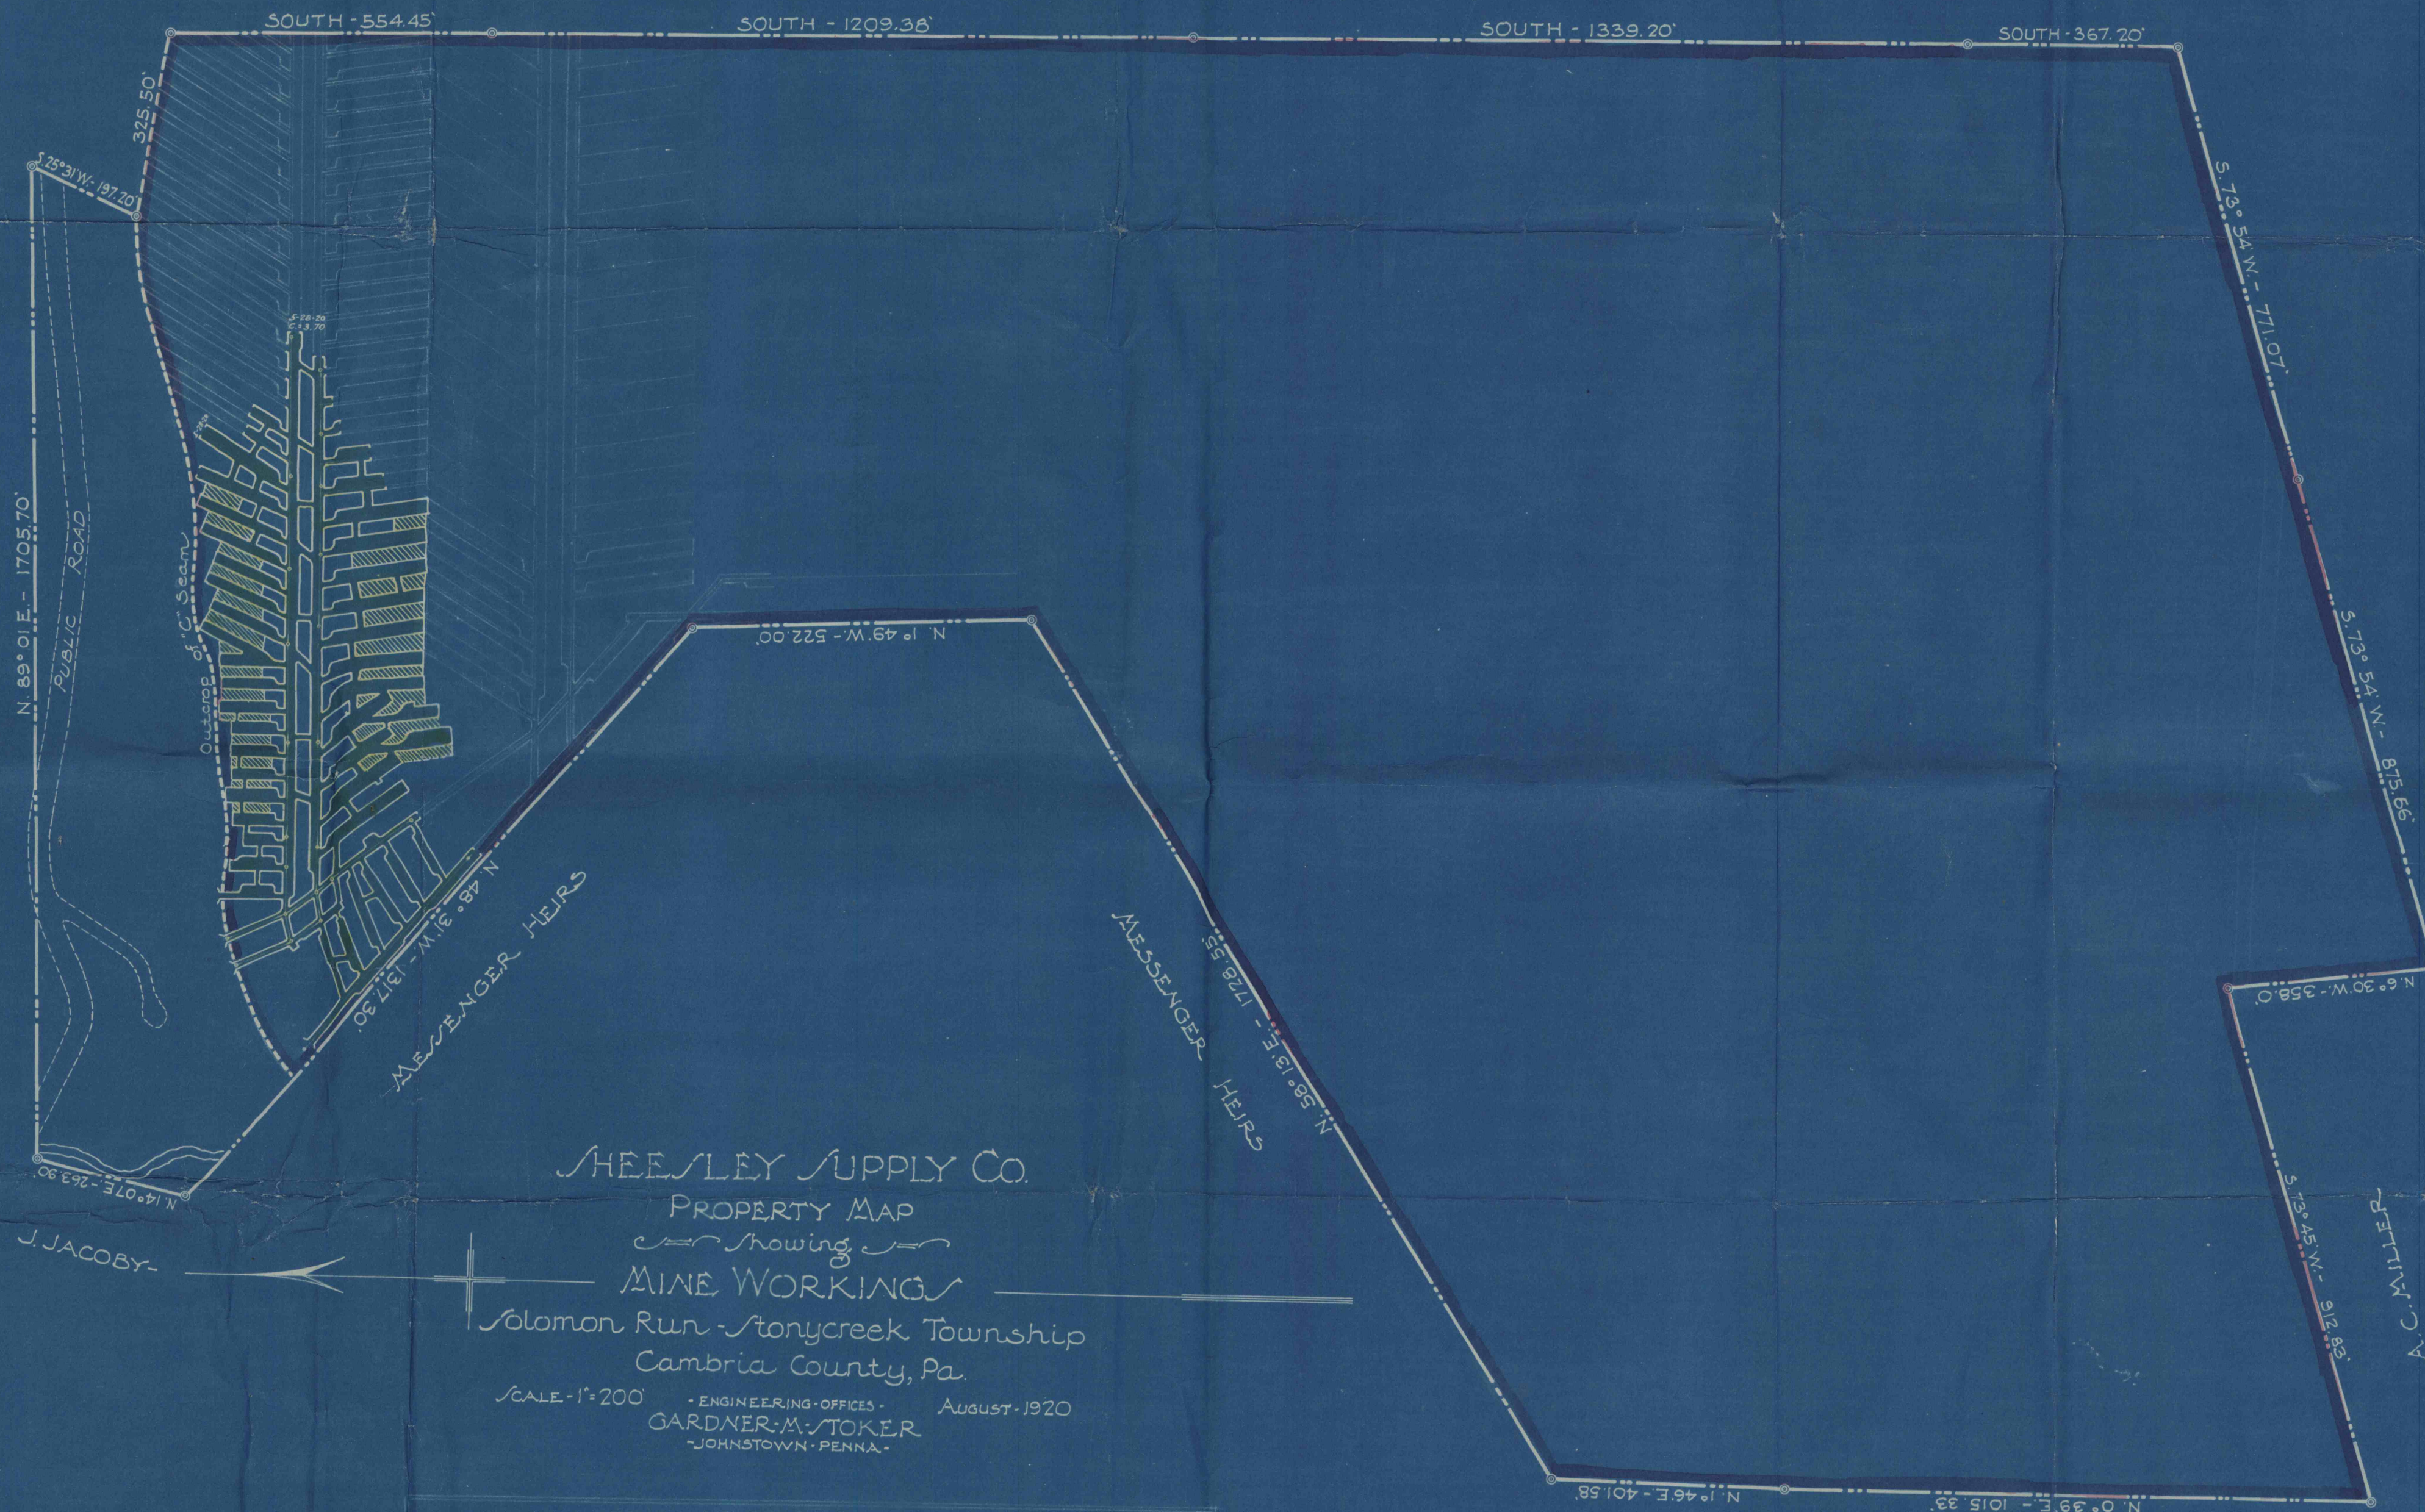

SHEESLEY SUPPLY CO.

PROPERTY MAP

Showing

MINE WORKINGS

Solomon Run - Stonycreek Township
Cambria County, Pa.

SCALE - 1" = 200'

ENGINEERING OFFICES
GARDNER M. STOKER
JOHNSTOWN - PENNA.

AUGUST - 1920

LEGEND

Total Area of "C" Seam Coal = 154.463 Acs. - shown

Area Mined out to May 28th 1920 = 5.500 Acs. - shown

Area of "C" Seam Coal Remaining = 148.963 Acs.

Average Thickness of "C" or "M" or "G" Seam = 3'-6"