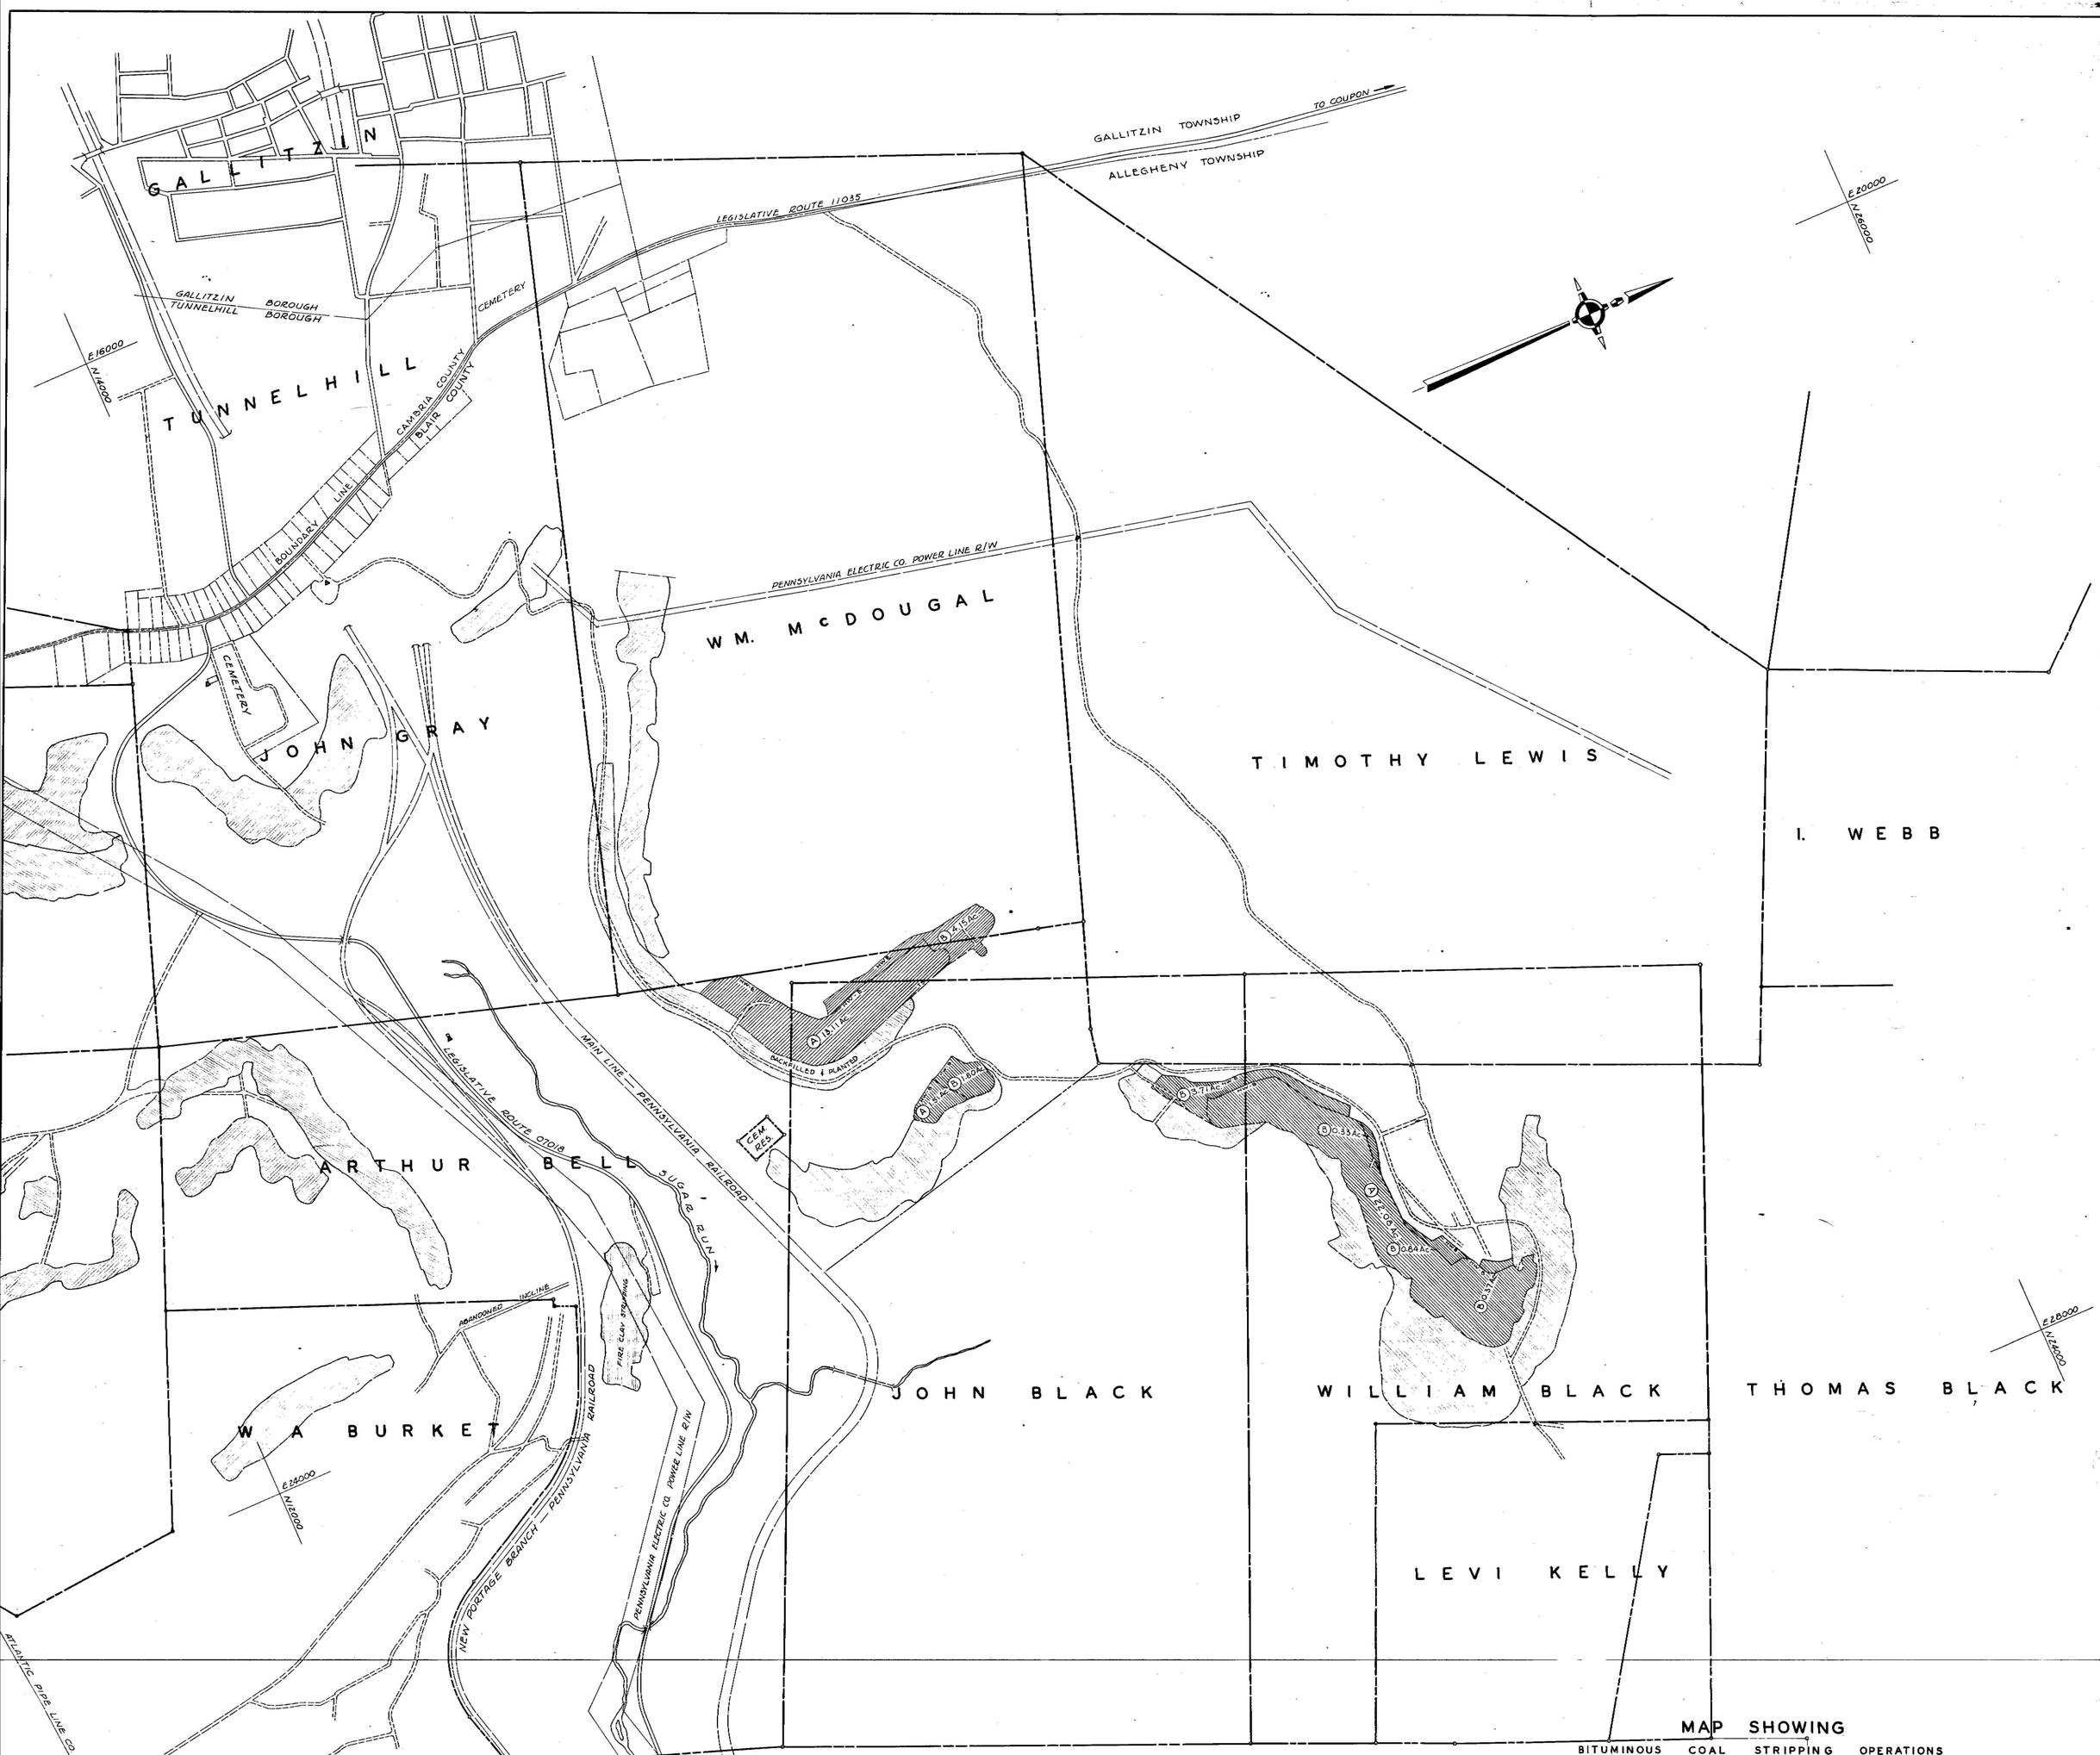

LEGEND

MINING GEOLOGY

- UPPER FREEPORT OR E
- LOWER FREEPORT OR D
- UPPER KITTANNING OR C'
- LOWER KITTANNING OR B
- BROOKVILLE OR A

SURVEY DATE	AFFECTED AREA		BACKFILL AREA		RESIDUAL AREA
	INCREMENT	CUMULATIVE	INCREMENT	CUMULATIVE	
NOV. 6, 1958 A	36.70	36.70	0.00	0.00	36.70
SEPT. 9, 1959 B	11.20	47.90	0.00	0.00	47.90
SEPT. 9, 1959	0.00	47.90	40.88	40.88	7.02
MAY 23, 1960	0.00	47.90	7.02	47.90	0.00

MAP SHOWING

BITUMINOUS COAL STRIPPING OPERATIONS

OF

LAWRENCE SHERBINE

NORTHEAST OF BENNINGTON

SITUATE IN

ALLEGHENY TWP. BLAIR CO., PENNA.

SCALE: 1 IN. = 400 FT.

LEWIS L. GWIN — CONSULTING ENGINEERS
JOHN W. FOREMAN, MINING ENGINEER
ALTOONA, PENNSYLVANIA

COMMONWEALTH OF PENNSYLVANIA
REGISTERED PROFESSIONAL ENGINEER
JOHN W. FOREMAN
No. 5
LICENSE
1966

John W. Foreman