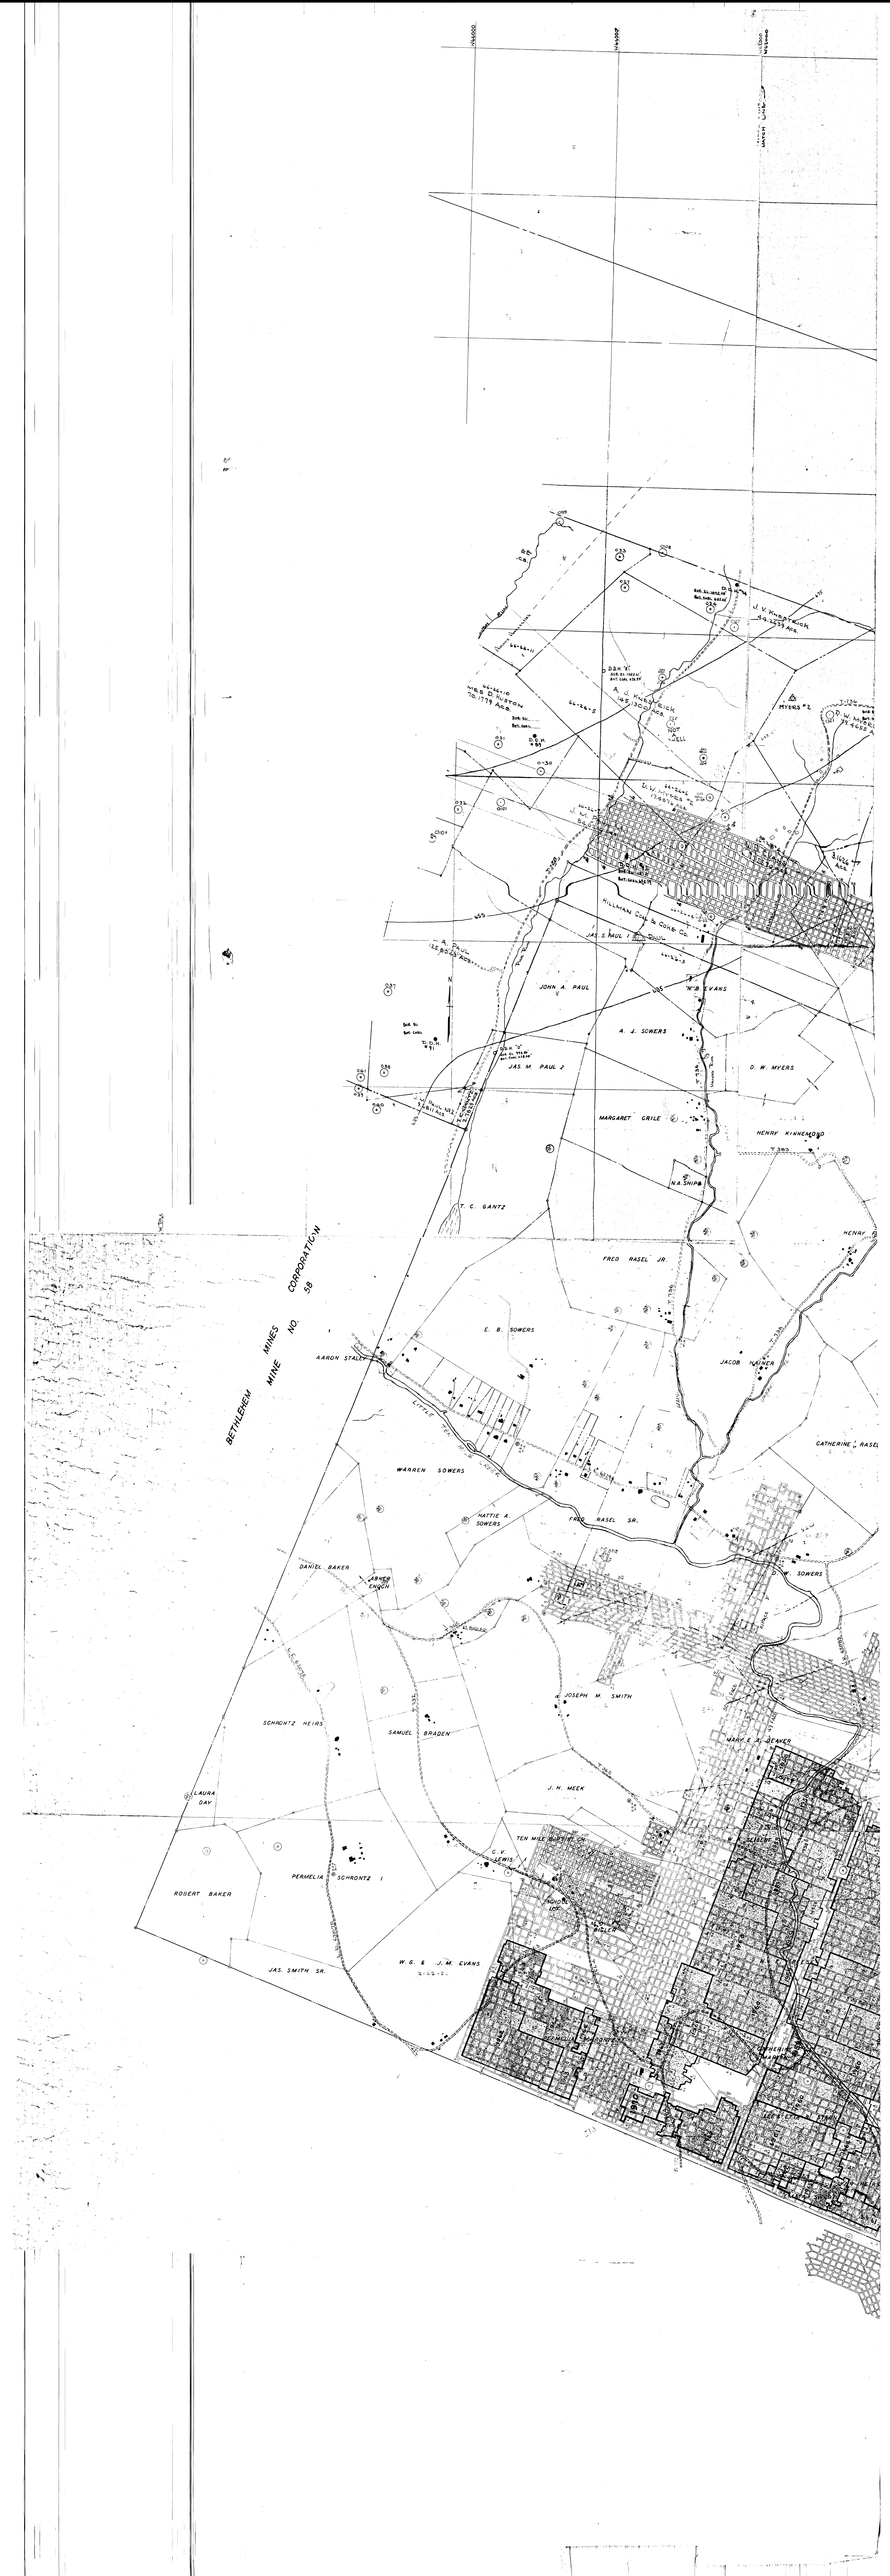

W66000
W64000
W62000
W62000
MATCH LINE
J. V. KNESTRICK
44.2639 Acs.
675
D.D.H. #94
SUR. EL. 1092.60
BOT. COAL 682.62
034
021
033
0108
0107
099
EE
CB.
AMITY ANTICLINE
RUN
66-26-11
66-26-10
MRS D. HUSTON
70.1179 Acs.
D.D.H. #89
031
0-30
66-26-5
A. J. KNESTRICK
145.1300 Acs.
NOT A WELL
025
GAS WELL 024
D.D.H. "E"
SUR. EL. 1062.61
BOT. COAL 675.14
MYERS #2
D. W. MYERS
79.4655 Acs.
021
T-136
L. W. MYERS #2
19.4816 Acs.
GAS WELL 0-28
66-26-6
J. M. P.
84.02
66-26-7
D.D.H. #92
SUR. EL. 1131.71
BOT. COAL 682.79
3.1626 Acs.
010+
032
1010
GAS WELL 0-22
HILLMAN COAL & COKE CO.
JAS. S. PAUL 1 PAUL
66-26-3
655
T-128
PINE RUN
A. PAUL
125.8043 Acs.
JOHN A. PAUL
N. B. EVANS
A. J. SOWERS
D. W. MYERS
037
D.D.H. #91
SUR. EL.
BOT. COAL
D.D.H. "D"
SUR. EL. 998.80
BOT. COAL 628.08
JAS. M. PAUL 2
HAINES RUN
T 736
038
041
039
040
J. M. PAUL No. 2
9.811 Acs.
T. C. GANTZ
2.7829 Acs.
635
MARGARET CRILE
HENRY KINNEMOND
T 383
N. A. SHIPP
T. C. GANTZ
FRED RASEL JR.
HENRY
T 736
E. B. SOWERS
JACOB HAINER
T 738
AARON STALEY
BETHLEHEM MINES CORPORATION
MINE NO. 58
W 70+c
LITTLE TEN MILE CREEK
WARREN SOWERS
HATTIE A. SOWERS
FRED RASEL SR.
L.E. 62194
CATHERINE RASEL
D. W. SOWERS
51 FACE
50 FACE
49 FACE
L.E. 62089
DANIEL BAKER
ABNER ENOCH
P. BIGLER
T 365
JOSEPH M. SMITH
MARY E. A. DEAVER
SCHRONTZ HEIRS
L.E. 62075
SAMUEL BRADEN
T 732
J. H. MEEK
LAURA DAY
TEN MILE BAPTIST CH.
C. V. LEWIS
SCHOOL LOT
M. D. BIGLER
ROBERT BAKER
PERMELIA SCHRONTZ 1
JAS. SMITH SR.
W. G. & J. M. EVANS
4-26-2
PERMELIA SCHRONTZ
W. R. SEIBERT
N. E. REESE
CATHERINE MARTIN
LEE & ETTA B. STERN
T 59
T 732
T 365
1958
1959
1960
1961
1962
1963