


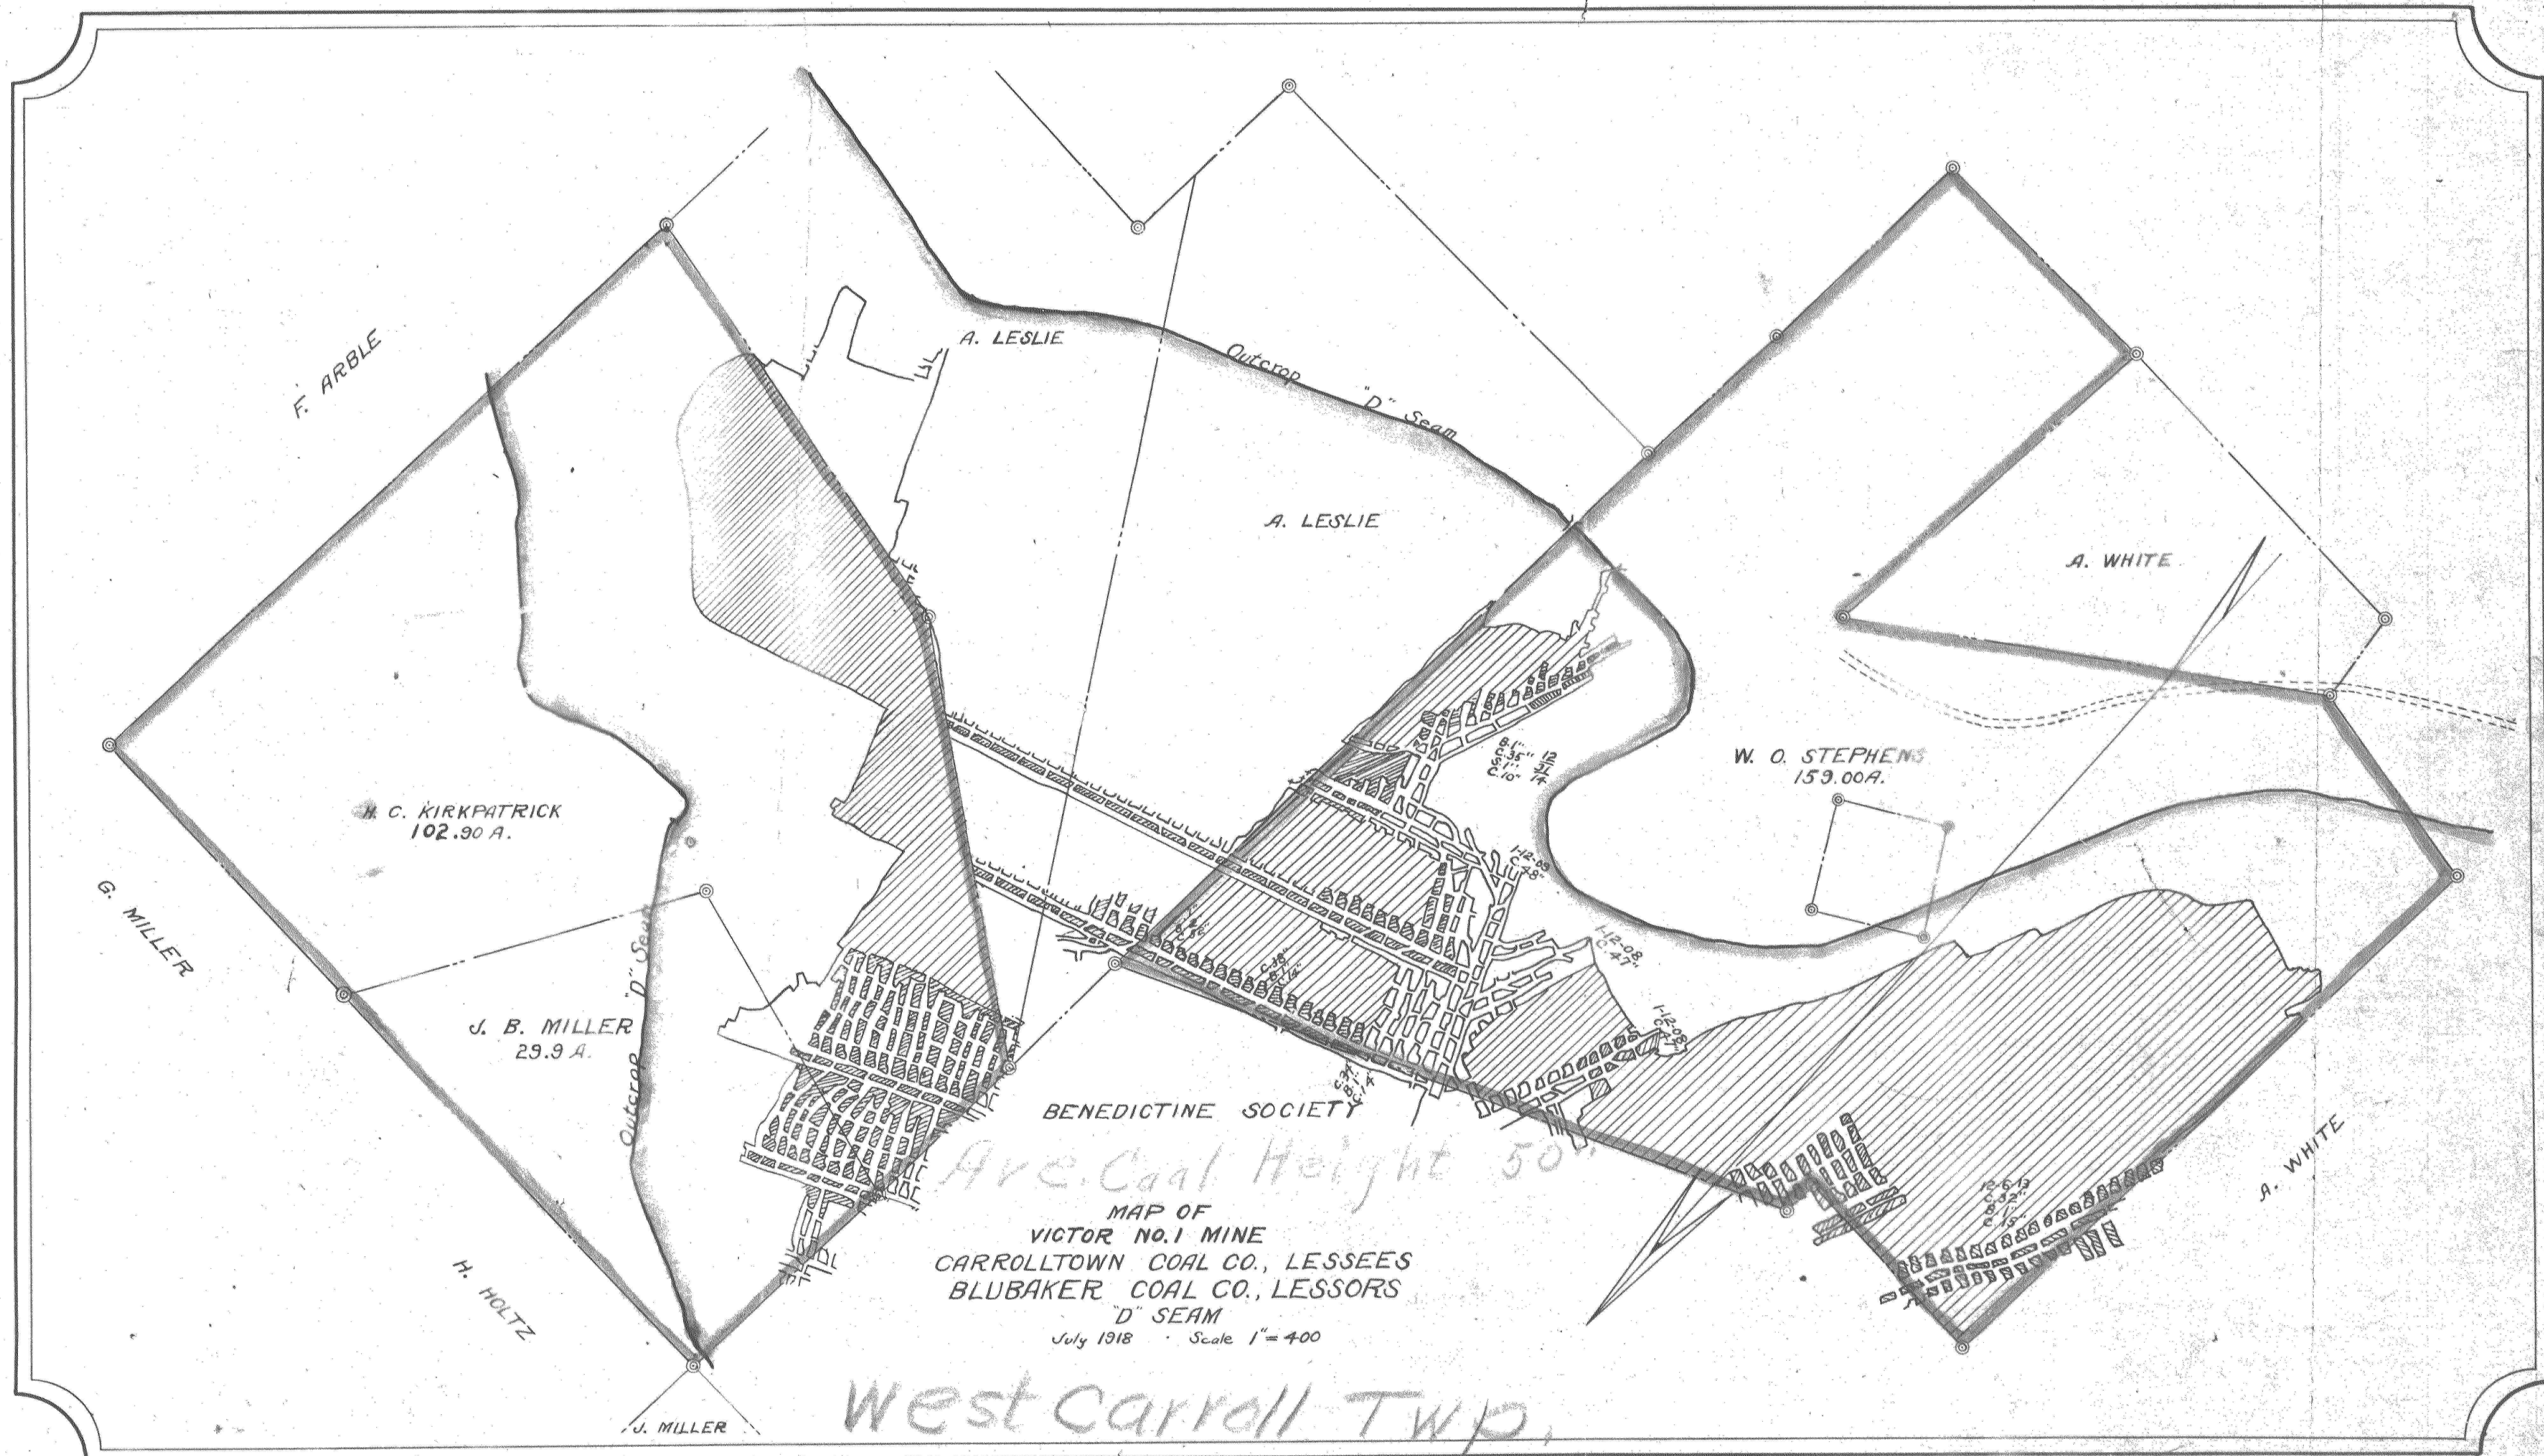

BENEDICTINE SOCIETY
Ave. Coal Height 50
MAP OF
VICTOR NO. 1 MINE
CARROLLTOWN COAL CO., LESSEES
BLUBAKER COAL CO., LESSORS
"D" SEAM
July 1918 Scale 1" = 400

West Carroll Twp.
Cambria Co. Pa.